


PLAN  
 DRAWN BY  
 CHECKED BY  
 DATE  
 NO.

PROFILE  
 DRAWN BY  
 CHECKED BY  
 DATE  
 NO.

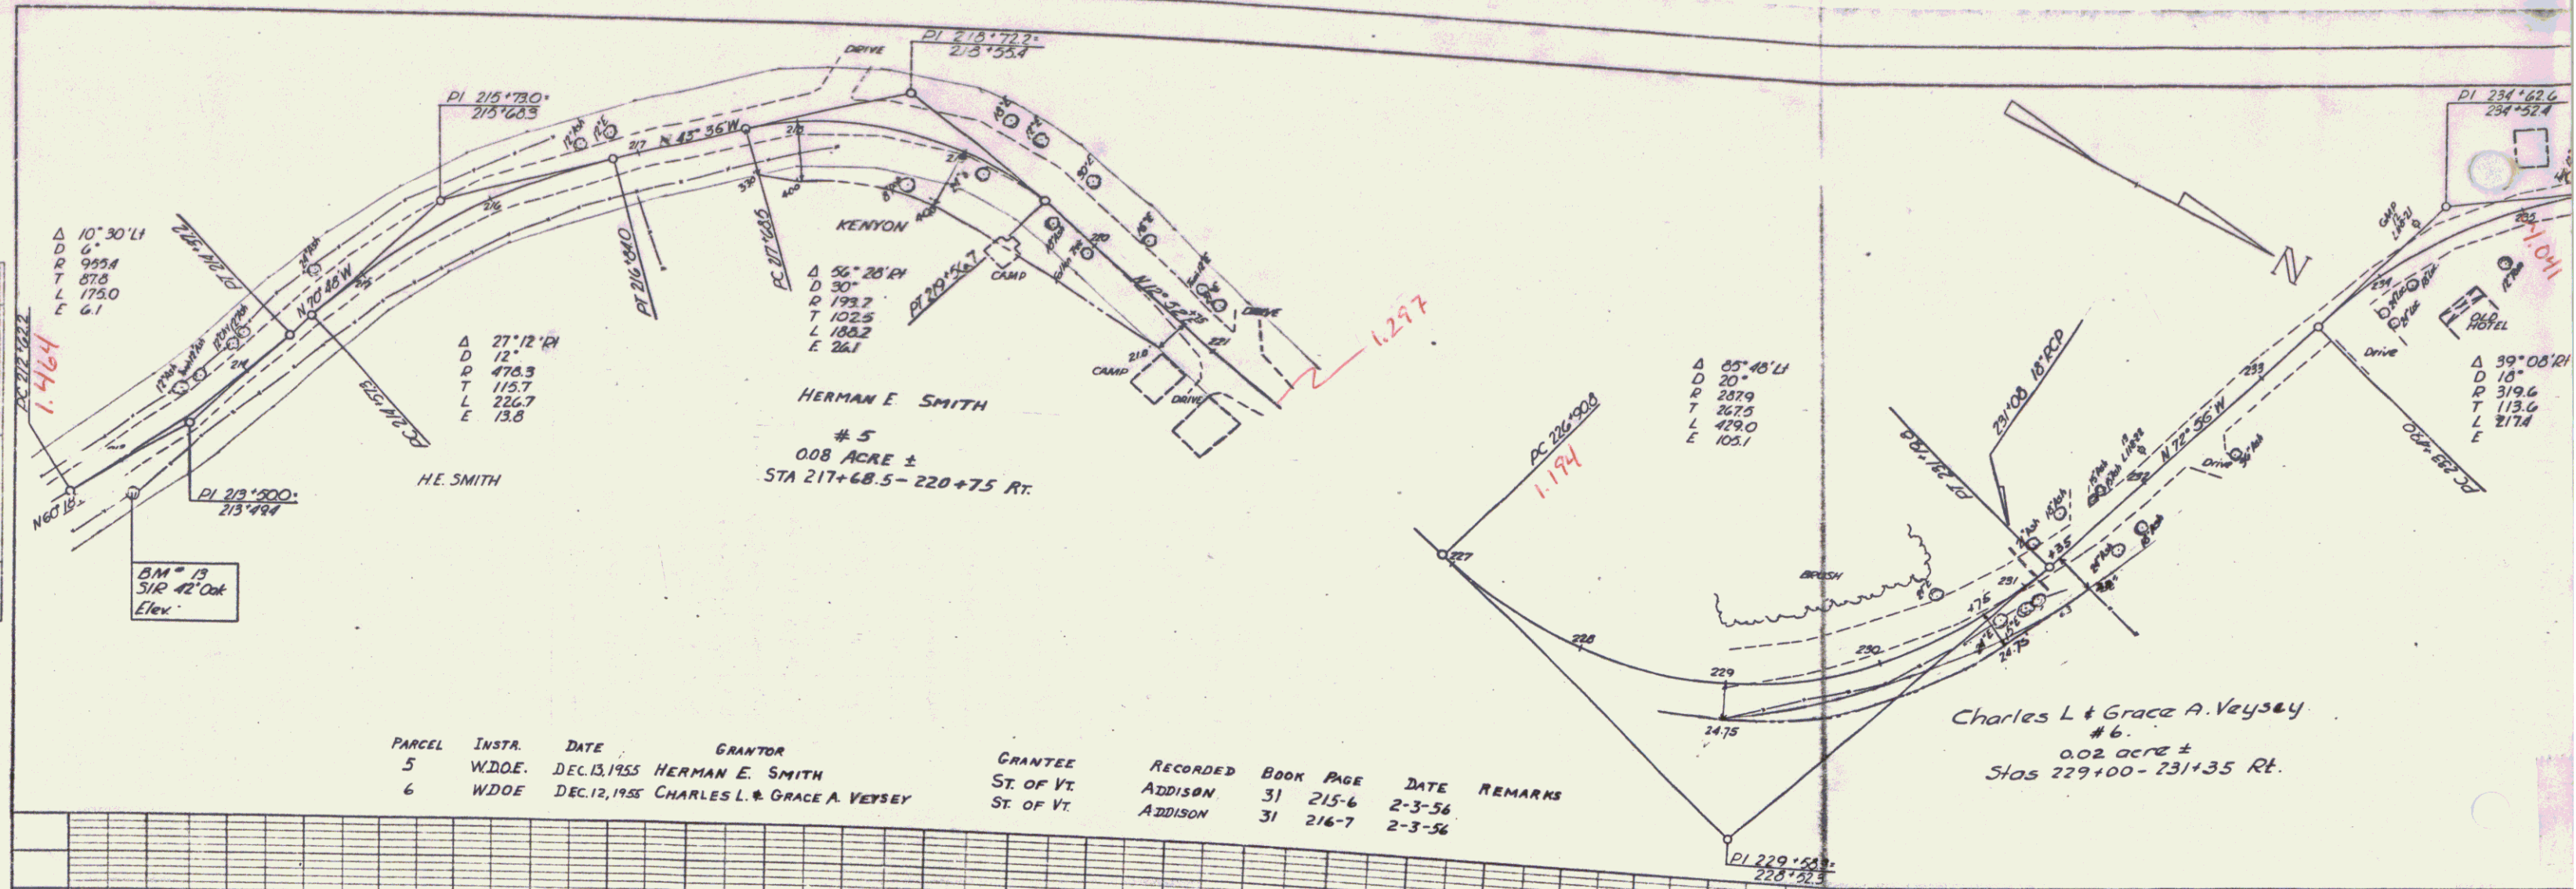

PARCEL	INSTA.	DATE	GRANTOR	GRANTEE	RECORDED	BOOK	PAGE	DATE	REMARKS
5	W.D.O.E.	DEC. 13, 1955	HERMAN E. SMITH	ST. OF VT.	ADDISON	31	215-6	2-3-56	
6	W.D.O.E.	DEC. 12, 1955	CHARLES L. & GRACE A. VEYSEY	ST. OF VT.	ADDISON	31	216-7	2-3-56	

PLATE 1-PLAN-PROFILE © P.A.A. & S. BINGHAM  
 PLANNING & ENGINEERING, NEW YORK  
 P.O. BOX 100, NEW YORK, N.Y. 10001  
 MADE IN U.S.A.

BRIDPORT-ADDISON  
 ST. 69 (L)  
 SHEET 5