


PLAN
 DATE: 8-2-52
 DRAWN BY: [Signature]
 CHECKED BY: [Signature]
 TITLE: [Illegible]



PROFILE
 DATE: 8-2-52
 DRAWN BY: [Signature]
 CHECKED BY: [Signature]
 TITLE: [Illegible]

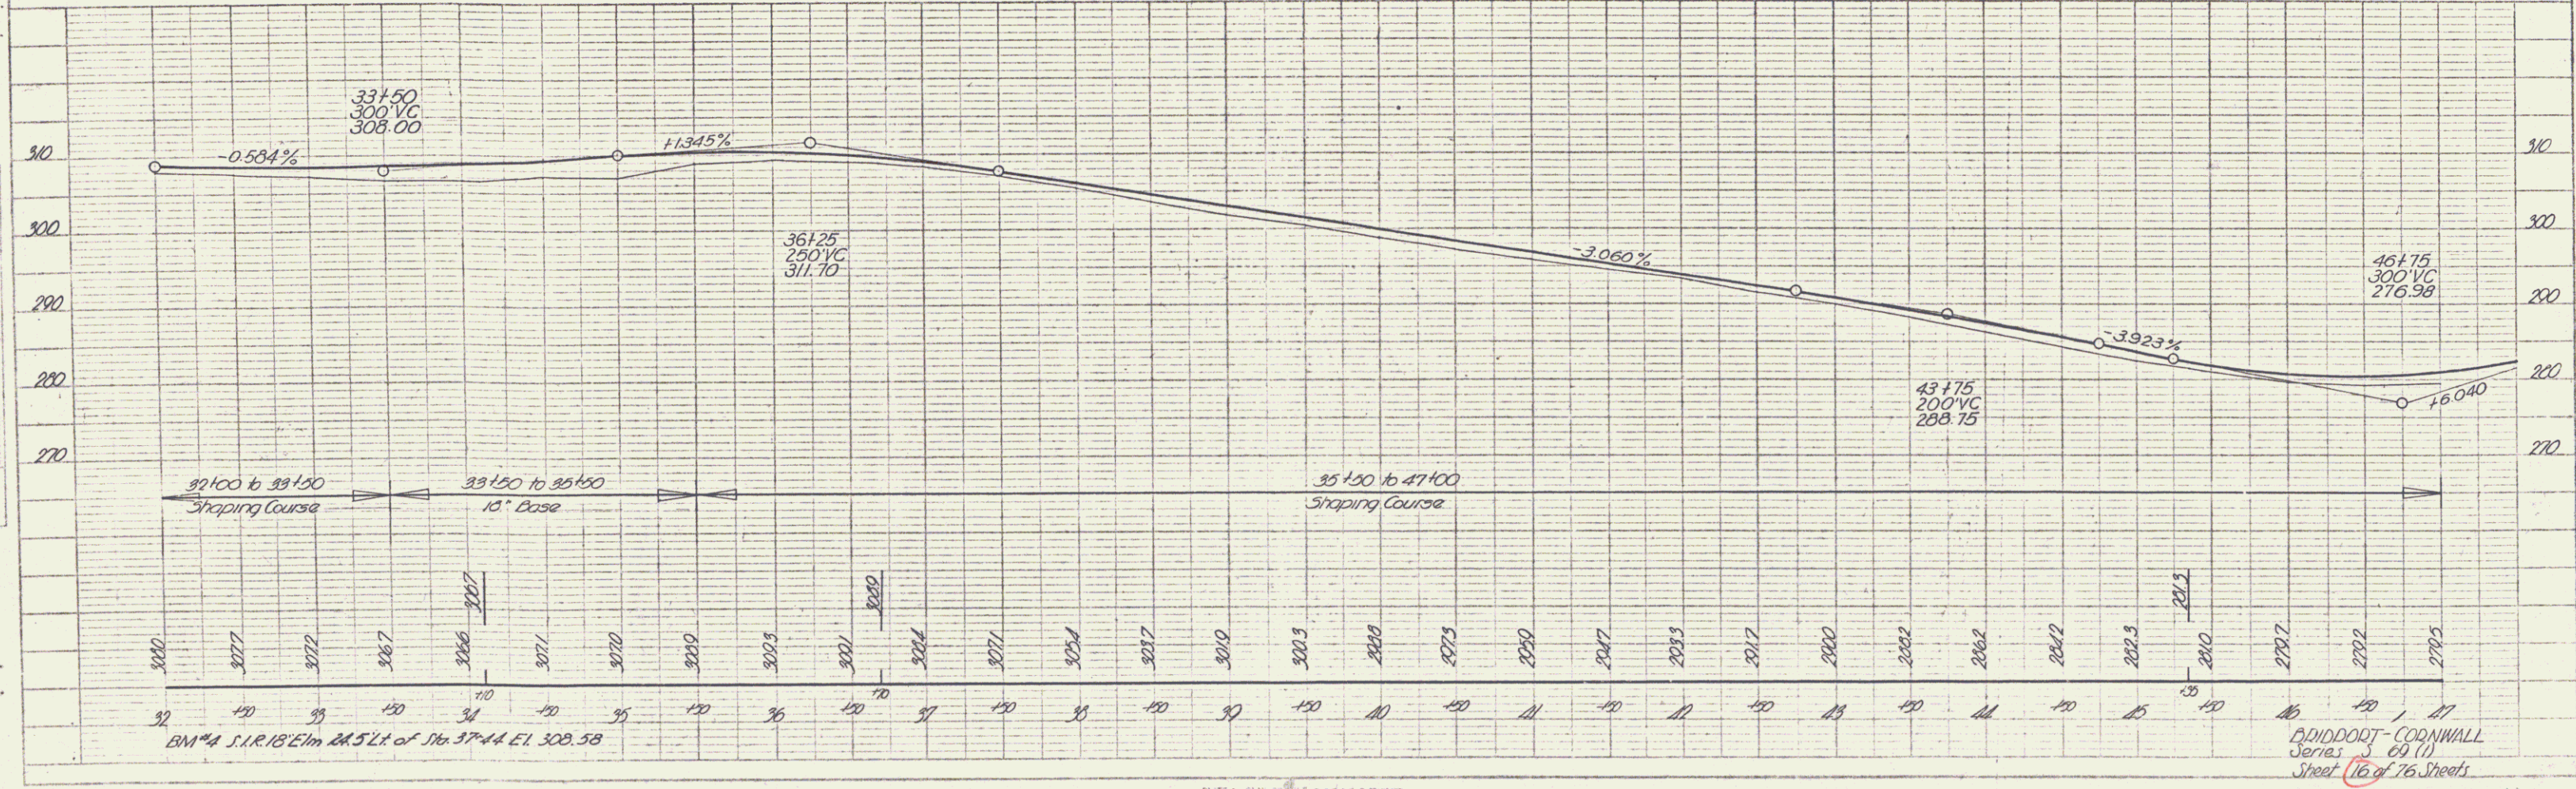

CONSTRUCT DRIVES
 LT 41+50 ✓
 RT 36+70 ✓
 45+138 ✓