


CONSTRUCT DRIVES	DRIVE CONSTRUCTED
47	RF
50+43	49+50
51+70	50+70
54+28	55+23
54+38	54+35

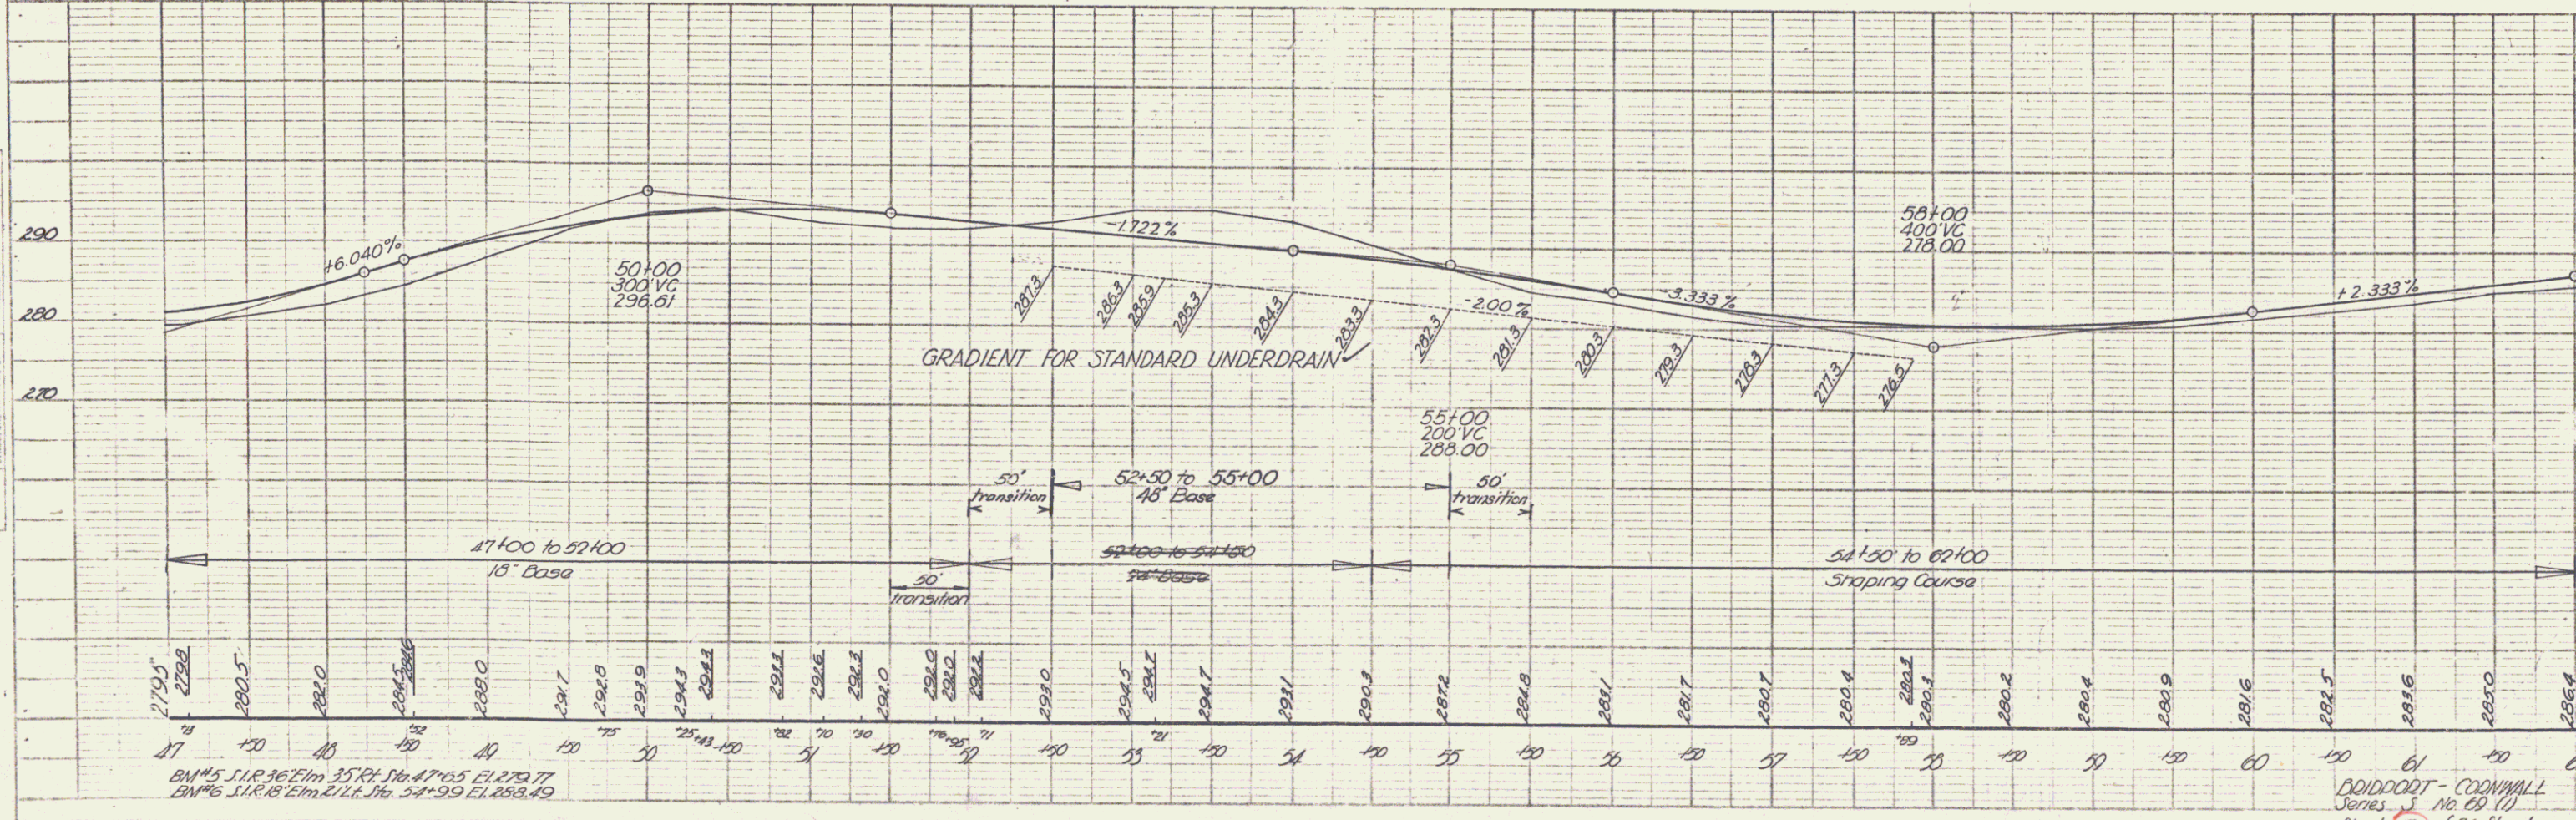

PLAN  
SCALE: AS SHOWN  
DATE: 11/15/54  
BY: J. W. B. (S)

PROFILE  
SCALE: AS SHOWN  
DATE: 11/15/54  
BY: J. W. B. (S)