


CONSTRUCT APPROACHES
 LT 64+50
 RT 63+00

DRIVES CONSTRUCTED
 67+55 Rt
 71+43 Rt

| PARCEL | INSTRUMENT | DATE | GRANTOR | GRANTEE | RECORDED | REMARKS |
|-------------------|-------------|----------|-------------------|------------|----------------------|---------------|
| 3 A, B, C, & D-SH | W. D. O. E. | 10-29-48 | HARLOW N. & IRENE | ST. OF VT. | BOOK 20 PAGE 771-772 | DATE 11-17-48 |
| 5 A | W. D. O. E. | 10-29-48 | HARLOW N. & IRENE | ST. OF VT. | BOOK 20 PAGE 771-772 | DATE 11-17-48 |

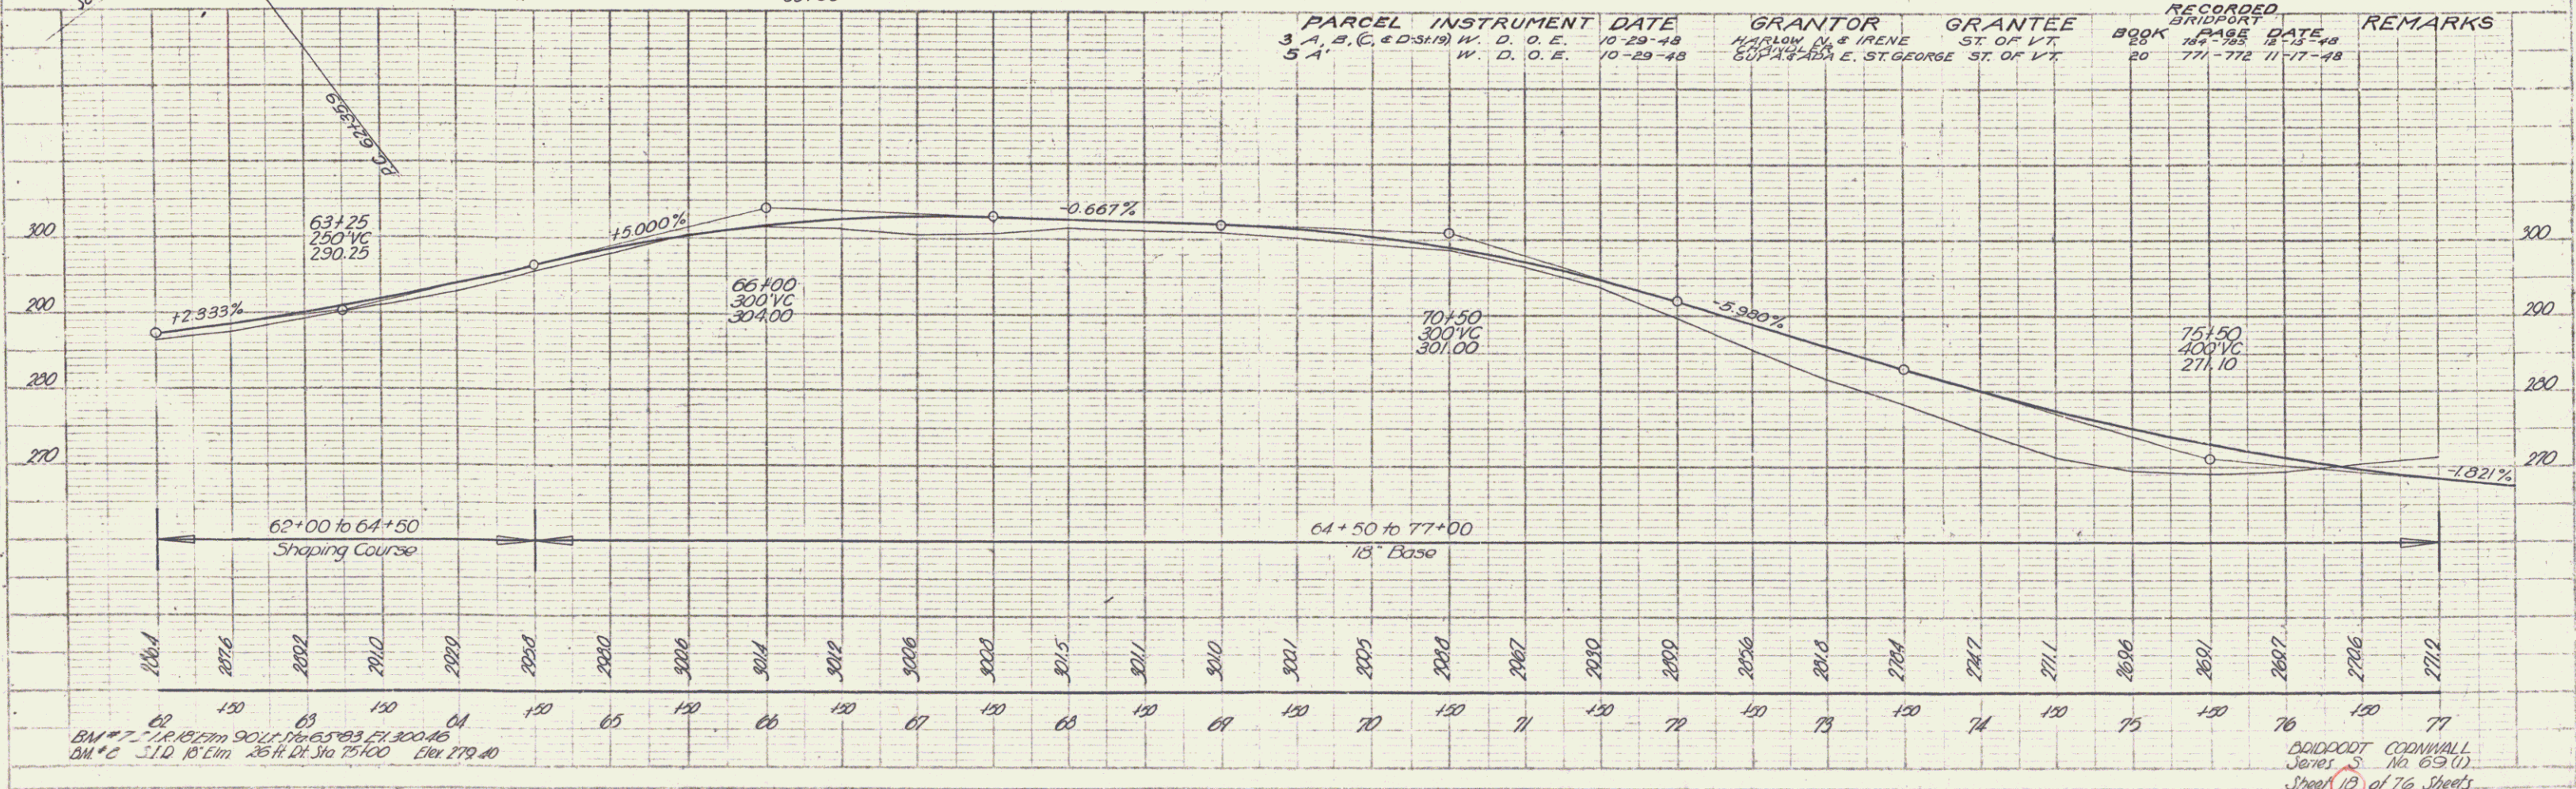

PLAN
 DATE 10-29-48
 BY [Signature]
 CHECKED [Signature]

PROFILE
 DATE 10-29-48
 BY [Signature]
 CHECKED [Signature]

BM #7 - 10' from 90 ft. Drives 293 ft. 300.46
 BM #8 - 5' 11" from 25 ft. Dr. Sta 75+00 Elev. 270.40

DAVIDDOT CONNALL
 Surveyor No. 69 (1)
 Sheet 18 of 76 Sheets