
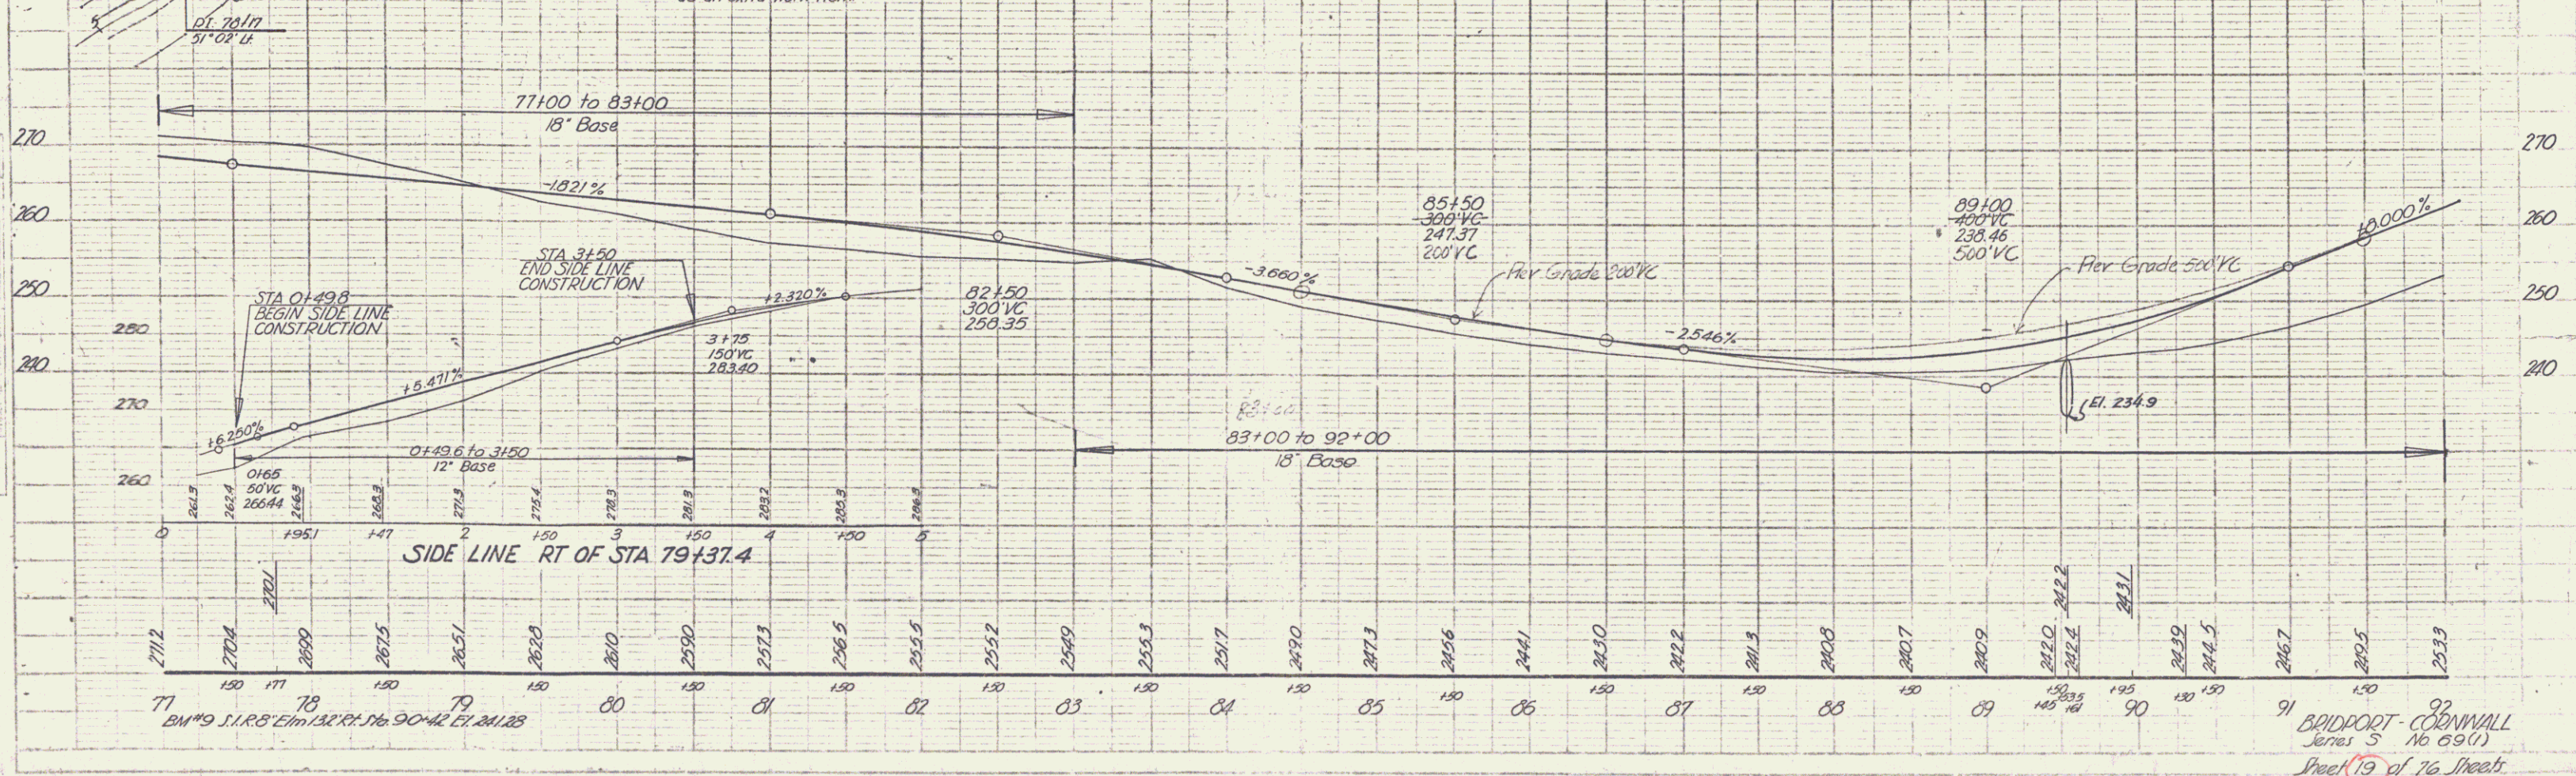


FED. ROAD DIST. NO.	STATE	PROJ. NO.	FISCAL YEAR	SHEET NO.	TOTAL SHEETS
9	VT	6510	1976	19	76

POST 174K F # SECONDARY

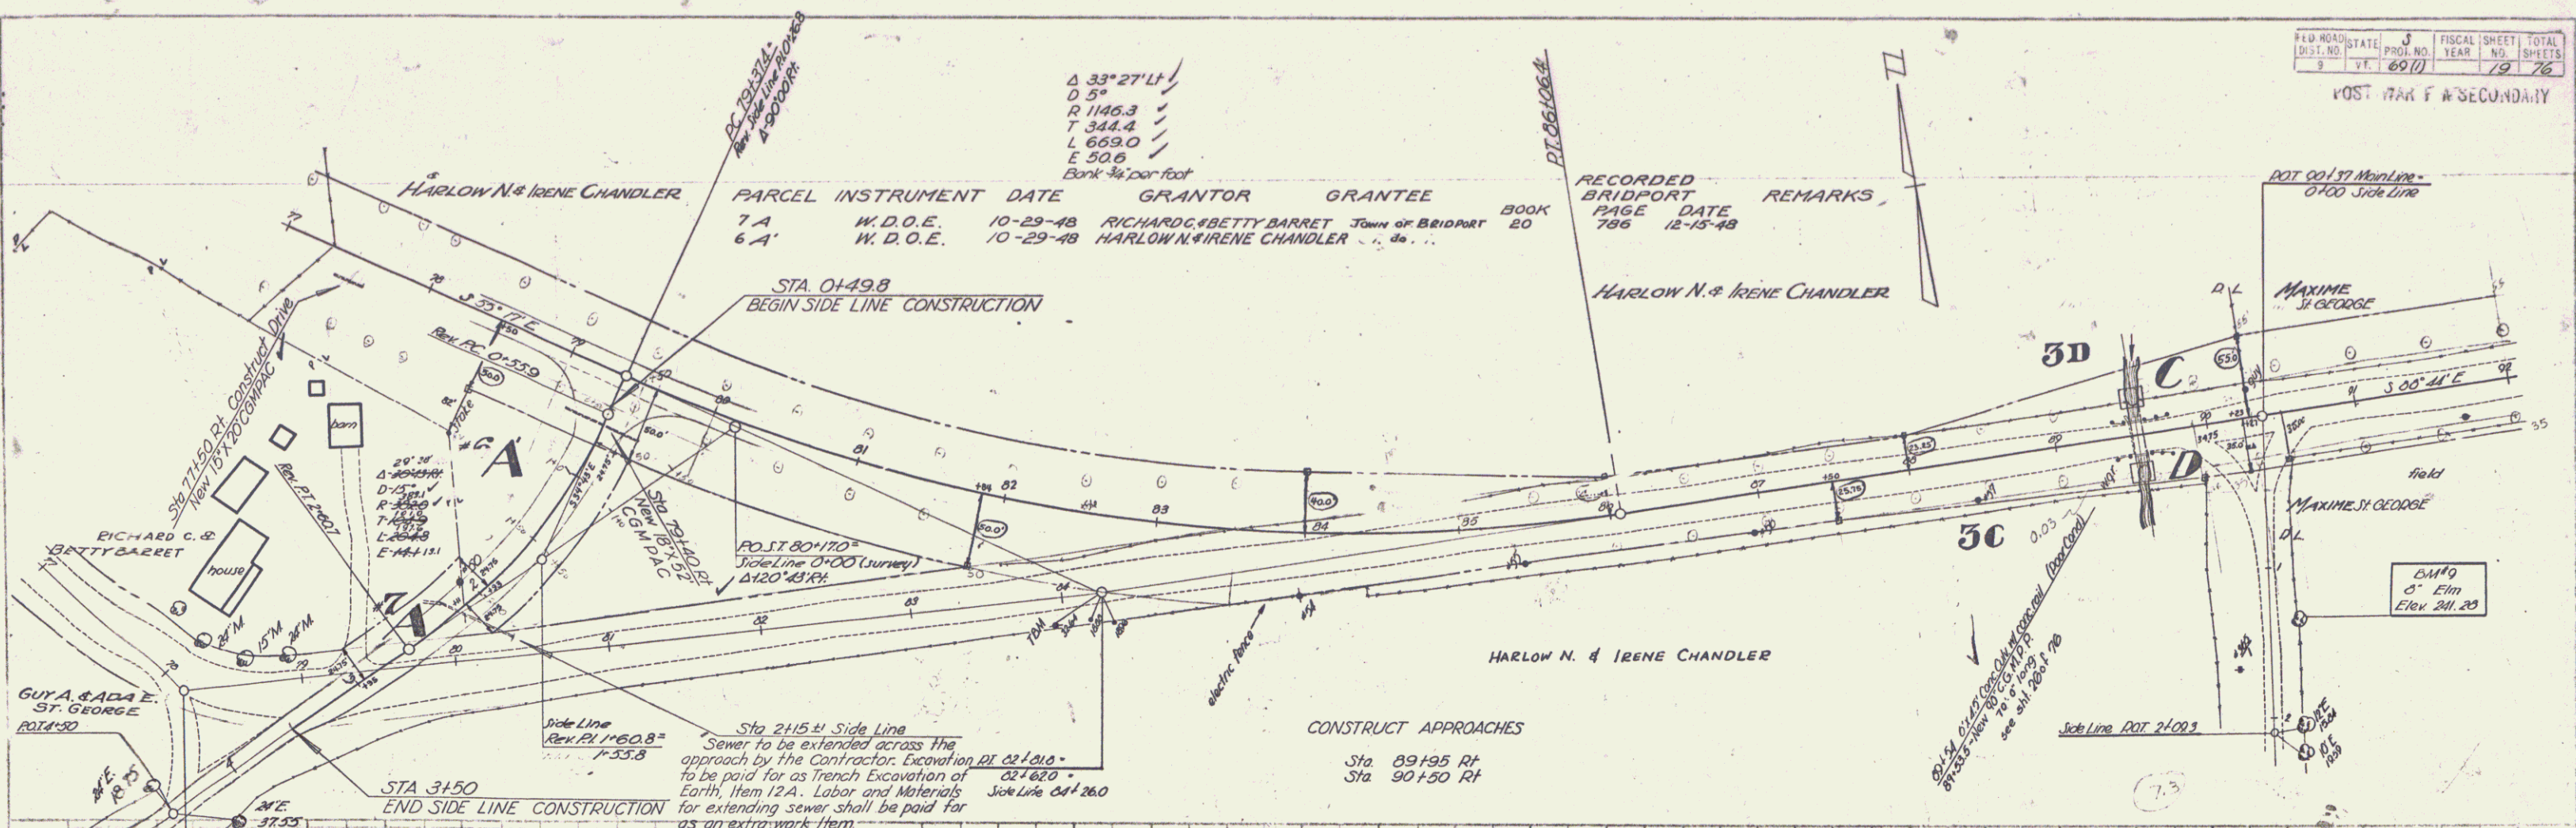

NOTES:
1. SEE SHEET 18 FOR PLAN VIEW OF CONSTRUCTED DRIVE.
2. SEE SHEET 18 FOR PLAN VIEW OF CONSTRUCTED DRIVE.
3. SEE SHEET 18 FOR PLAN VIEW OF CONSTRUCTED DRIVE.

REVISIONS:
NO. DATE BY
1 11/15/76 JAC