


POST-WAR F A SECONDARY

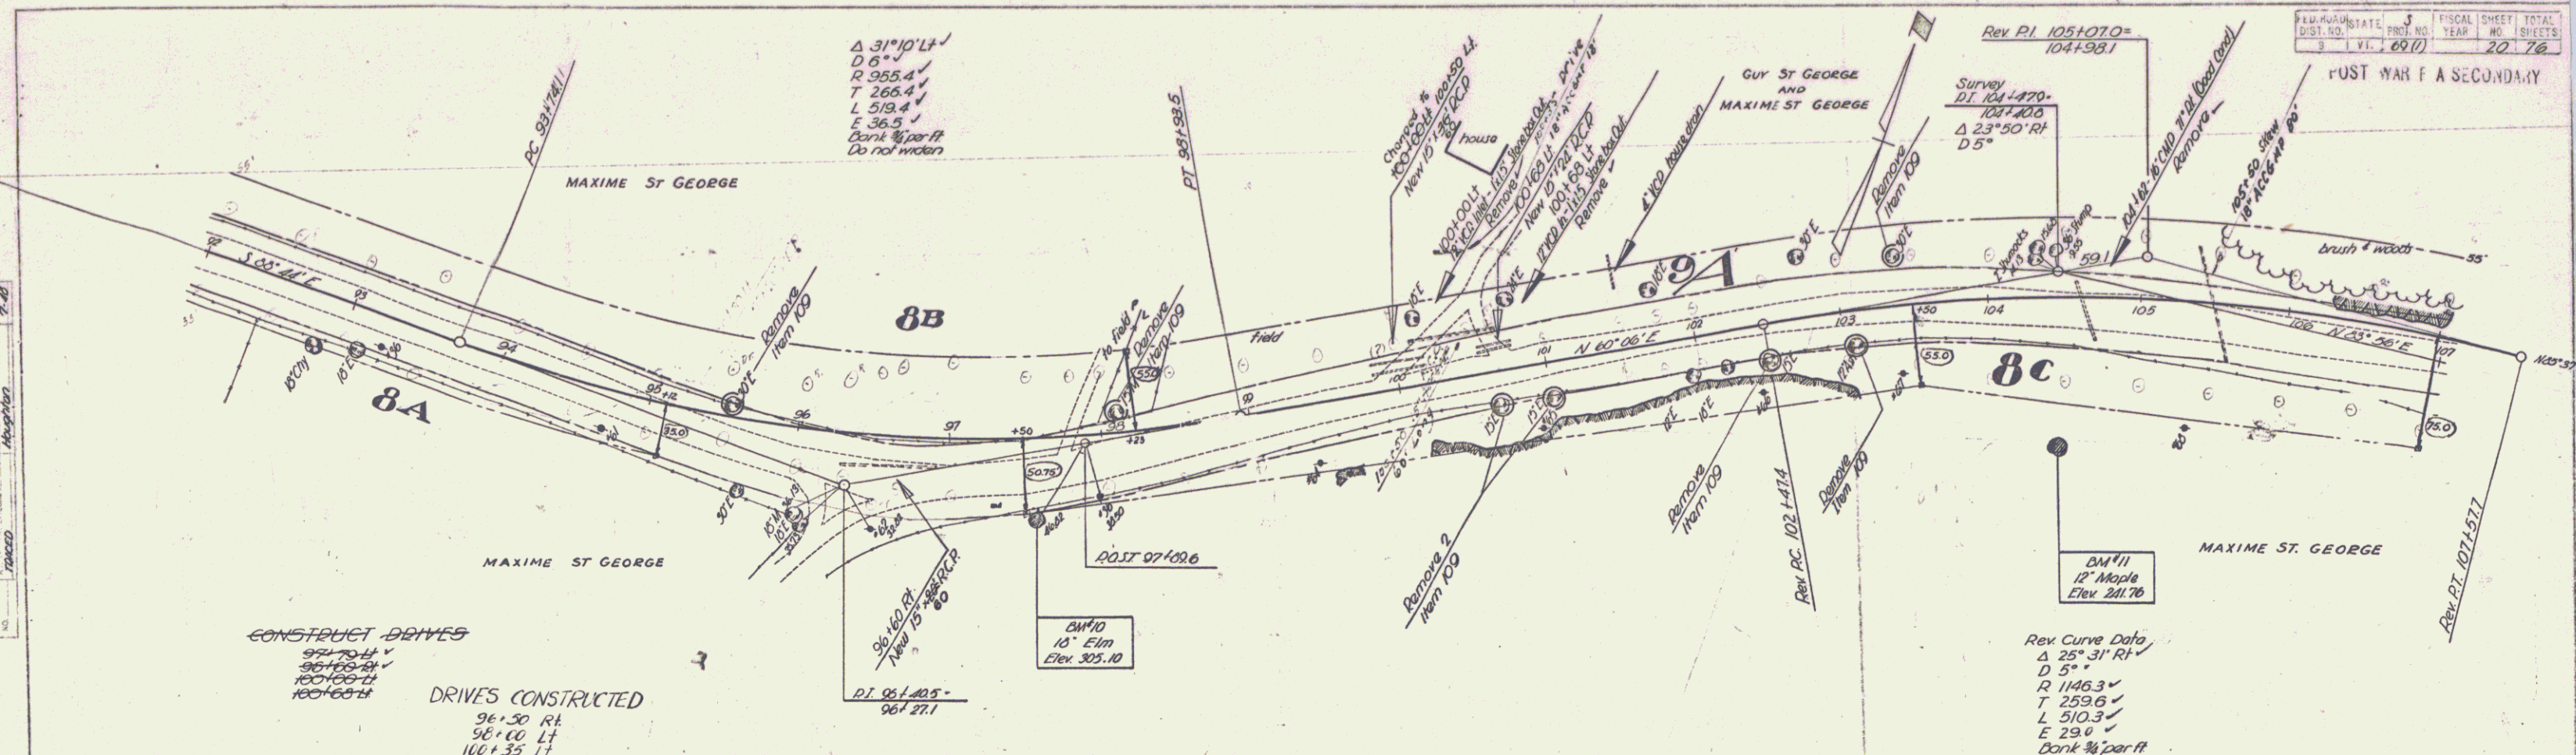


CONSTRUCT DRIVES  
 97+70.4 ✓  
 96+100.24 ✓  
 100+00.14 ✓  
 100+00.14 ✓

DRIVES CONSTRUCTED  
 96+30 Rt  
 96+00 Lt  
 100+35 Lt

Rev Curve Data  
 Δ 25° 31' Rt ✓  
 D 5° ✓  
 R 1146.3 ✓  
 T 259.6 ✓  
 L 510.3 ✓  
 E 29.4 ✓  
 Don't 1/4" per ft

PARCEL	INSTRUMENT	DATE	GRANTOR	GRANTEE	RECORDED	BRIDPORT	PAGE	DATE	REMARKS
8 A & B 1 C	W. D. O. E.	10-29-48	MAXIME ST GEORGE	ST. OF VT.	20	788-789	12-15-48		
9 A	W. D. O. E.	10-29-48	GUY & MAXIME ST GEORGE	ST. OF VT.	20	789-790	12-15-48		

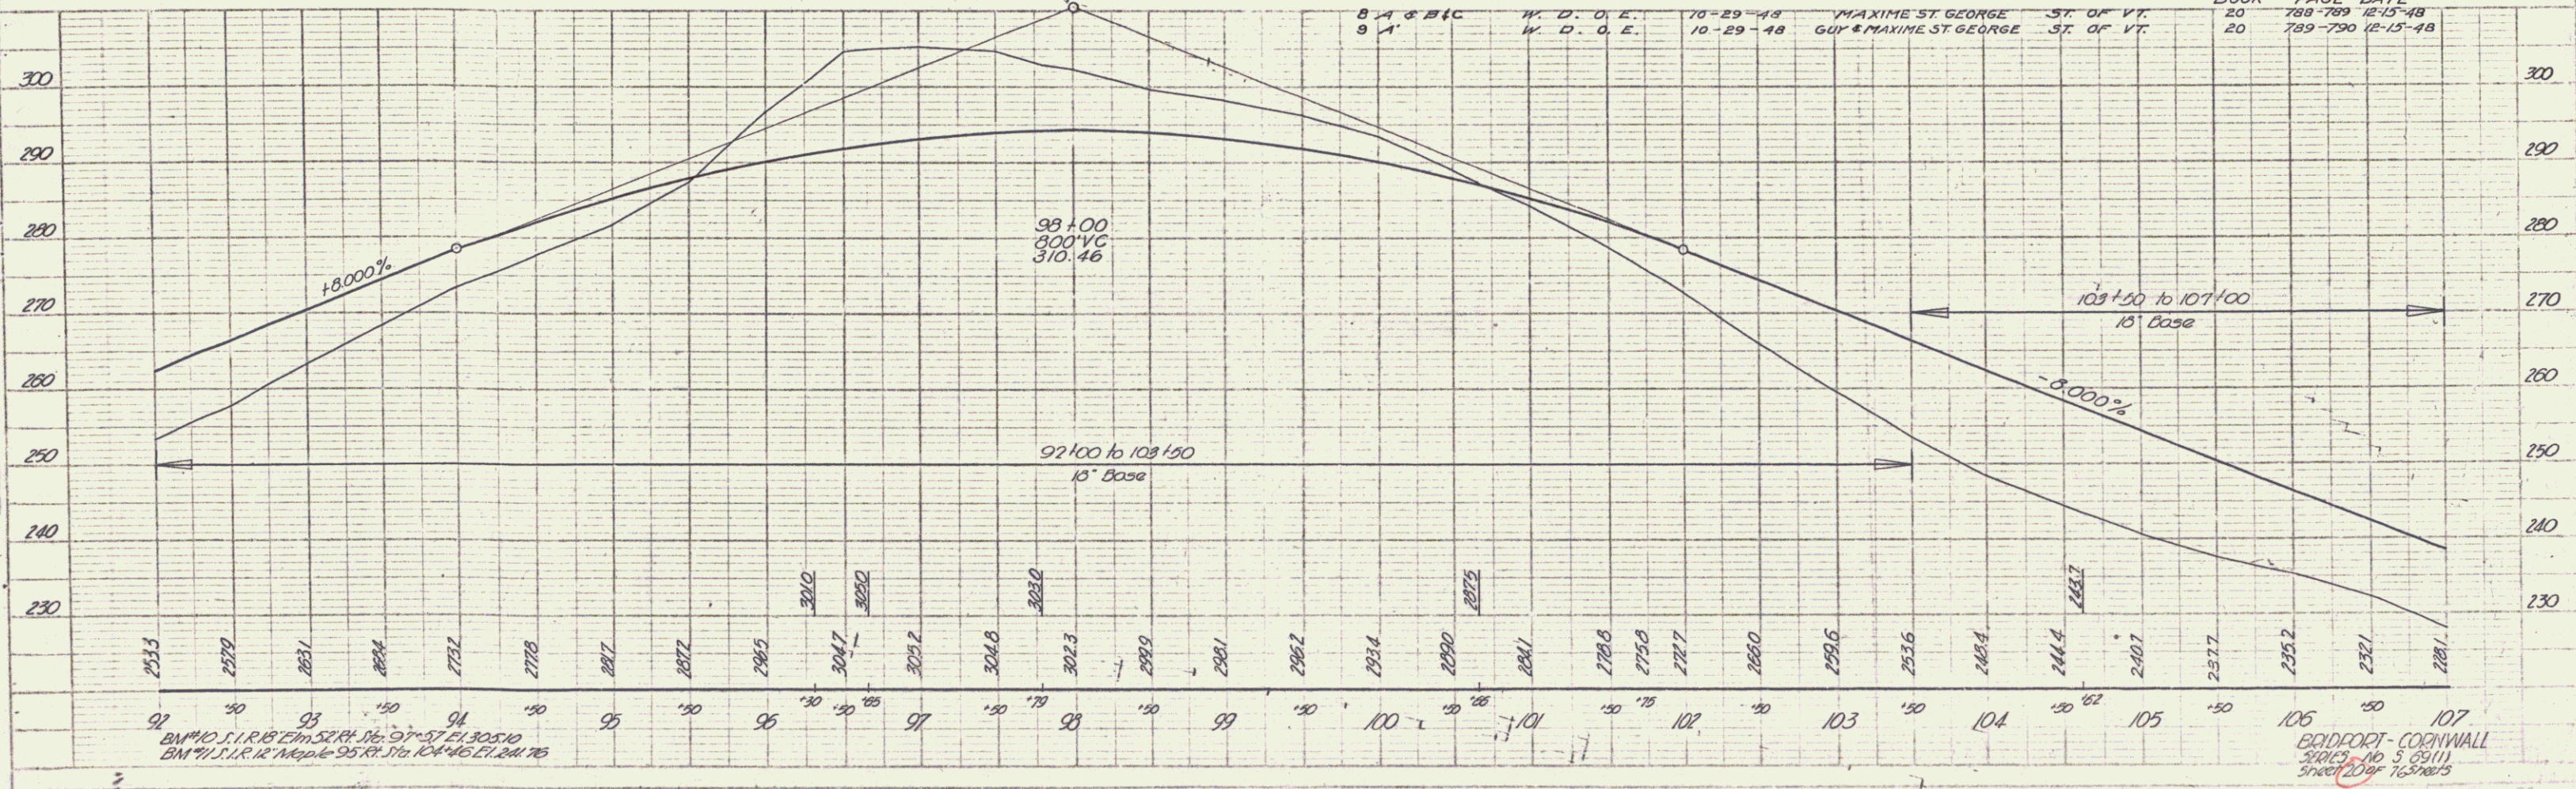

BM 10 S.T. R. 18 E. M. S. 21.1 D. 57° ST. E. L. 305.10  
 BM 11 J. L. R. 12. M. S. 16. 55. R. 11. 104° 46' L. E. L. 211.76

BRIDPORT-CORNWALL  
 3000' x 5' (511)  
 3/20/48