
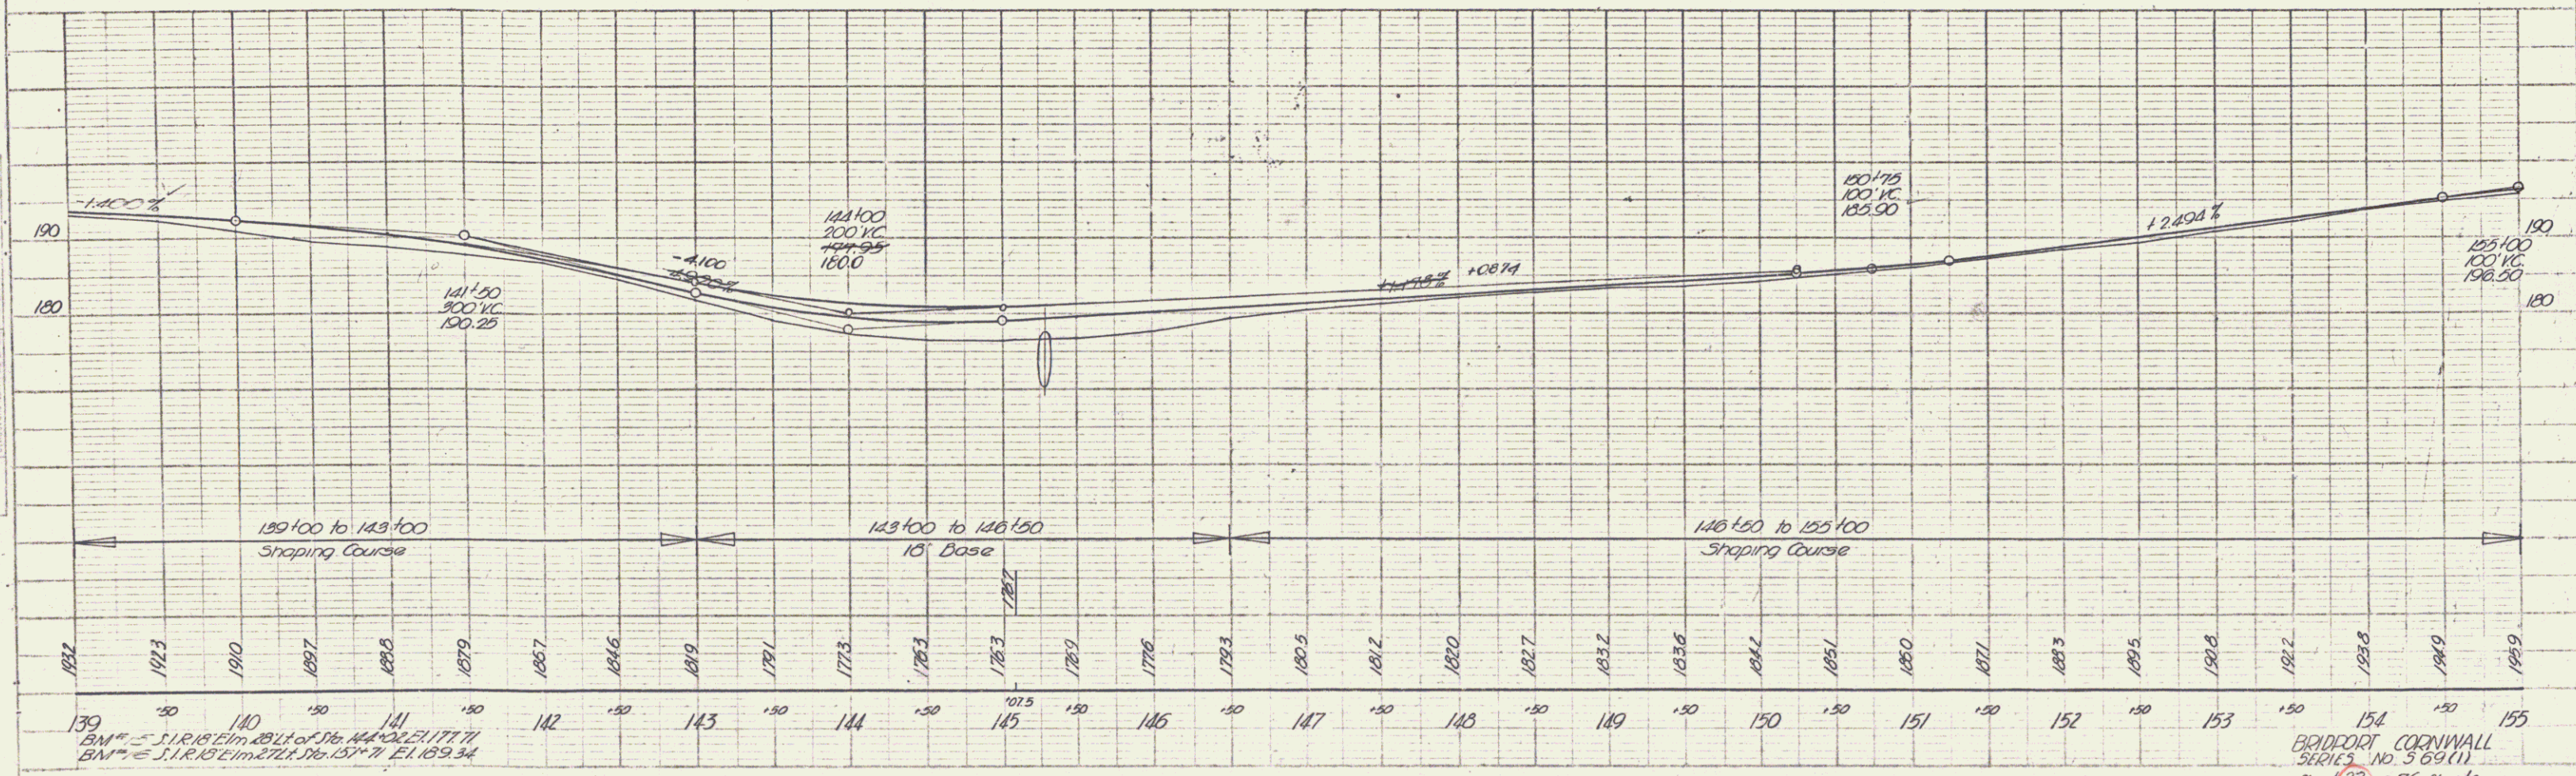
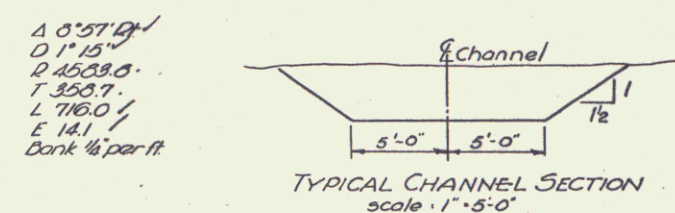


POST WAR F A SECONDARY

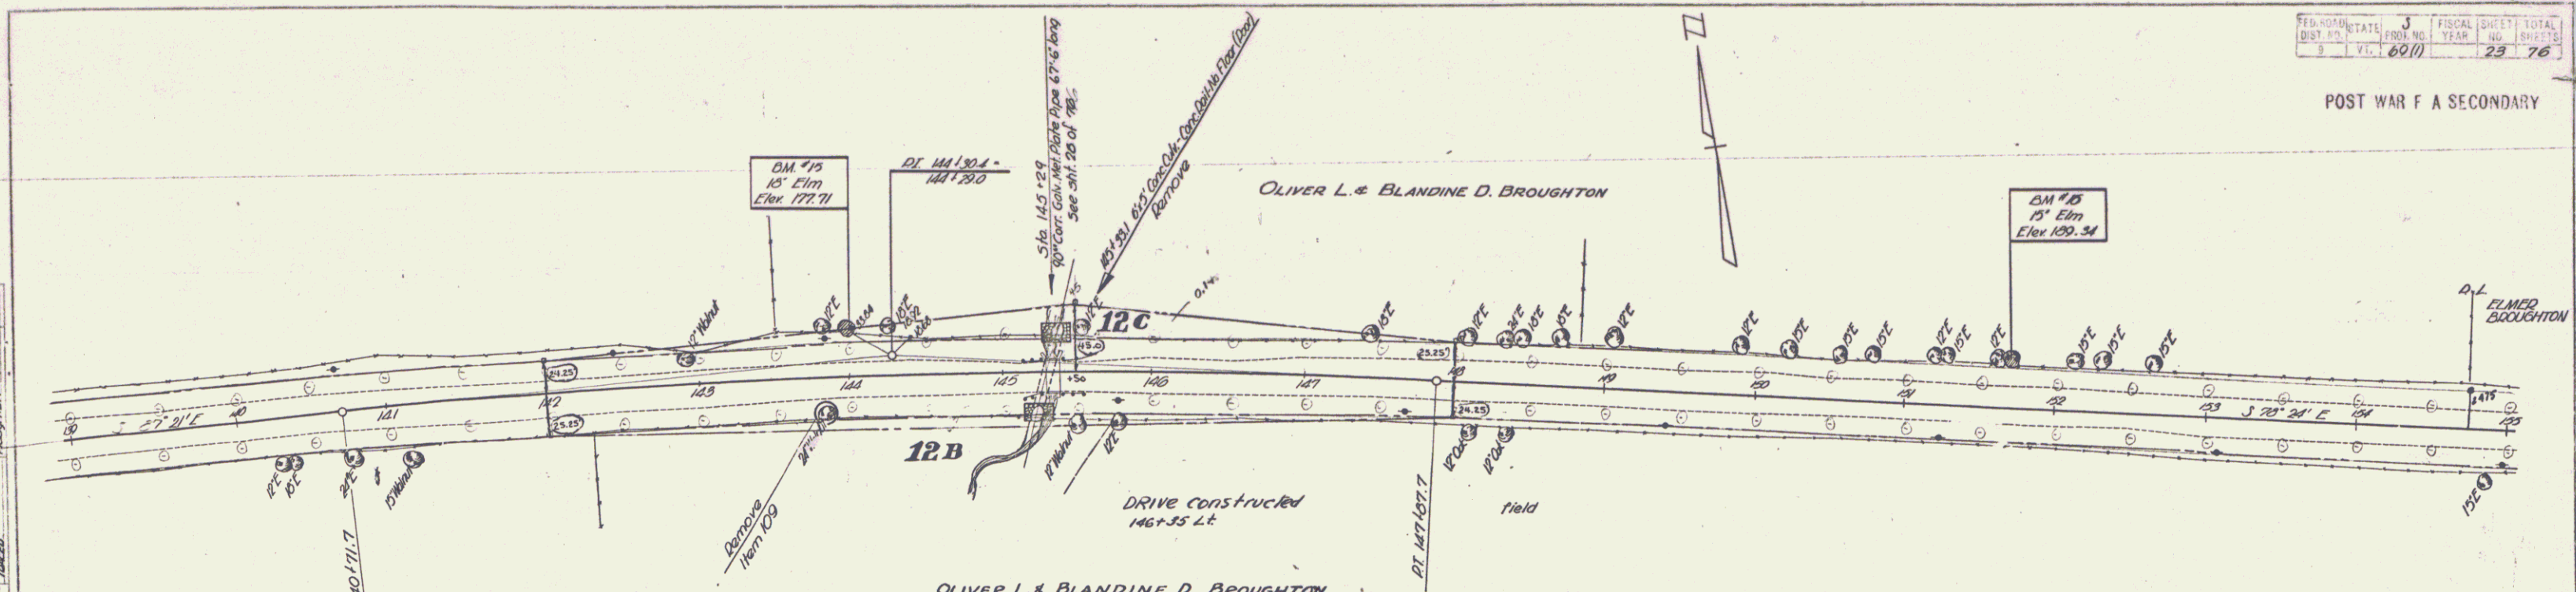

PLAN
PROJECT
DATE
BY
CHECKED
DATE

PROF.
PROJECT
DATE
BY
CHECKED
DATE

BM # 5 S.I.R. 15' Elm 25 ft. of 176 MANOLETTI 71
BM # 6 S.I.R. 15' Elm 27 ft. of 157-71 EL 189.34

BRIDGEFORD CORNWALL
SERIES NO. 569(1)
Sheet 23 of 76 sheets

PLATE 1 - PLAN & PROFILE
SCALE 1"=50' HORIZ. 1"=10' VERT.