



POST WAR F A SECONDARY

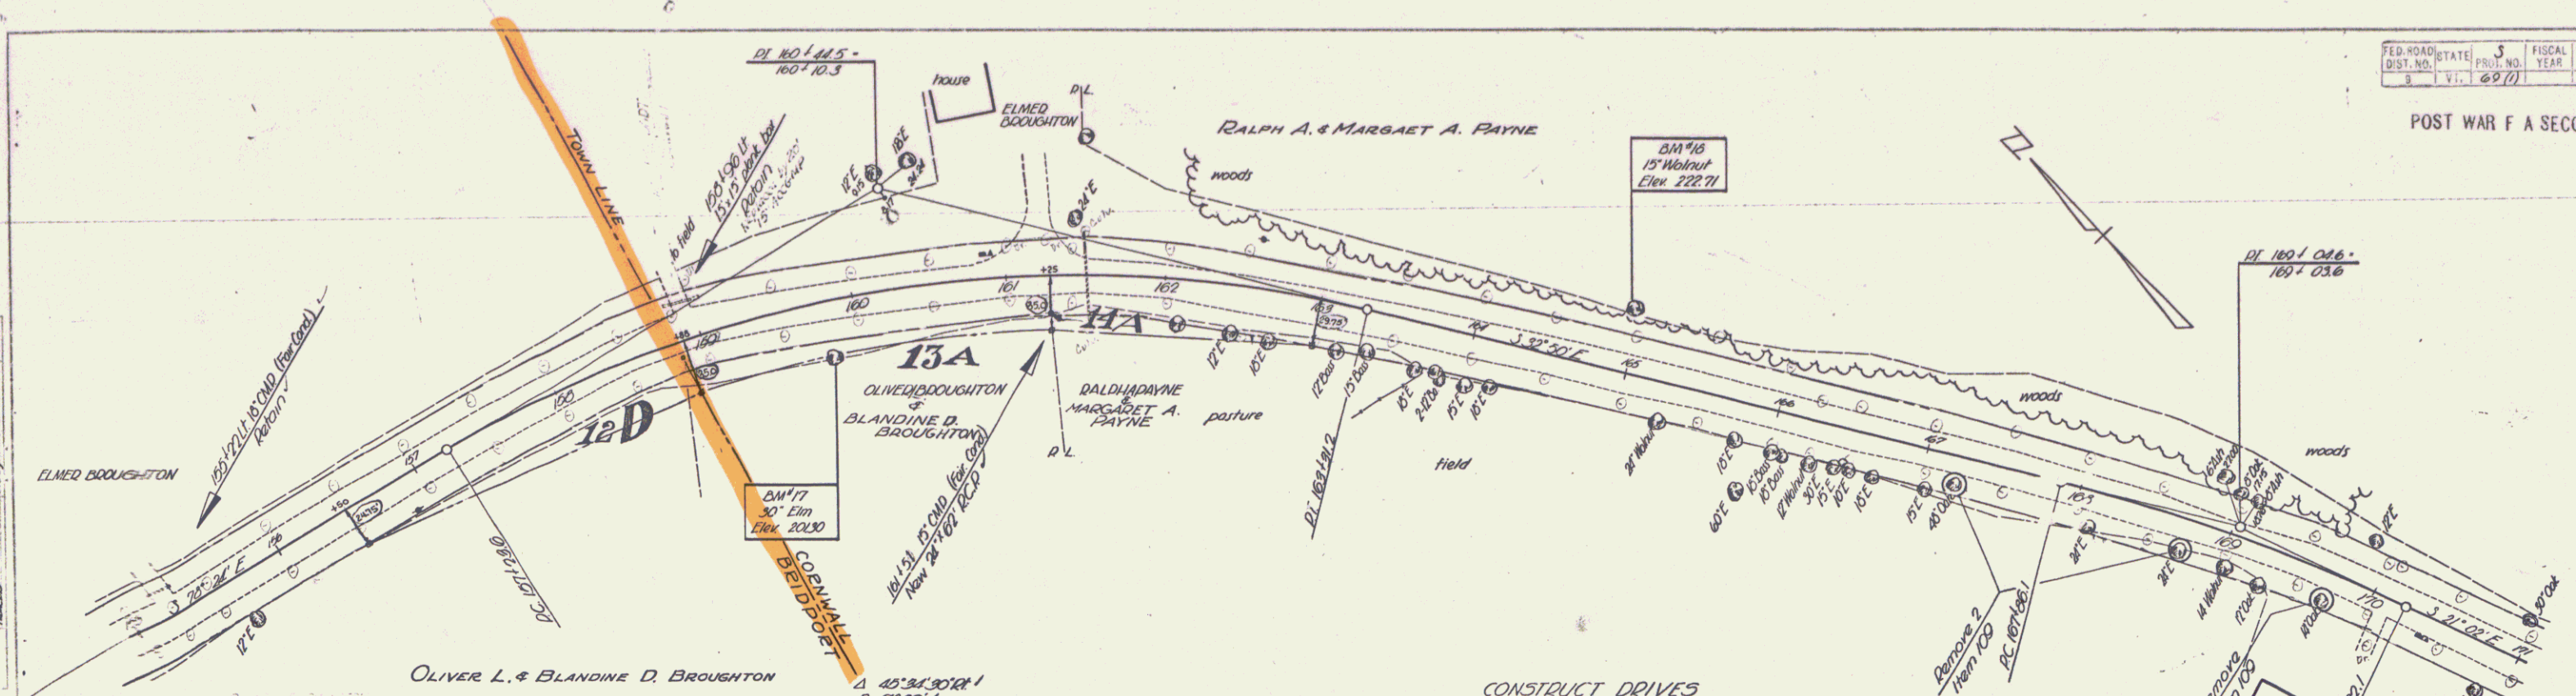

$\Delta 45^{\circ} 34' 30.72''$
 $D 7^{\circ} 50' 1''$
 $D 704.5'$
 $T 320.9'$
 $L 007.0'$
 $E 64.7'$
 Bank $\frac{3}{4}$ per ft
 Do not widen

CONSTRUCT DRIVES
 $100^{\circ} 15' 58''$ 41'
 $181^{\circ} 29' 11''$
 $170^{\circ} 10' 24''$

PARCEL	INSTRUMENT	DATE	GRANTOR	GRANTEE	BOOK	RECORDED CORNWALL	REMARKS
14-A & B	W.D.O.E.	10-29-48	RALPH A. & MARGAET A. PAYNE	ST. OF VT.	19	160-161	12-15-48 SEE SHEET 25

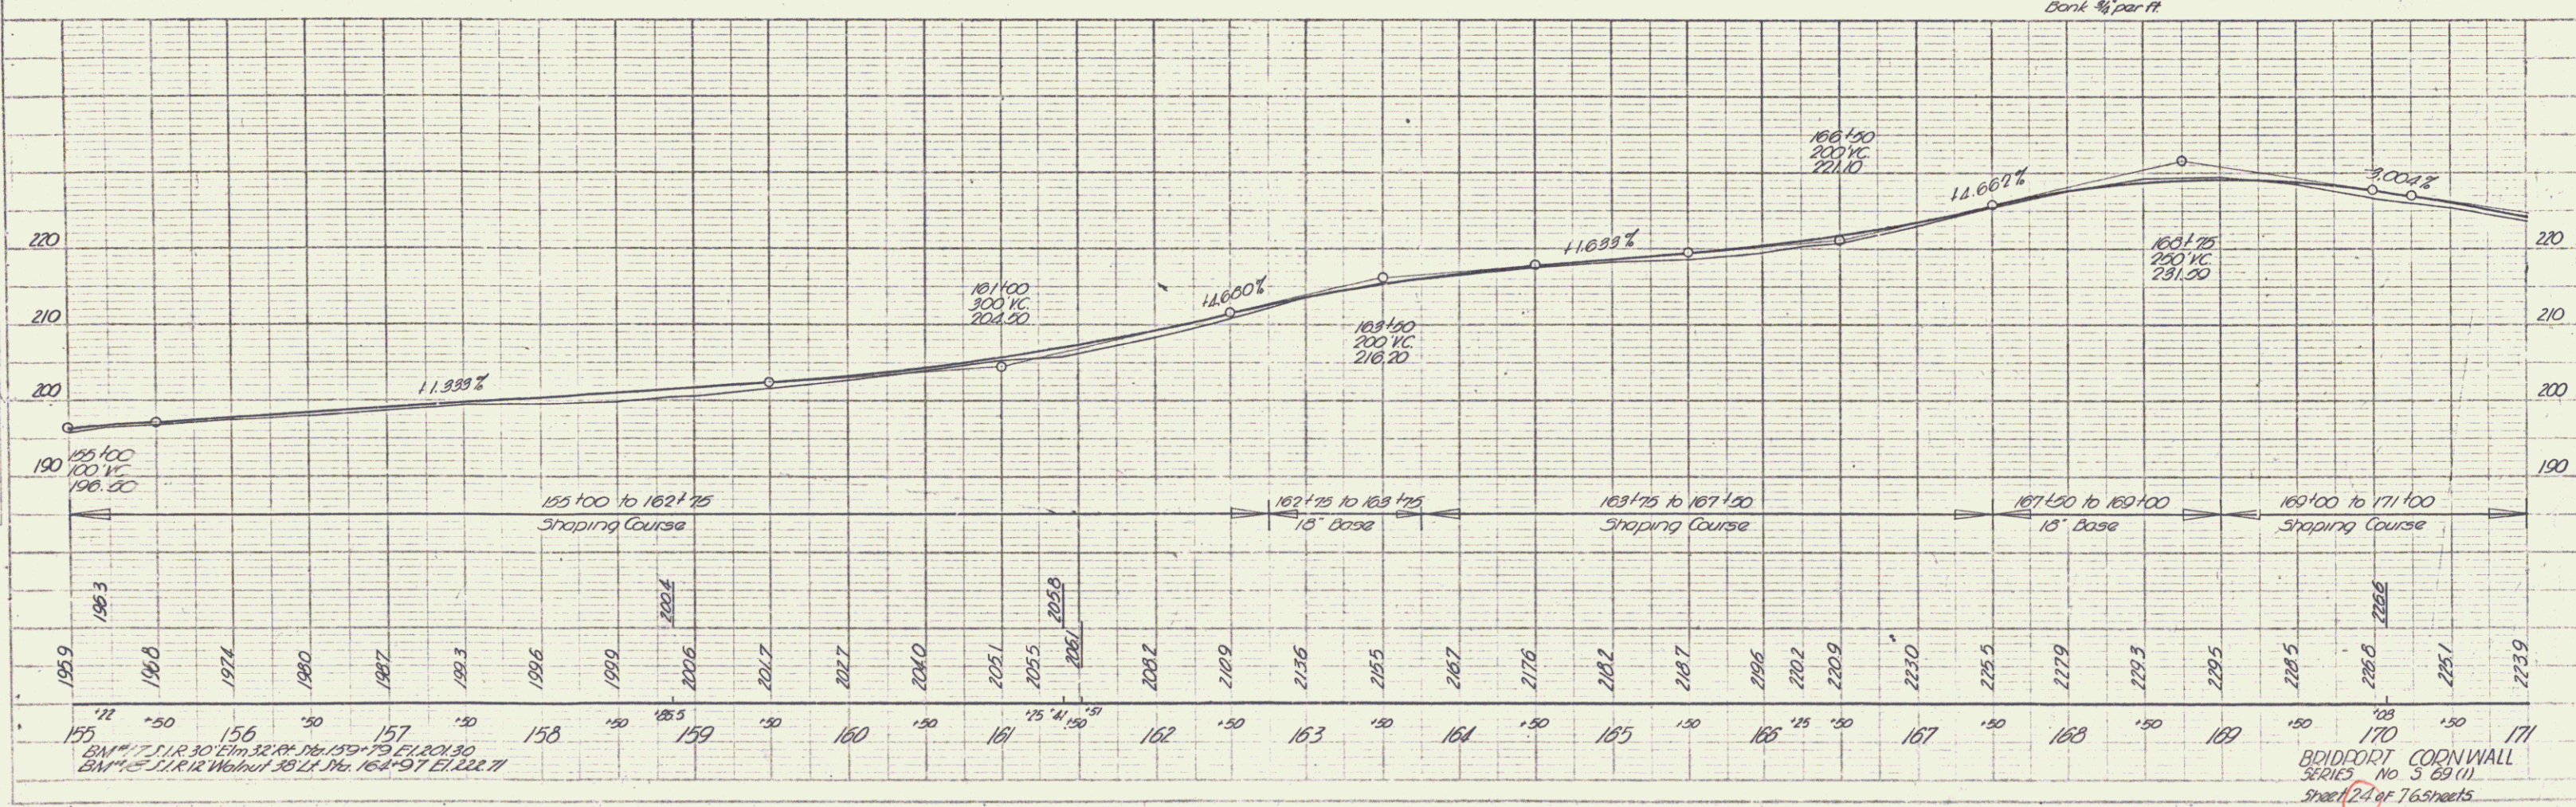

SCALE
 HORIZONTAL
 VERTICAL
 DATE
 DRAWN BY
 CHECKED BY

PROFILE
 SCALE
 DATE
 DRAWN BY
 CHECKED BY