


PWA 1020K 1936 2 15

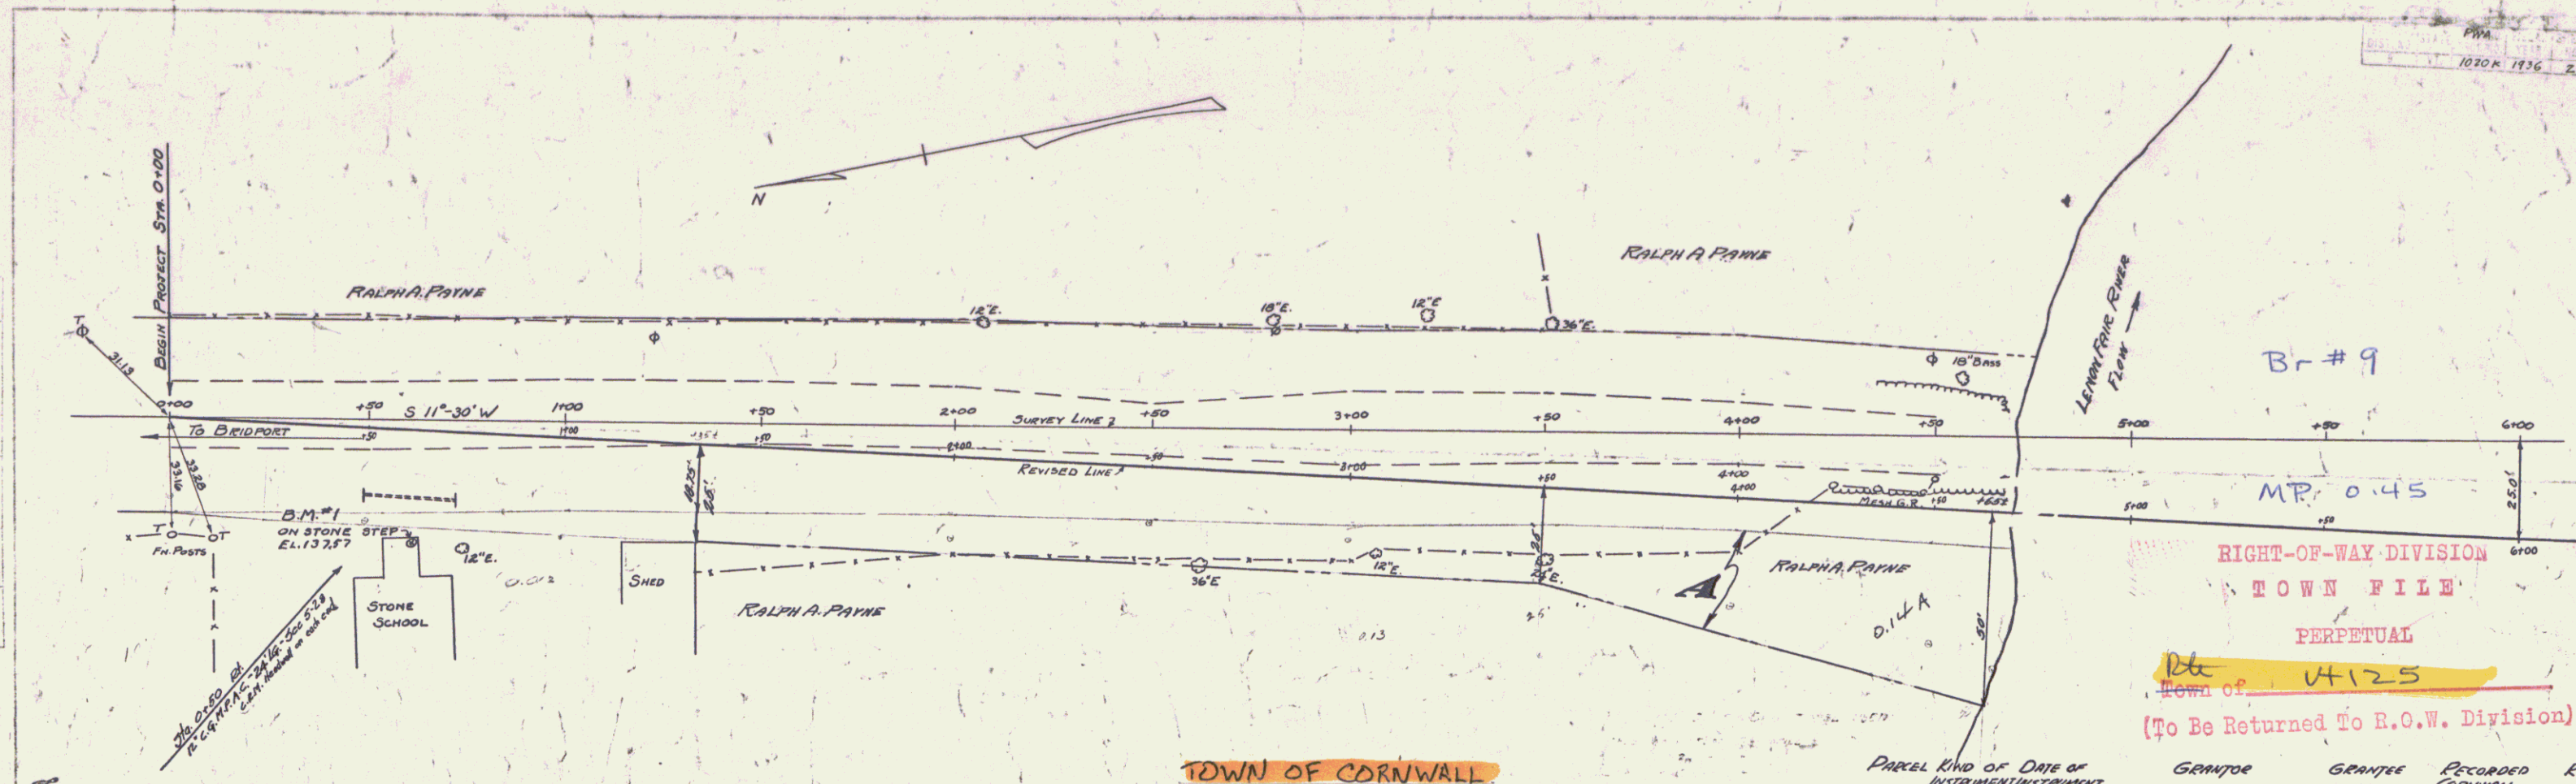


**TOWN OF CORNWALL**  
 Project PWA 1020K  
 Pin # 992574  
 Route VT 125  
 Date 12/4/1935

PARCEL	END OF DATE OF INSTRUMENT	GRANTEE	GRANTEE CORNWALL	RECORDED DATE	REMARKS
1	Q.C.D. 3-16-36	RALPH A. PAYNE		17 96-97 10-37	

MP 0.378-0.519

APPROVED - Dec. 4, 1935  
*H. E. Sargent*  
 CHIEF ENGINEER

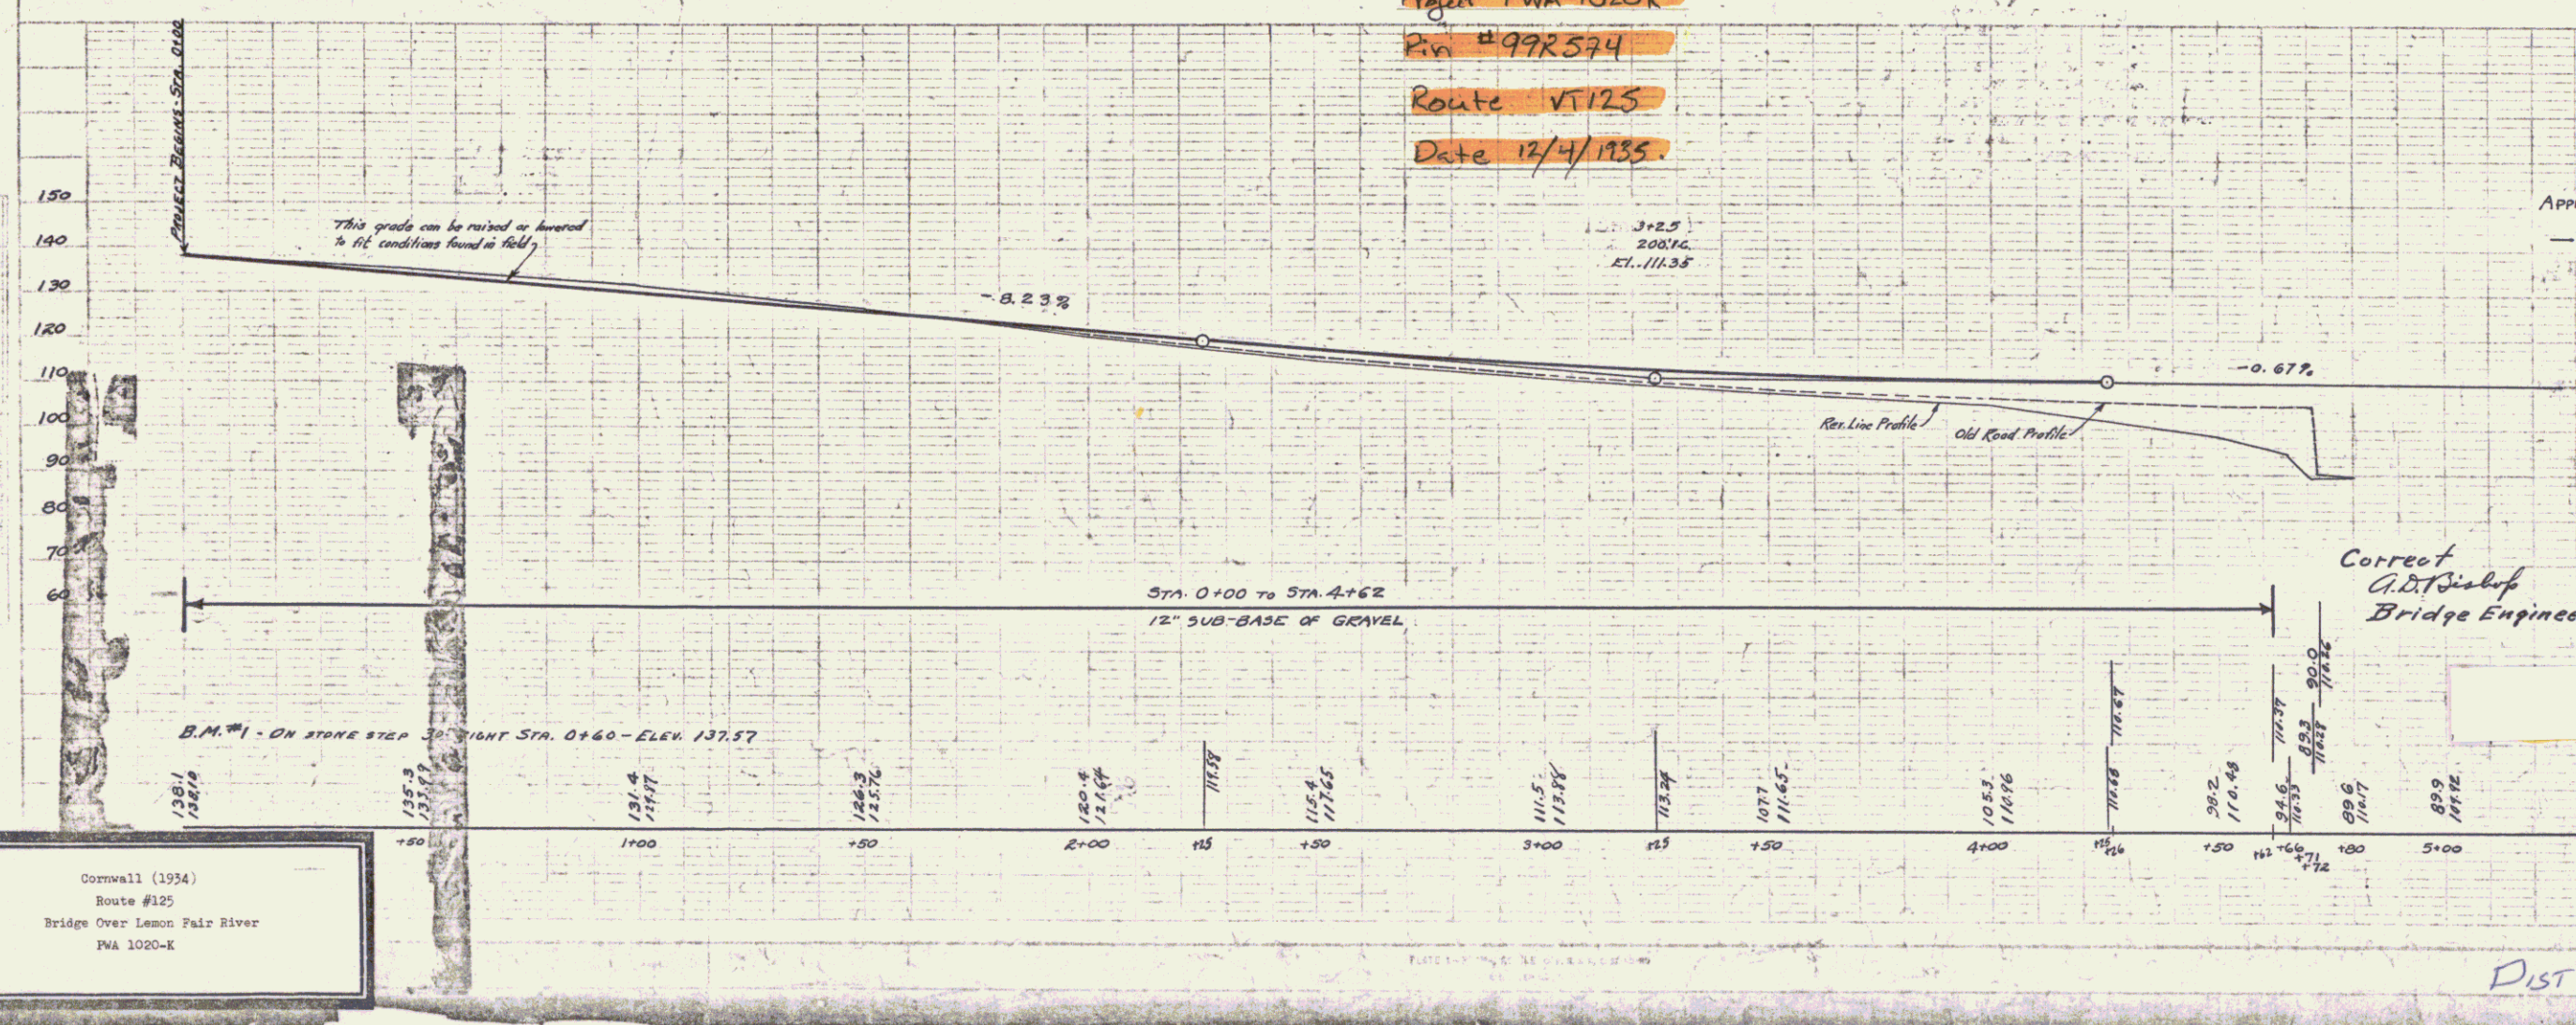

PLAN  
 SCALE  
 NOTE BOOK  
 RECORD  
 DATE

PROFILE  
 SCALE  
 NOTE BOOK  
 RECORD  
 DATE

Cornwall (1934)  
 Route #125  
 Bridge Over Lemon Fair River  
 PWA 1020-K

DIST. # 5 PLANS