

ALL DRIVES AS INDICATED ON PLANS ARE SUBJECT TO PERMITS PURSUANT TO TITLE 19, SECTION 43, V.S.A.

BEGIN R.O.W. PROJECT HHS 0172 (1)  
STA. 117+00 CL.

CONST. DRIVE  
115+25 RT  
122+07 LT

DEVELOPING AND RAISING OF  
SOLID ROCK CURBGRADE  
FROM 209.10

CONSTRUCT. DRIVEWAY  
123+00 RT.

BINGHAM, ROBERT B. & MAROLYN B.  
BEGIN MAINT. AGREE. AREA NO. 1  
STA. 123+00 II' RT. (95')



125+00  
110' LT.

POST 124+15.36  
Chord 0+00.00  
Δ 30° 52' RT

POC 124+50

PLAN

PROFILE

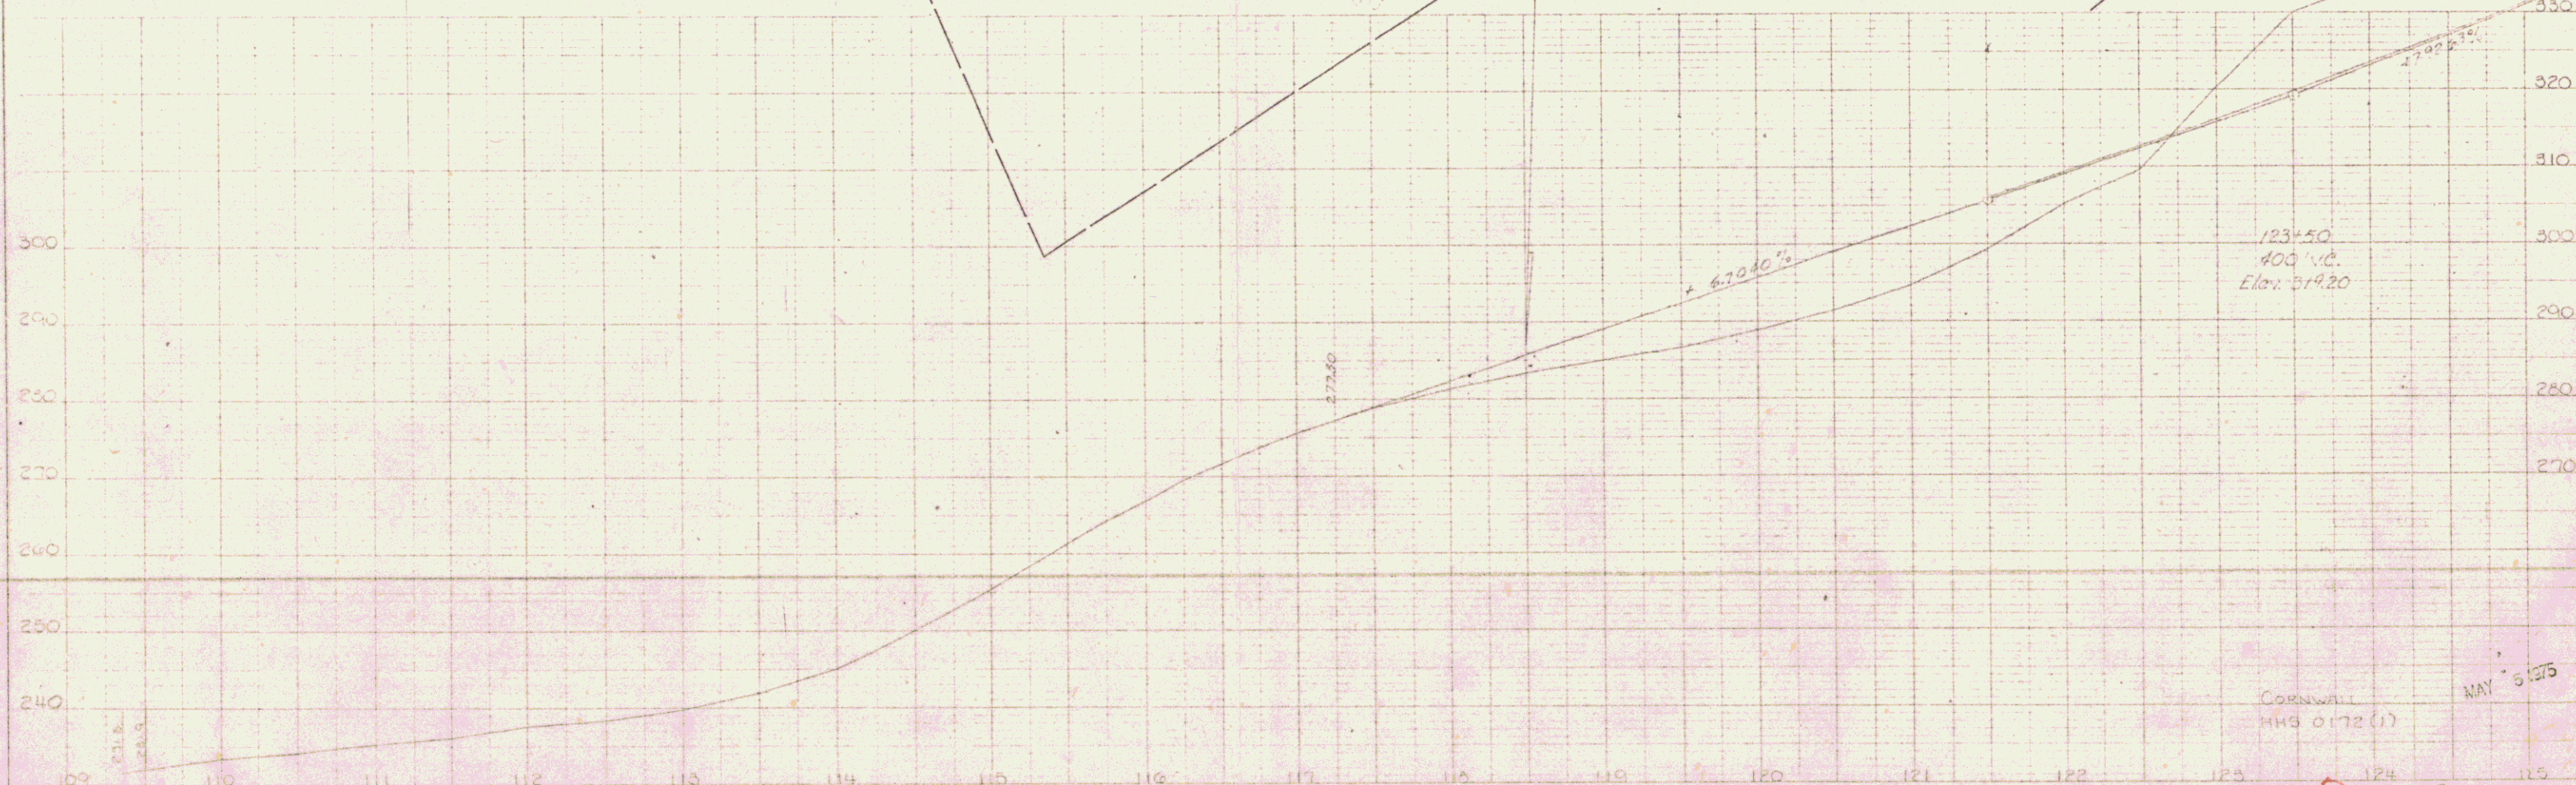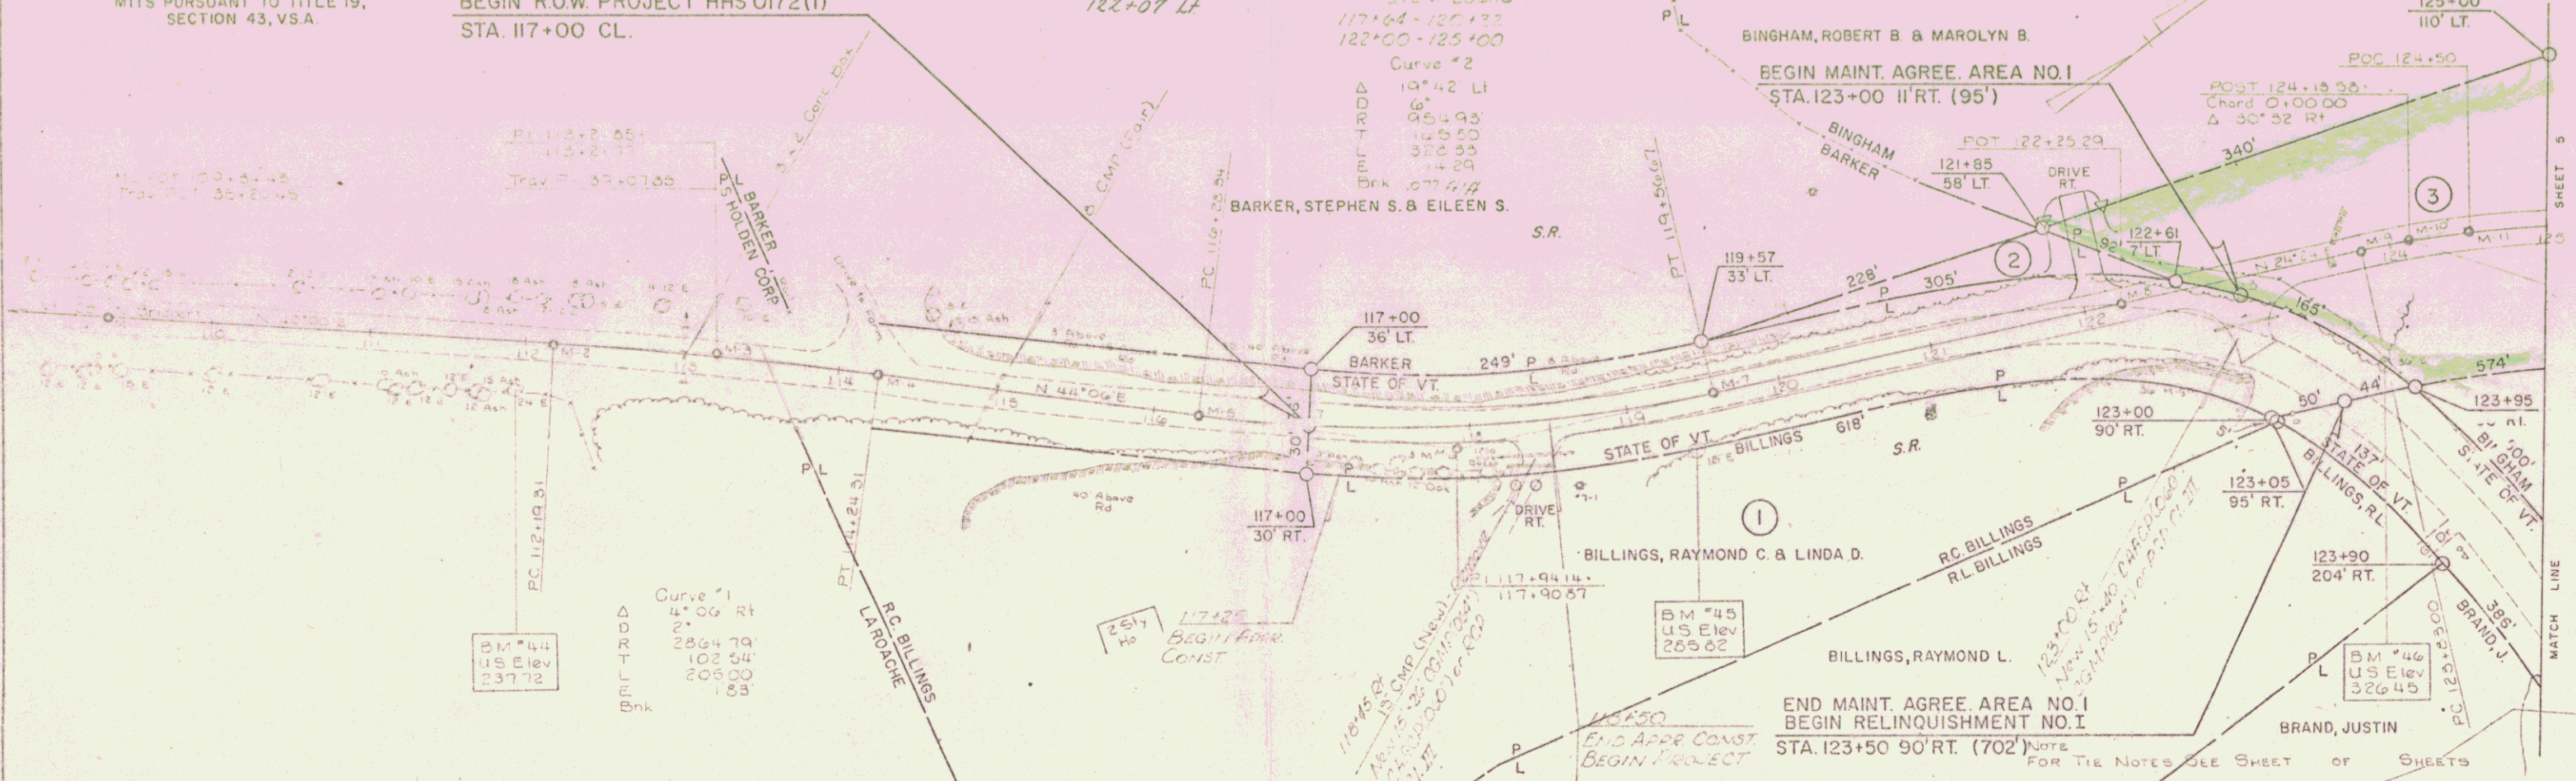

K-E PLATE 1, PLAN/PROFILE  
SCALE 1/4" = 1'-0"

Cornwall  
HHS 0172 (1)  
MAY 5 1973

SHEET 4 OF 6 SHEETS