


WELLS INC. BLASTING
 SPLIT ROCK 15' x 10'
 ITEM 702
 125+00 - 126+80
 128+80 - 134+80

ALL DRIVES AS INDICATED ON
 PLANS ARE SUBJECT TO PER-
 MITS PURSUANT TO TITLE 19,
 SECTION 43, V.S.A.

GUARD RAIL THREE CABLE
 W/ILT STEEL POSTS
 ITEM 621.21
 125+82 - 129+18 CL
 126+23 - 129+27 LT

GUARD RAIL PLANK W/ WOOD POSTS
 ITEM 621.10
 130+80 - 130+84 RT (SERRICA P)

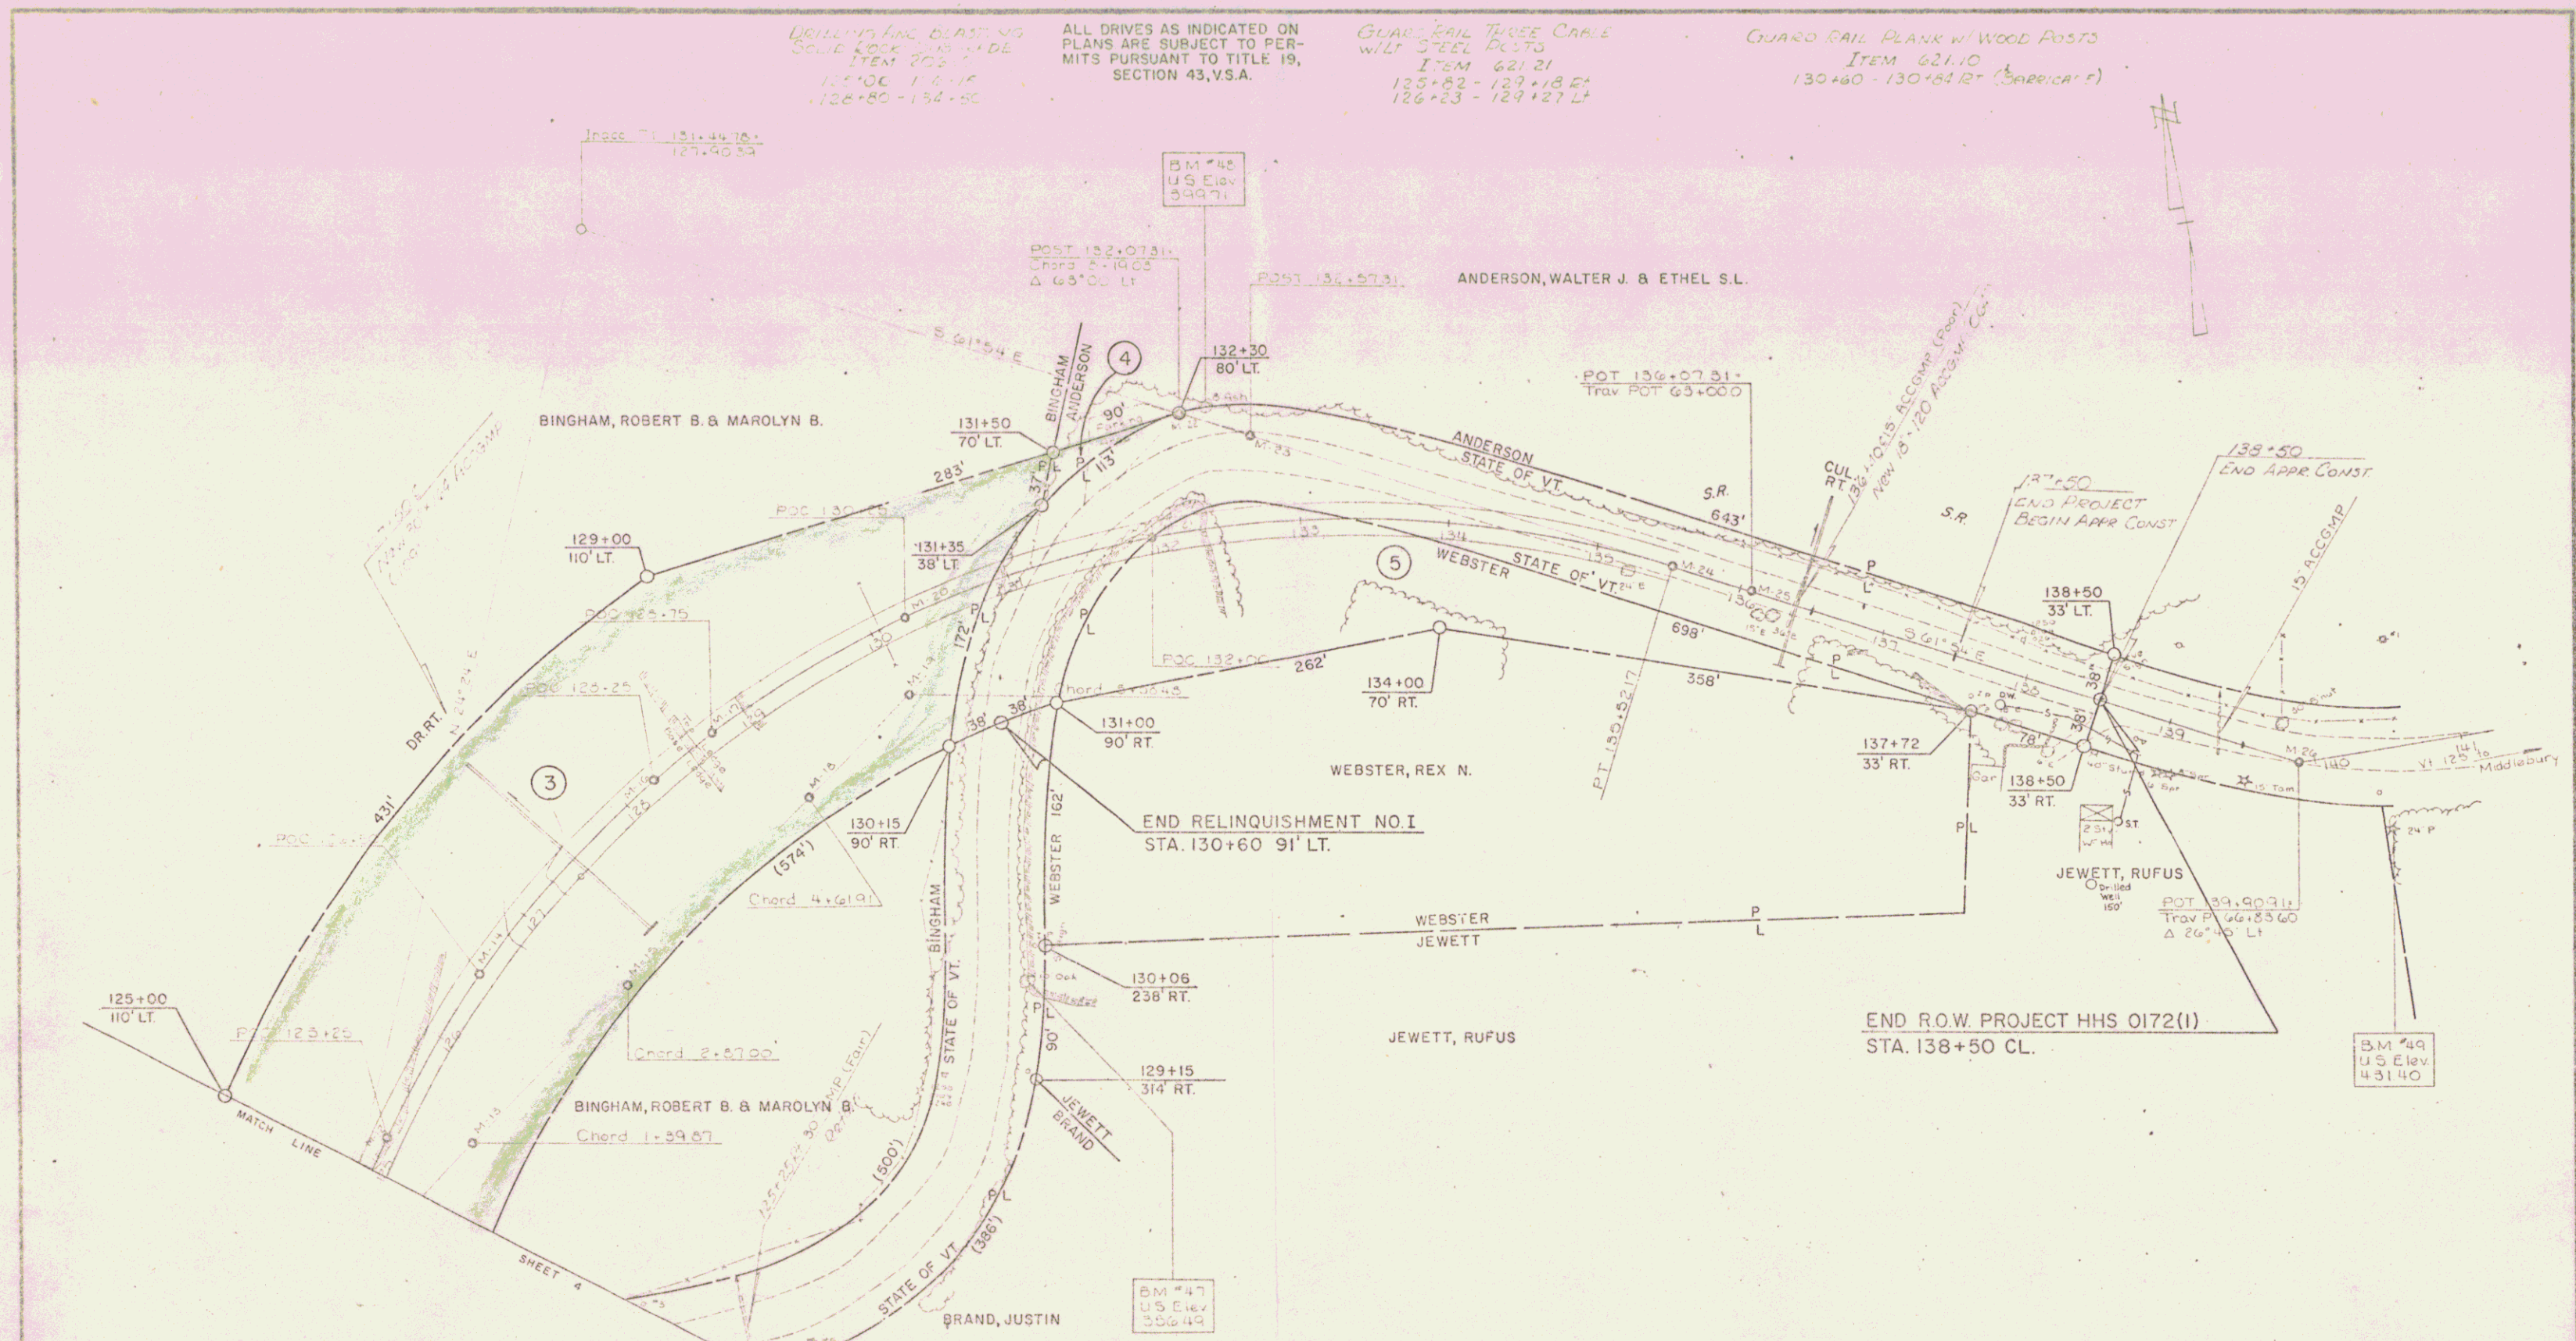

Curve #3
 93° 32' RT
 6'
 716.20'
 721.75'
 1169.17'
 329.34'
 Bk. 0.000/1.1

NOTE FOR THE NOTES
 SEE SHEET 4 OF SHEETS
 MAY 5 1974

CORNWALL
 SUPPLIED BY: Fall DATE 12/74
 DRAWN BY: D.J. Gilman DATE 1/76
 TRACED BY: Duffy DATE 1/76
 PROJ. HHS NO. 0172(1)
 SHEET 5 OF 6
 0-7

3