

REMOVAL & DISPOSAL OF  
PRESENT GUARD RAIL  
47+00 to 47+49 L+  
+8R  
Crosstied Timber Curb  
47+00 - 47+49 L+

THREE CABLE GUARD  
RAIL WITH STEEL POSTS  
47+00 to 49+01 L+  
50+01

MIDDLEBURY COLLEGE

PARCEL 1B  
41+54 - 50+94.5  
0.17 ACRES

BM #9  
SIT 12" Y. Birch  
El. 560.76

Δ 6°49'11" L  
D 3' L  
R 1910.1 L  
T 123.8 L  
L 227.2 L  
L 34 L  
bank 1/2" per ft

Δ 41°35'11" L  
D 50' L  
R 114.6 L  
T 43.5 L  
L 83.2 L  
E 2.0 L


DATE: 10/20/00  
SCALE: 1" = 40'  
DRAWN BY: L. MILLER  
CHECKED BY: B. BRADEN  
PROJECT: MIDDLEBURY COLLEGE  
TRACED

47+00 - 50+90 RL  
Limits of Clearing & Grubbing Item 104

Sta 49+500  
END PROJECT  
S 137(2)  
Construct Satisfactory  
Approach

PARCEL 2D  
42+42 - 50+94.5  
1.92 ACRES

GREEN MOUNTAIN  
NATIONAL FOREST  
TRACT 500Bn.

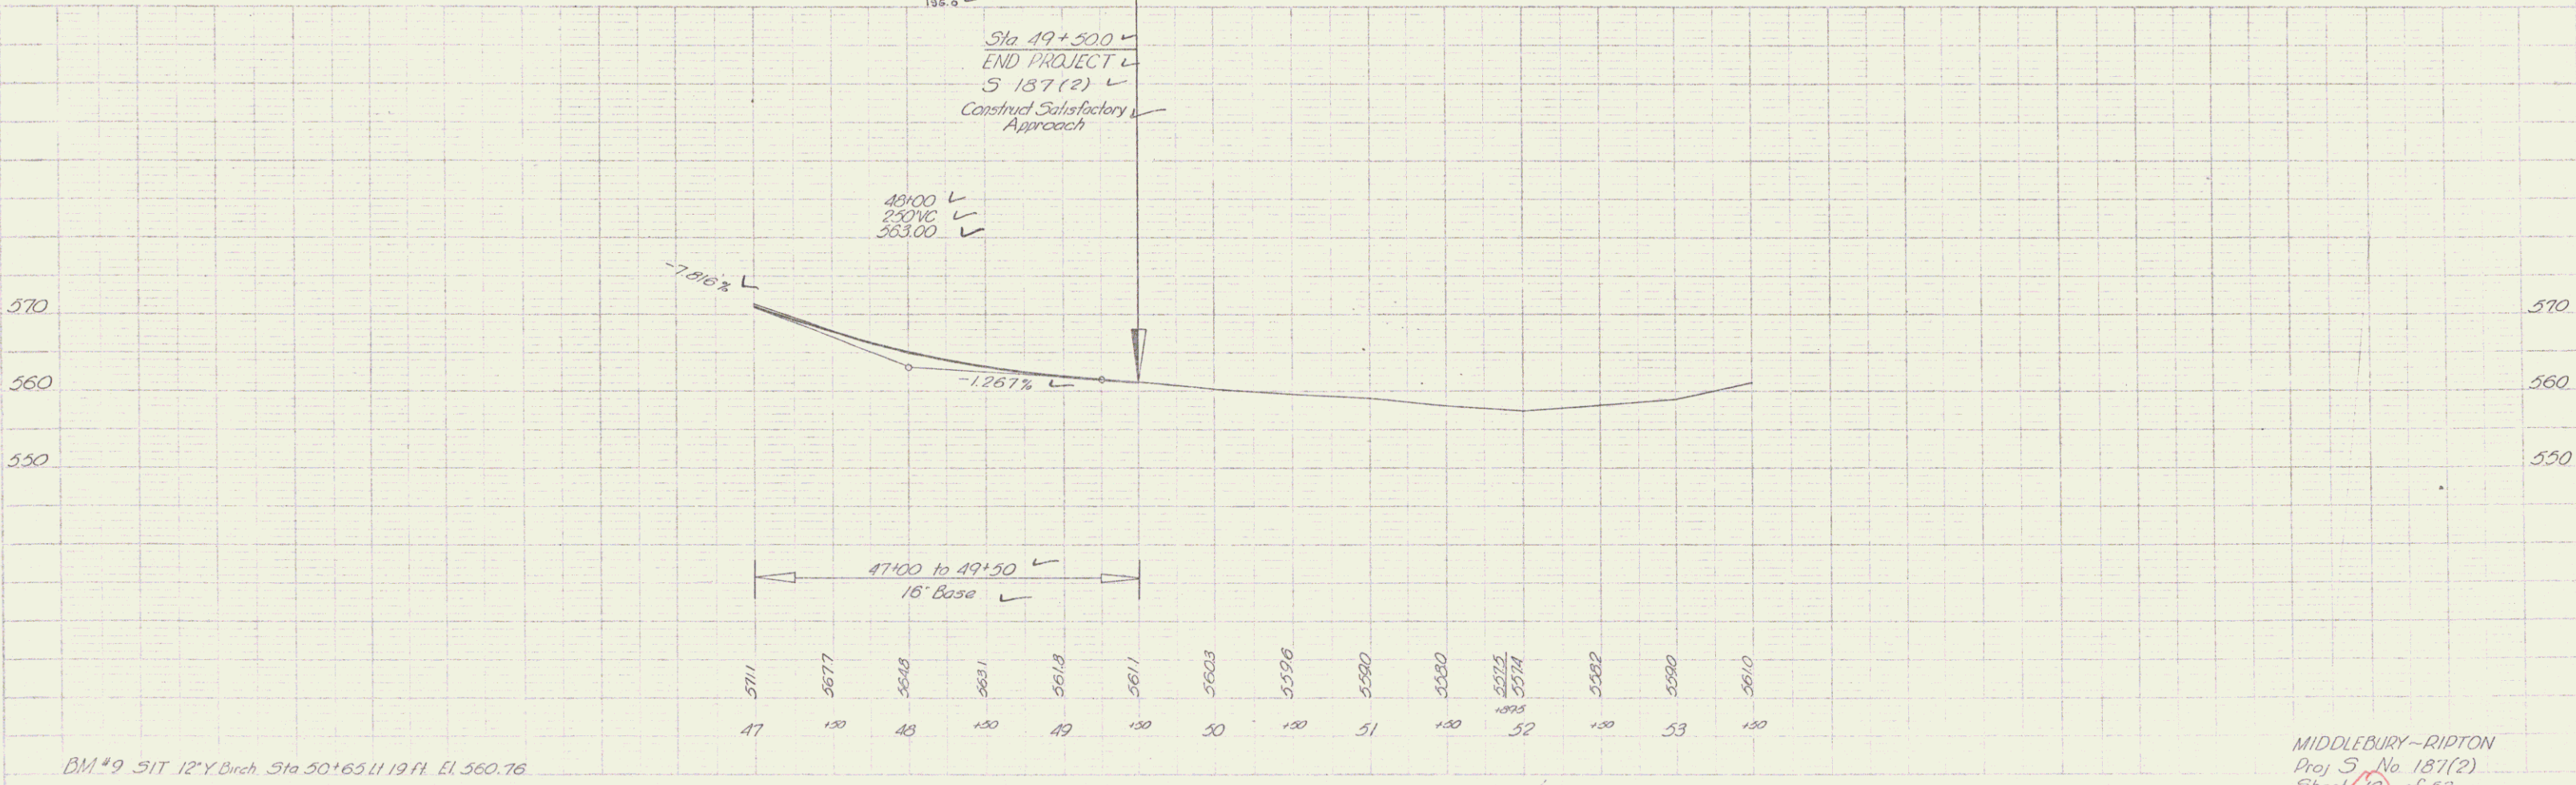

5