

STATE OF VERMONT  
AGENCY OF TRANSPORTATION

TOWN OF RIPTON

LENGTH OF R.O.W. PROJECT 250 FEET

Guard Rail Hvy. Duty Steel Beam w/ St Posts, Type II

13+67 - 14+92 = 125  
R/ 13+15 - 14+17 = 103

SCOTT, DULCIE


R.O.W. PLANS

BEGIN R.O.W. PROJECT MP 4.816  
BMA 6254 STA. 12+50 ☐

END R.O.W. PROJECT  
BMA 6254 STA. 15+00 ☐  
MP 4.913

PLAN	DATE
NO.	
BY	
CHECKED	
DATE	

PROFILE	DATE
NO.	
BY	
CHECKED	
DATE	

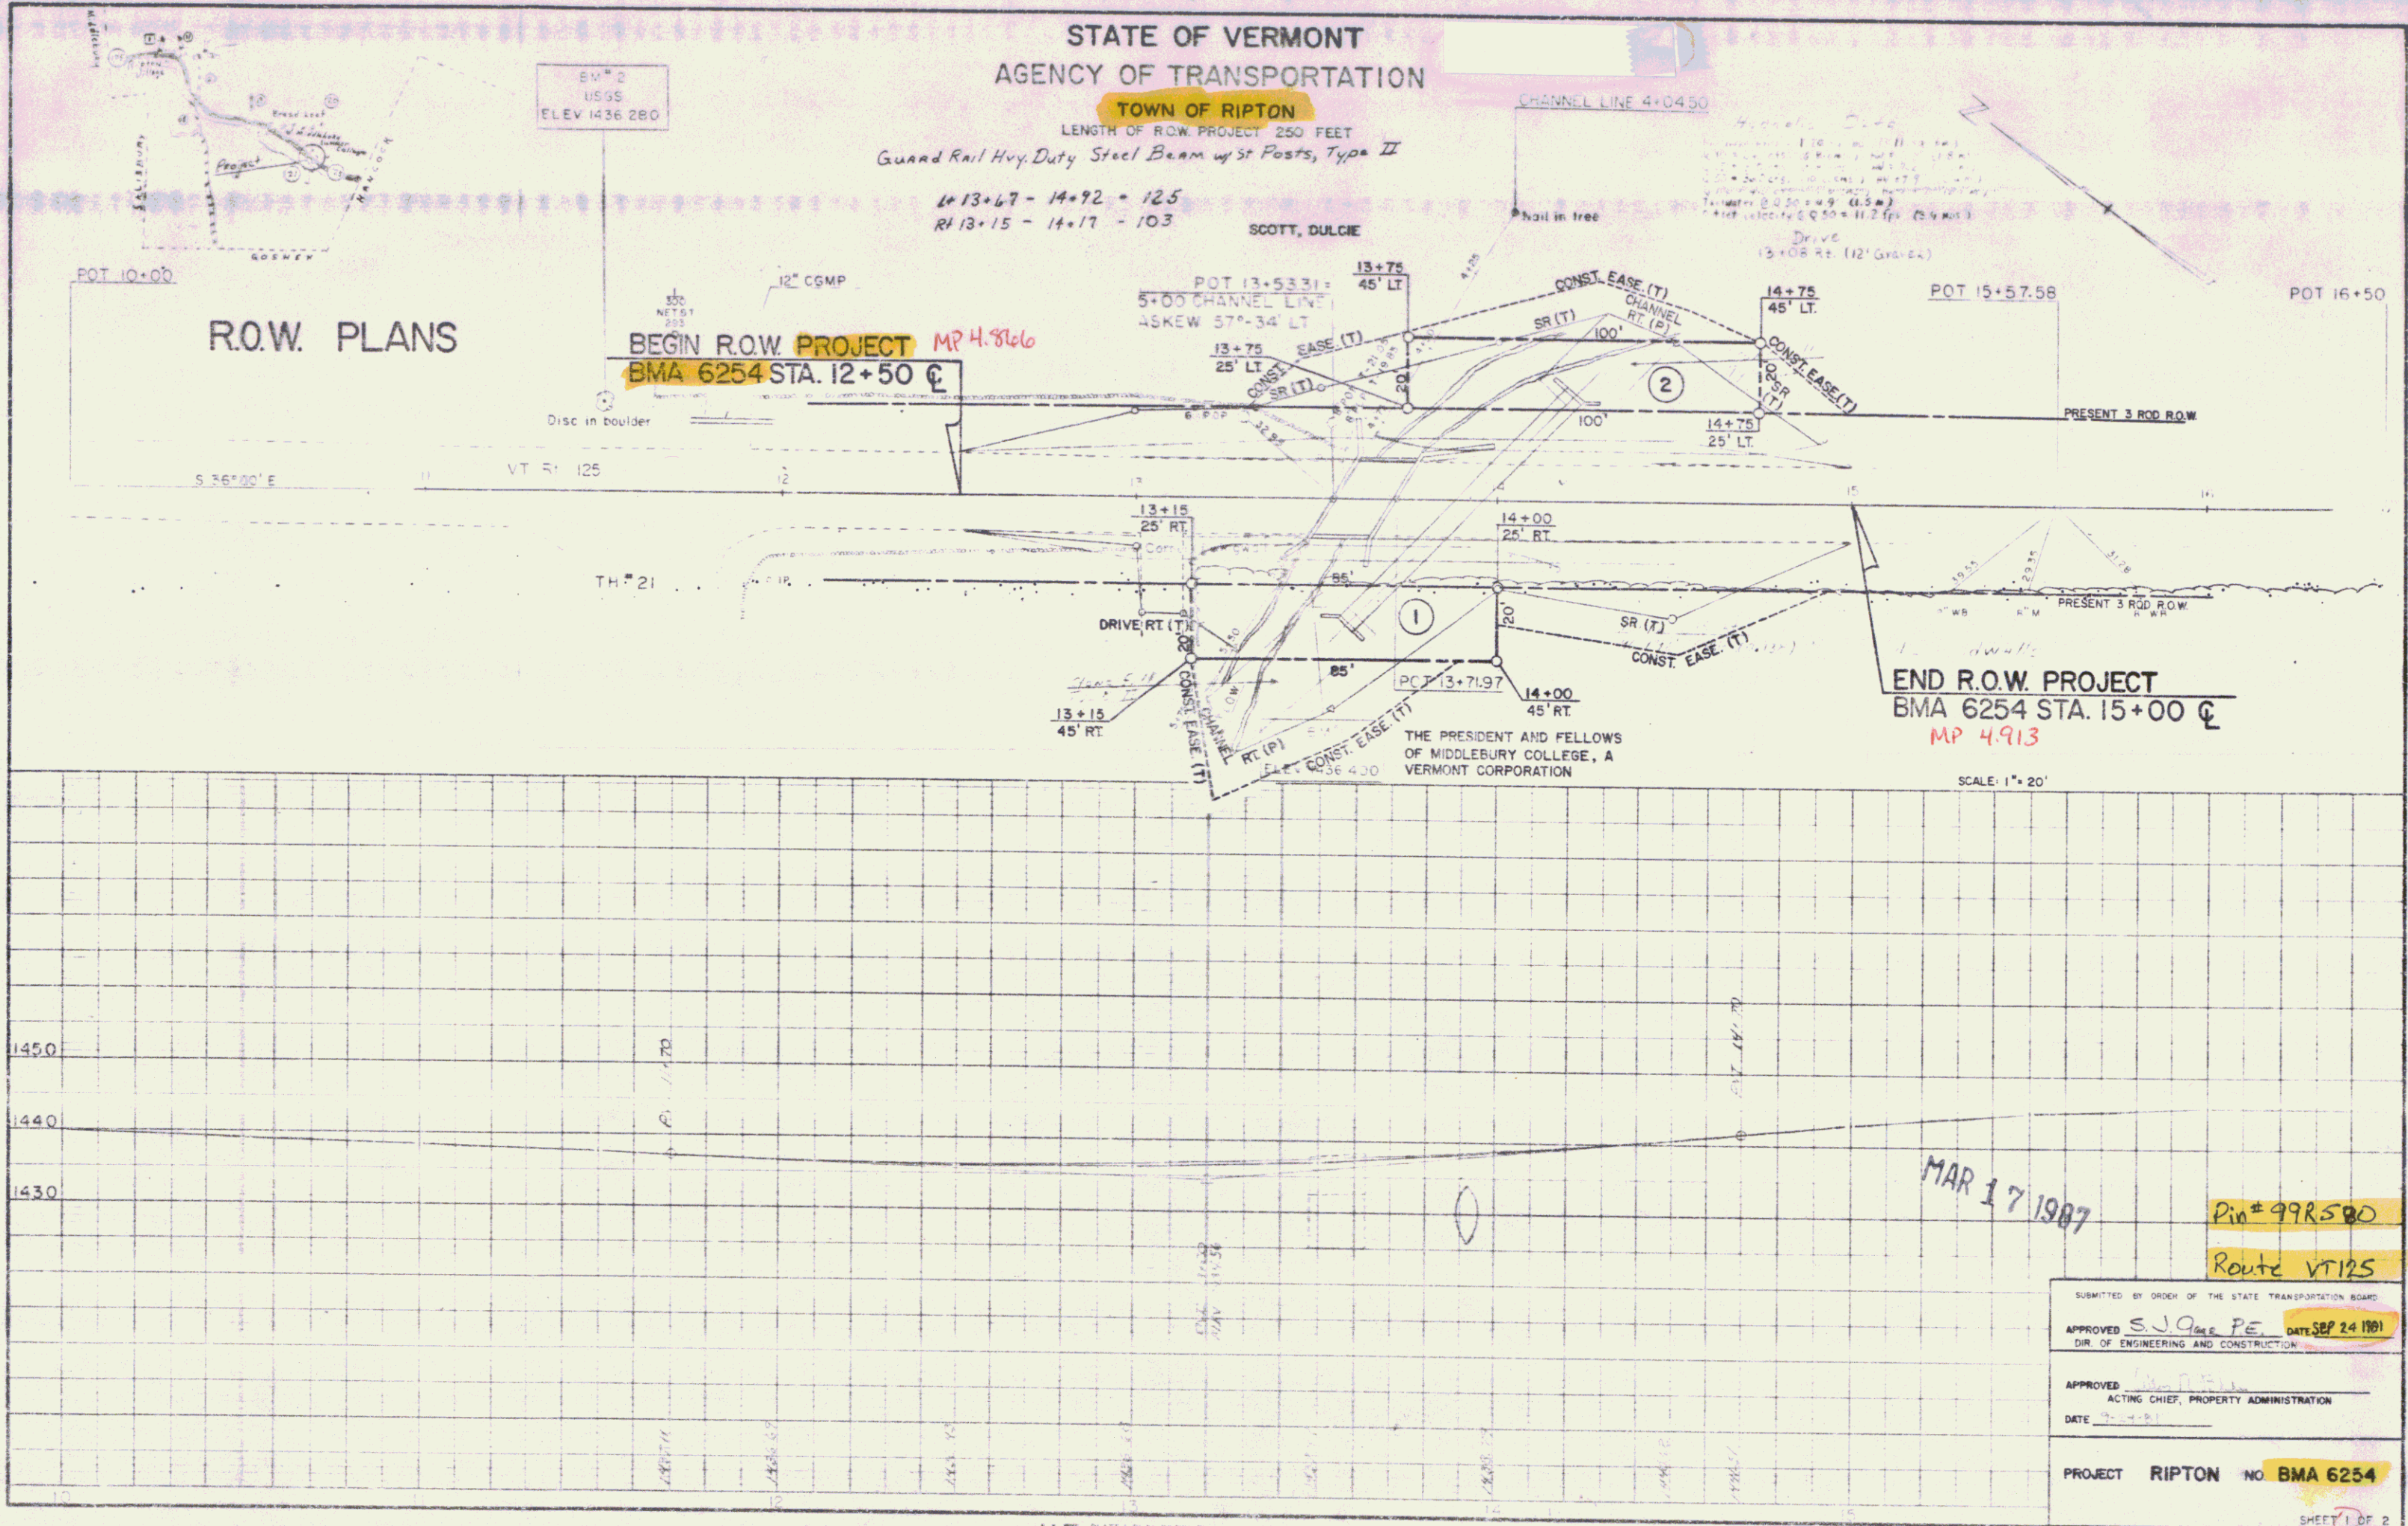

SUBMITTED BY ORDER OF THE STATE TRANSPORTATION BOARD

APPROVED S.J. O'Connell PE DATE SEP 24 1981  
DIR. OF ENGINEERING AND CONSTRUCTION

APPROVED \_\_\_\_\_  
ACTING CHIEF, PROPERTY ADMINISTRATION

DATE \_\_\_\_\_

PROJECT RIPTON NO. BMA 6254

SHEET 1 OF 2