

STATE OF VERMONT
AGENCY OF TRANSPORTATION

TOWN OF RIPTON

LENGTH OF R.O.W. PROJECT 250 FEET

Guard Rail Hvy. Duty Steel Beam w/ St Posts, Type II

13+67 - 14+92 = 125
RI 13+15 - 14+17 = 103

SCOTT, DULCIE


R.O.W. PLANS

BEGIN R.O.W. PROJECT MP 4.816
BMA 6254 STA. 12+50 ☐

END R.O.W. PROJECT
BMA 6254 STA. 15+00 ☐
MP 4.913

PLAN	DATE
NO.	

PROFILE	DATE
NO.	

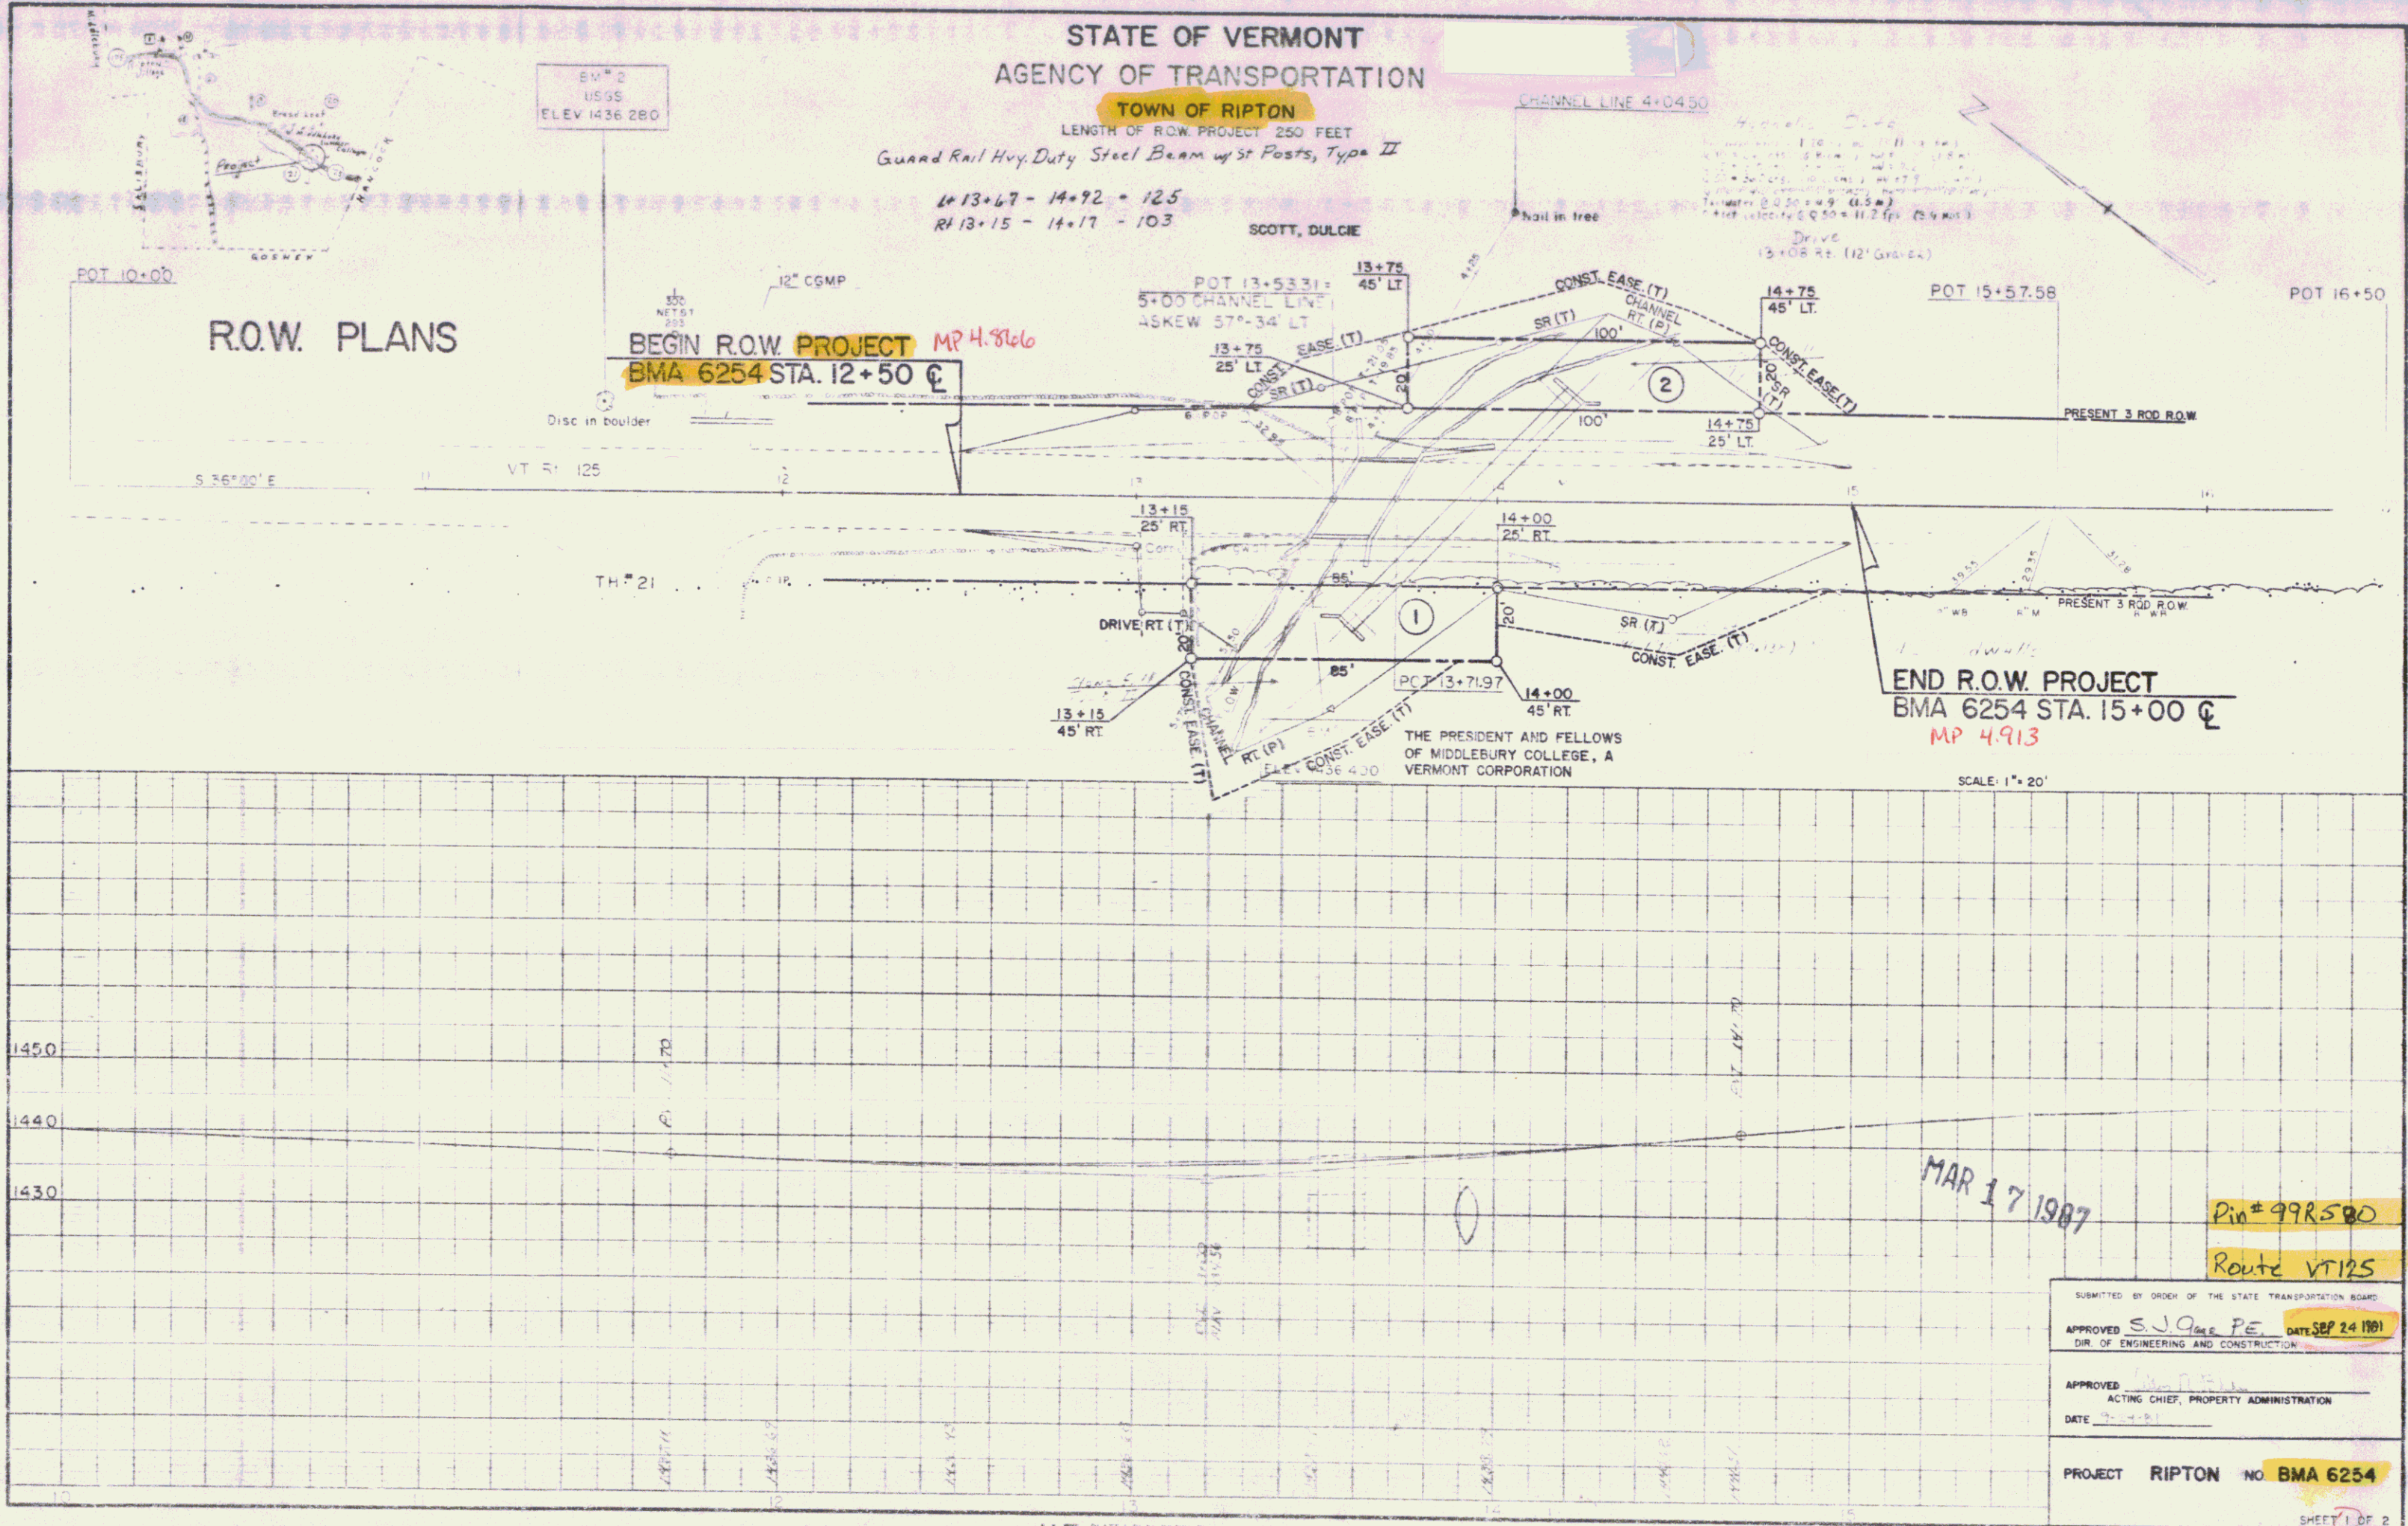

MAR 17 1987

Pin# 99R580
Route VT125

SUBMITTED BY ORDER OF THE STATE TRANSPORTATION BOARD
APPROVED S.J. O'Connell PE DATE SEP 24 1981
DIR. OF ENGINEERING AND CONSTRUCTION

APPROVED _____
ACTING CHIEF, PROPERTY ADMINISTRATION
DATE _____

PROJECT RIPTON NO. BMA 6254

SHEET 1 OF 2