


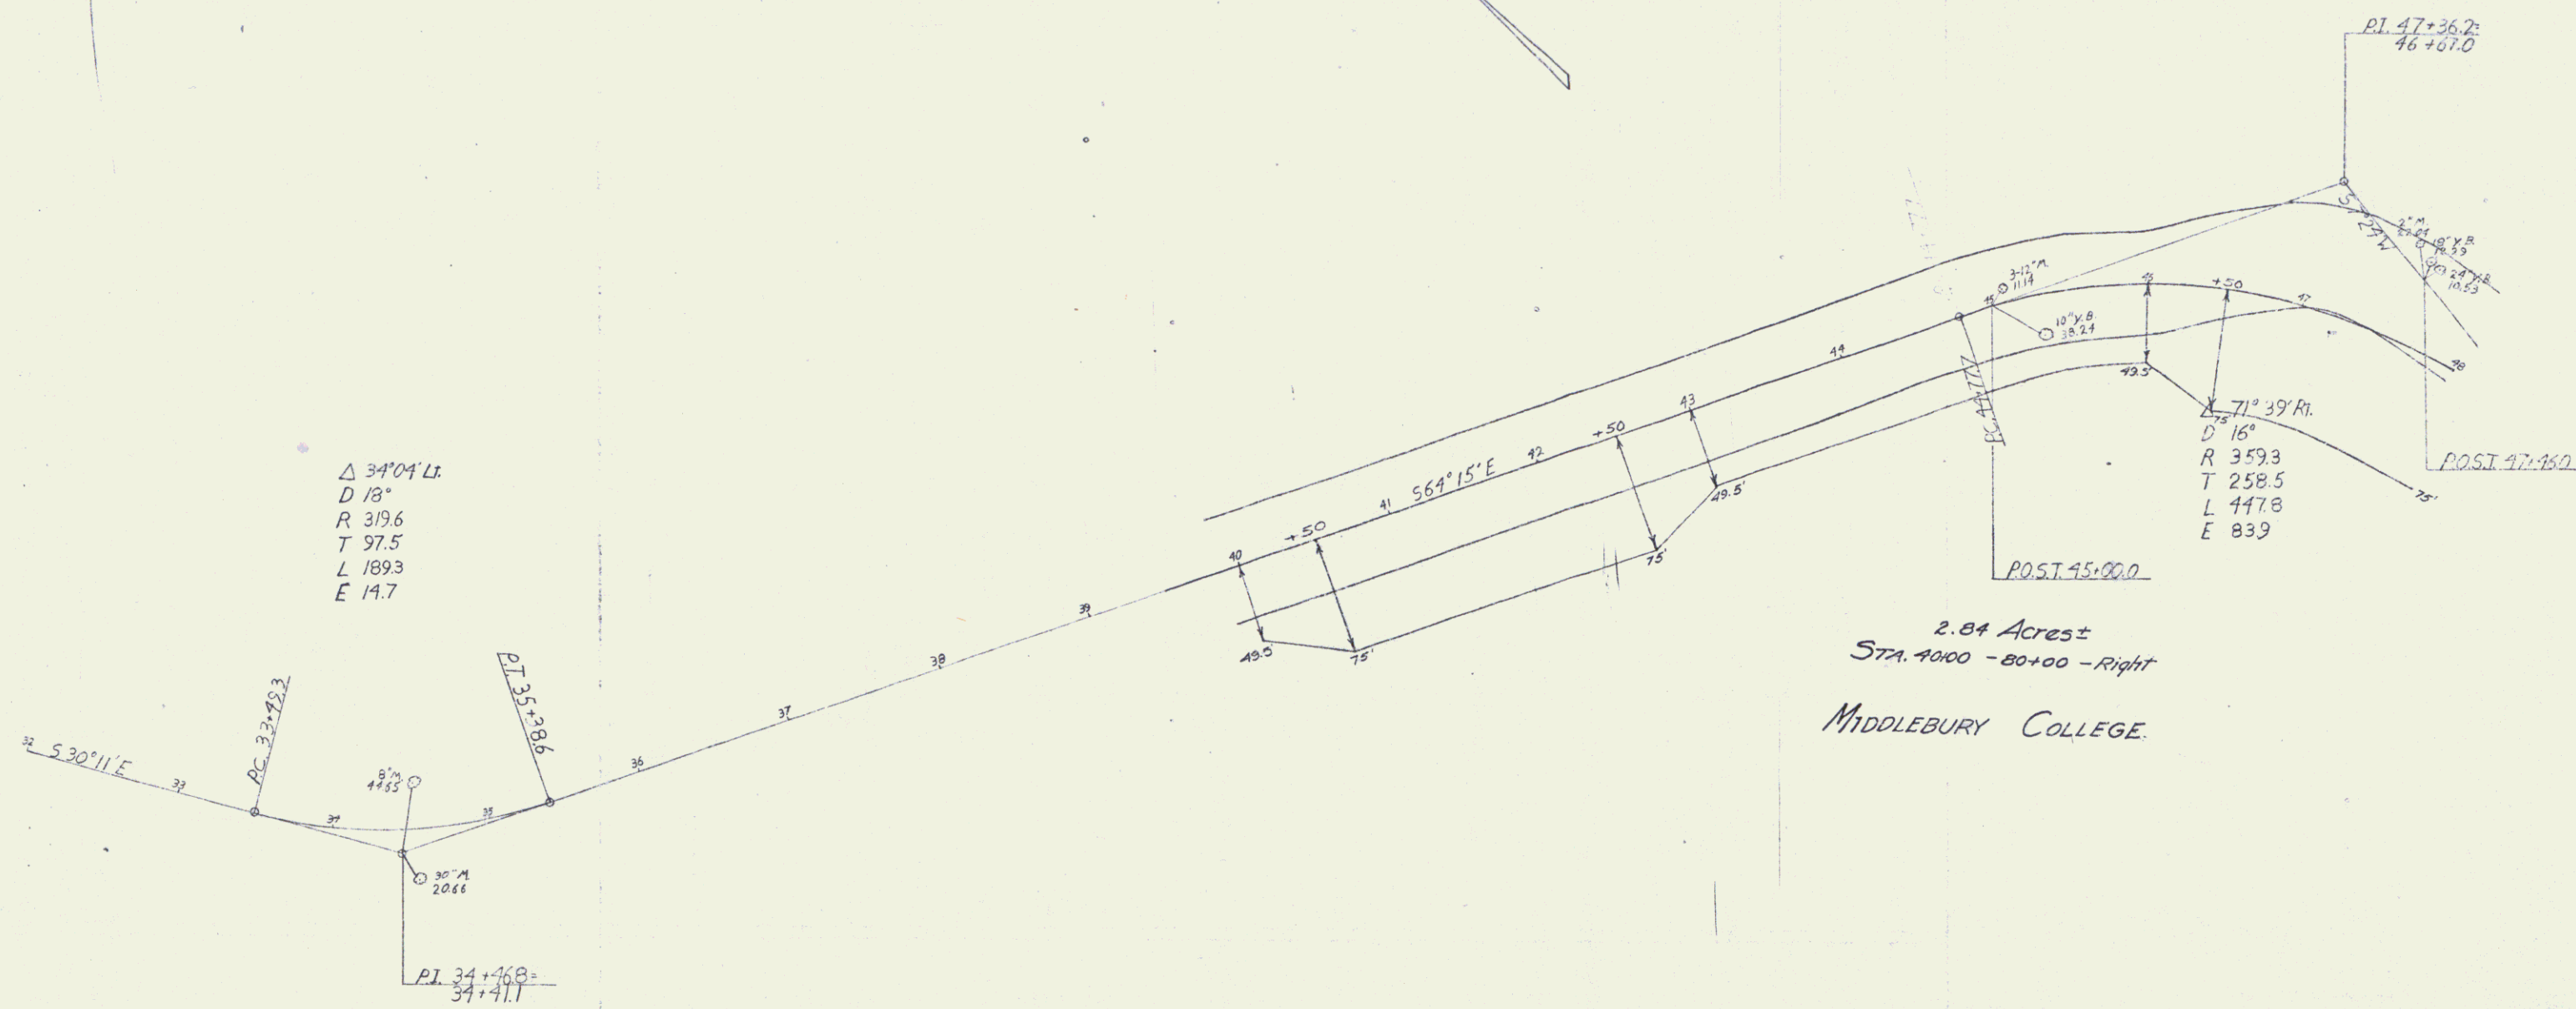

57187(M)
 HANCOCK Dist 5
 Levels by Palmer 7-56
 Plotted by Grant 8-56
 Traced by Grant
 SHEET 3