


9-55
 12-55
 Palmer
 No. 1
 142

9-55
 12-55
 Palmer
 No. 1
 142

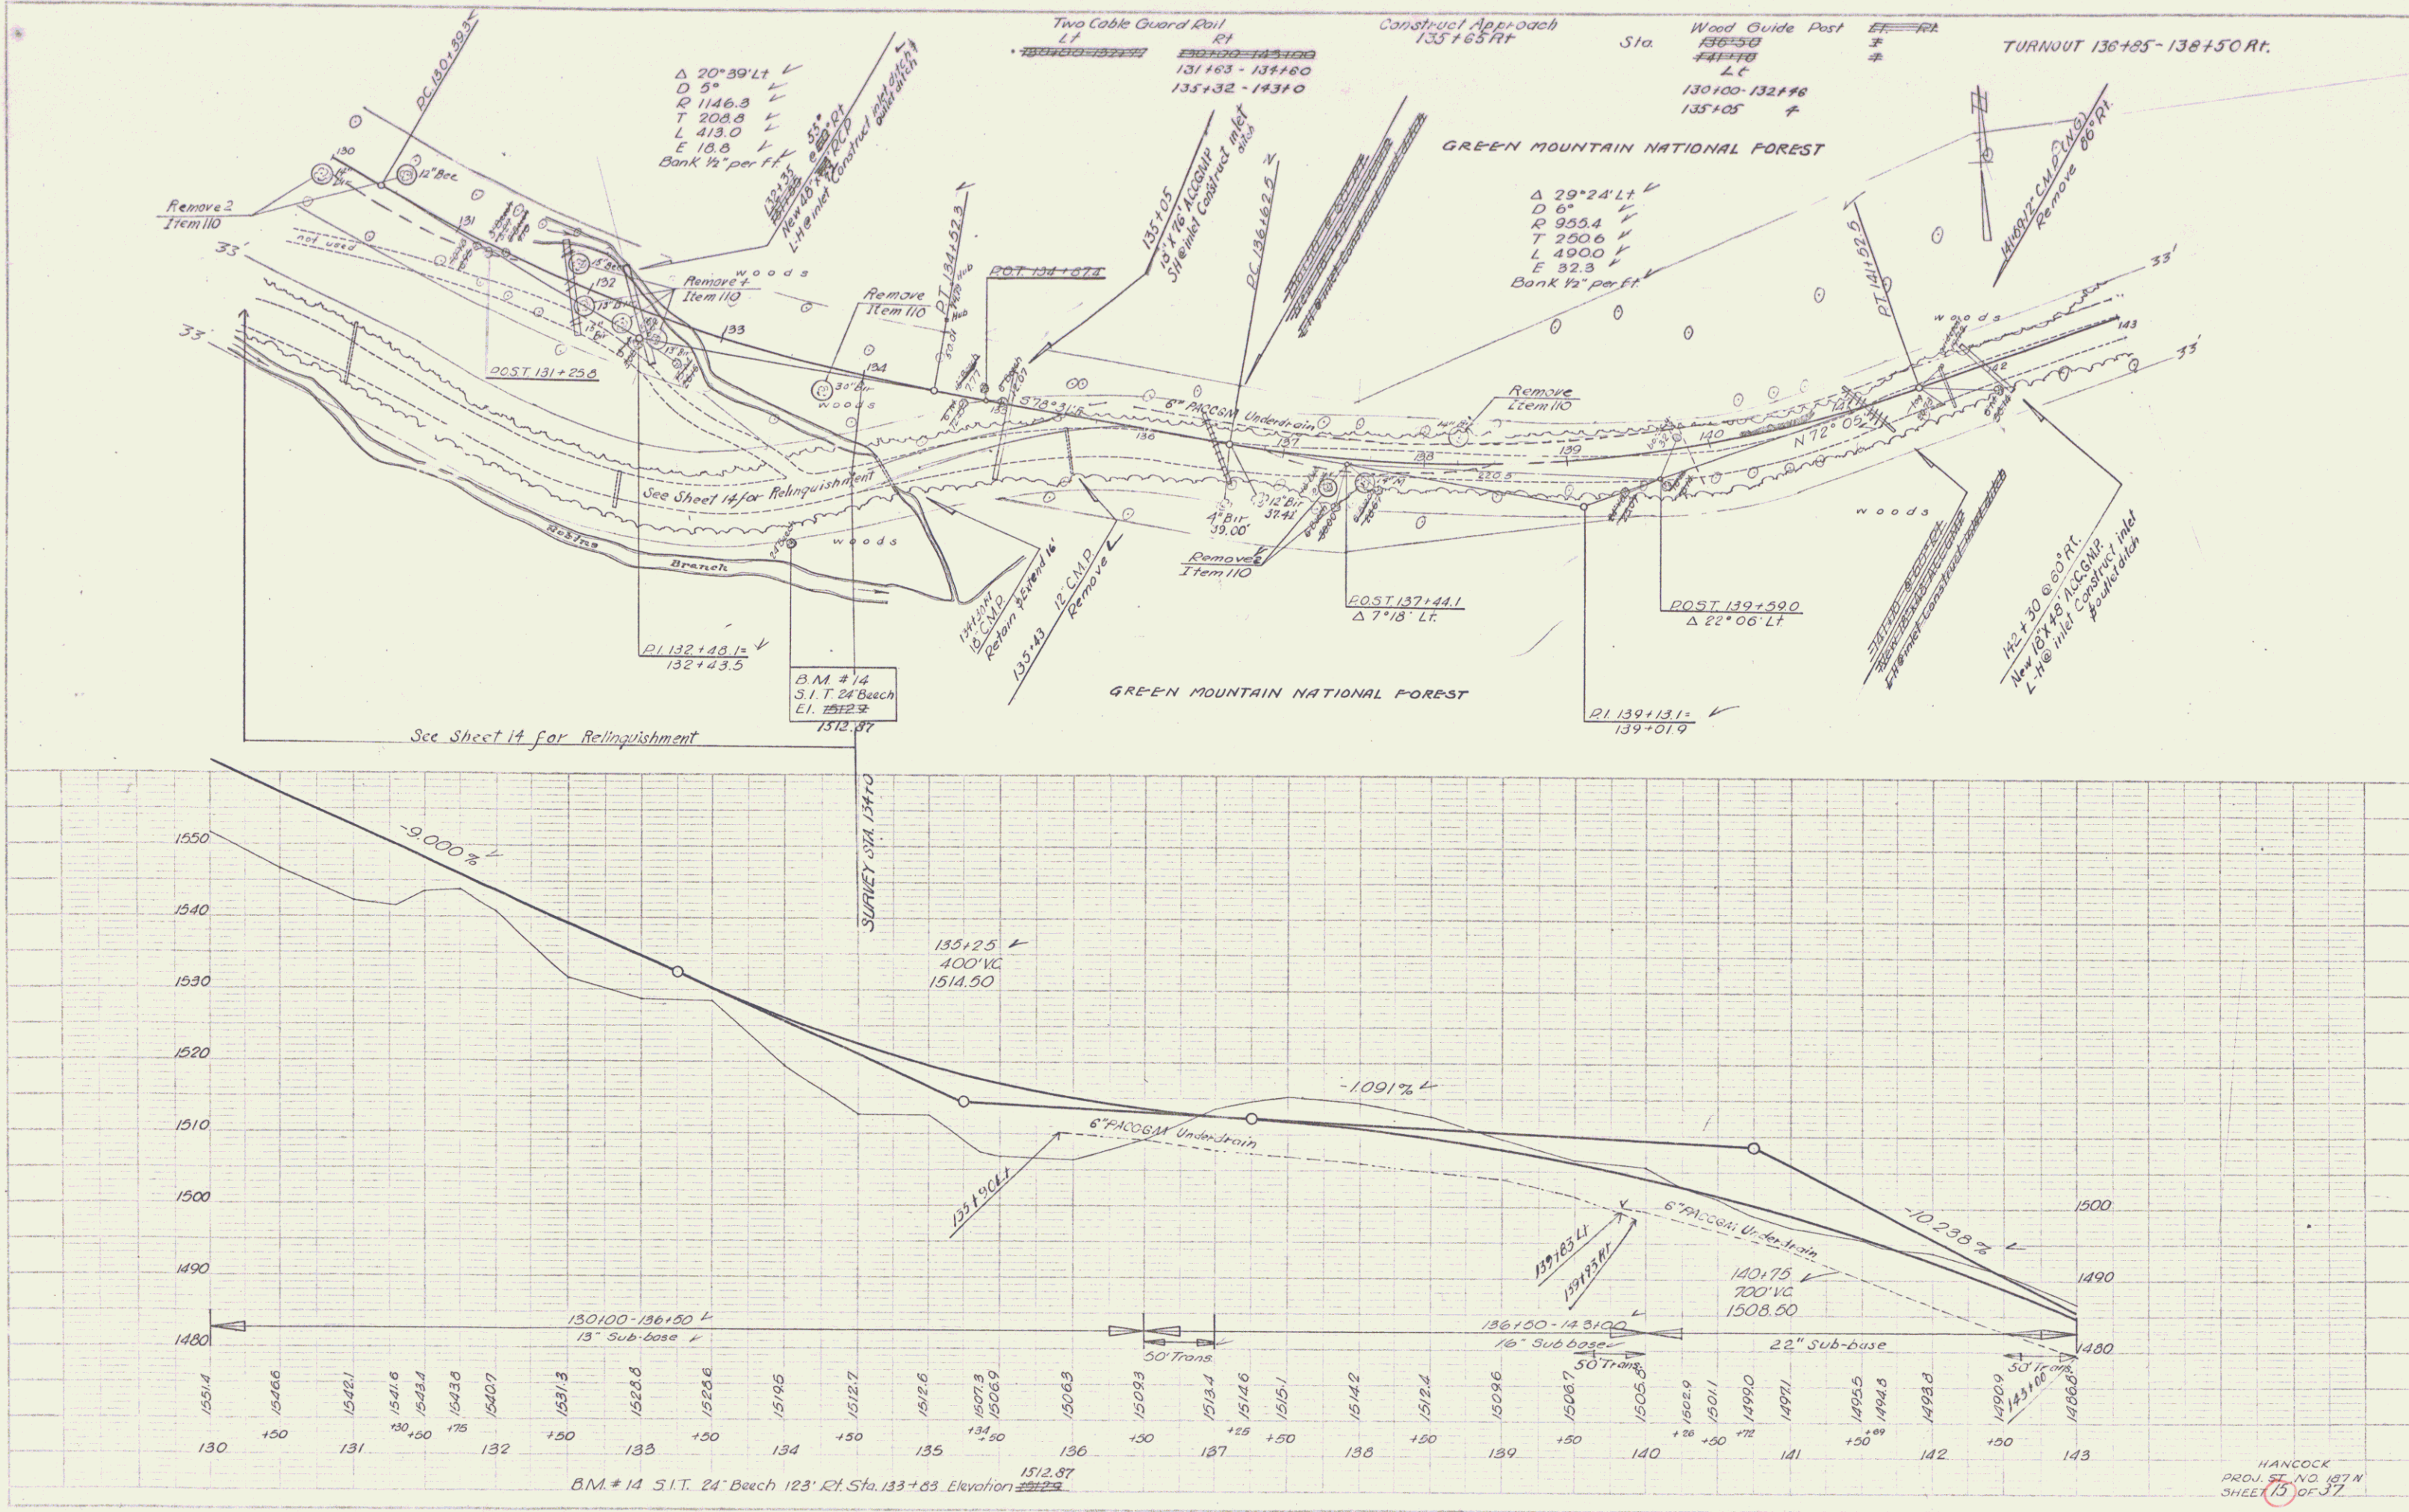

HANCOCK
 PROJ. NO. 87N
 SHEET 15 OF 37