
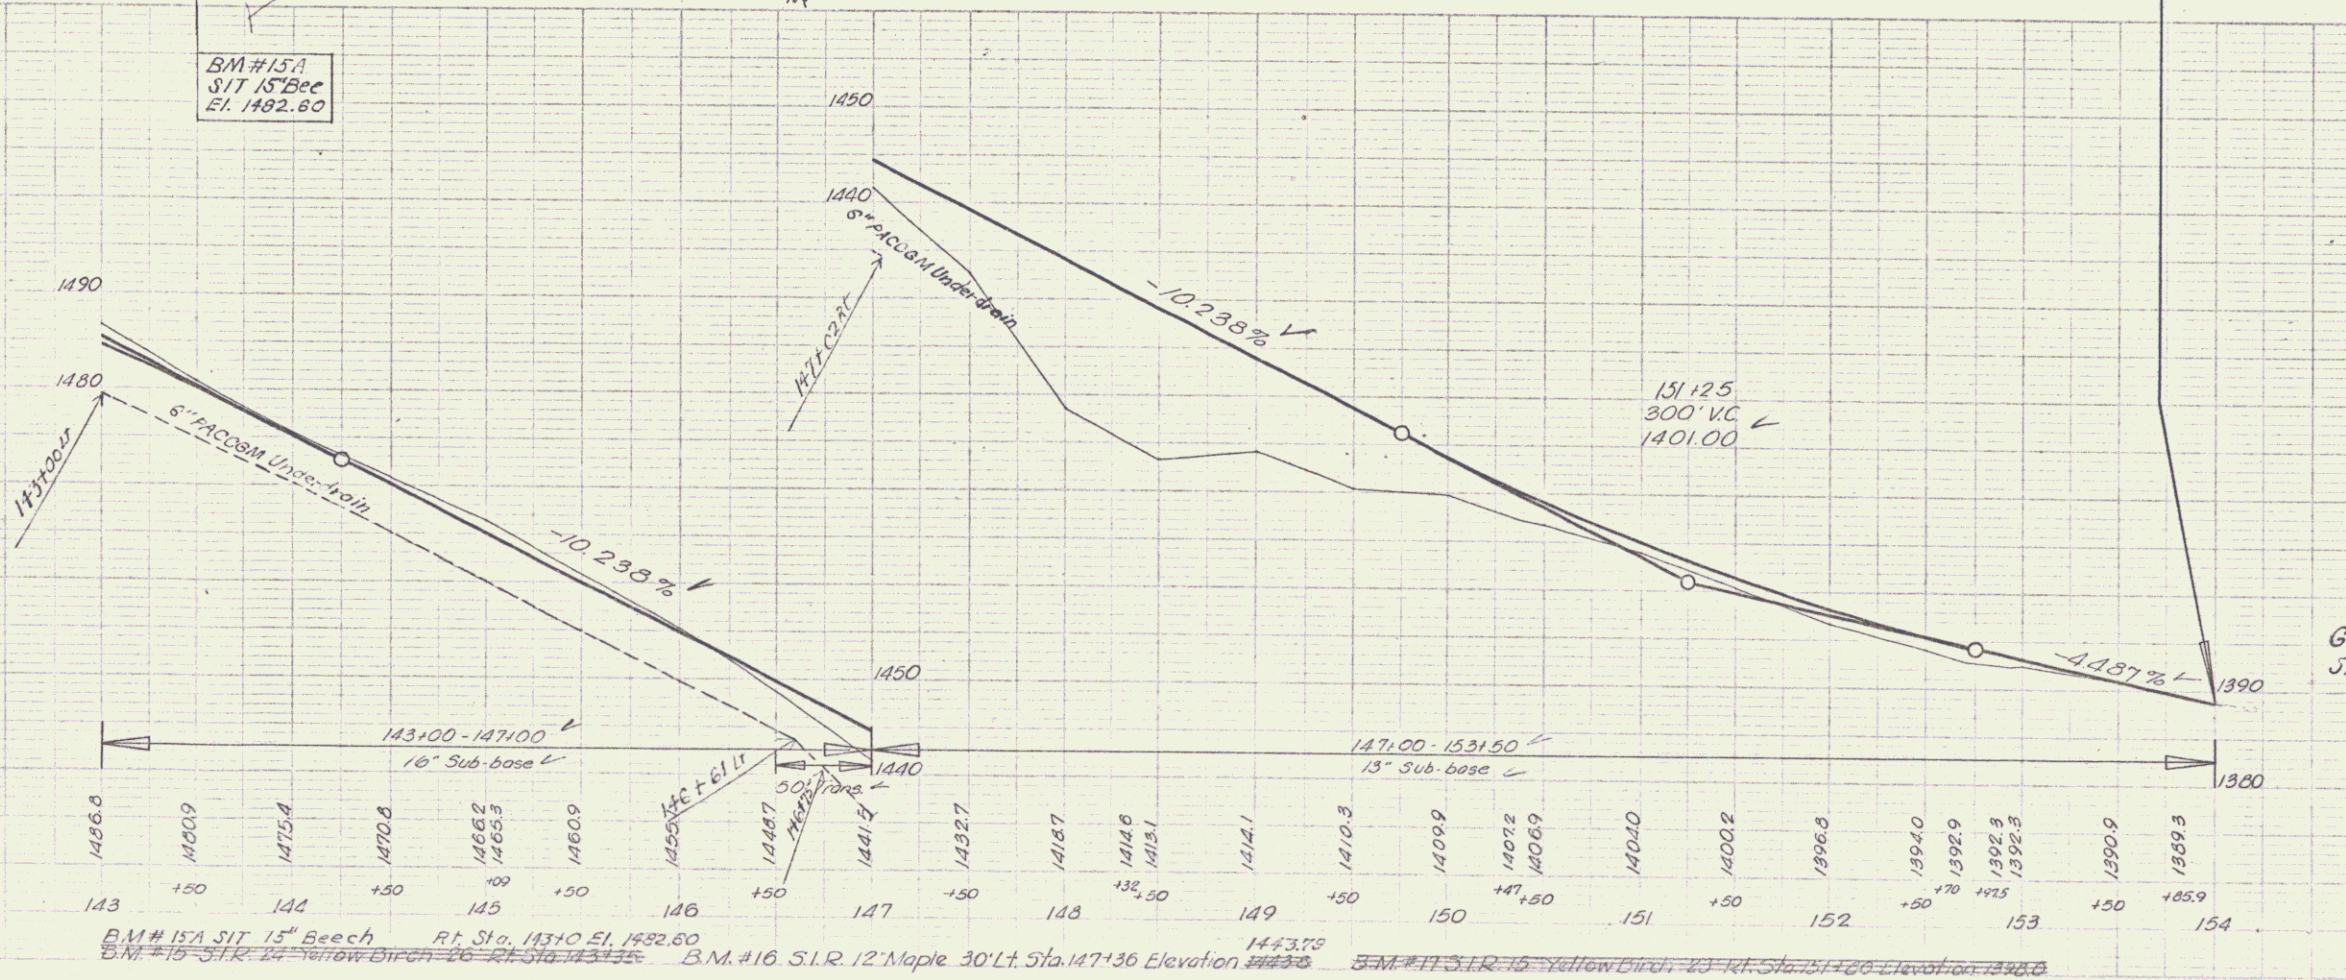


9-56
 10-56
 12-56
 R. W. RAYNER
 Surveyor
 No. 1111
 State of New Hampshire
 12-56
 12-56
 R. W. RAYNER
 Surveyor
 No. 1111
 State of New Hampshire
 12-56
 12-56

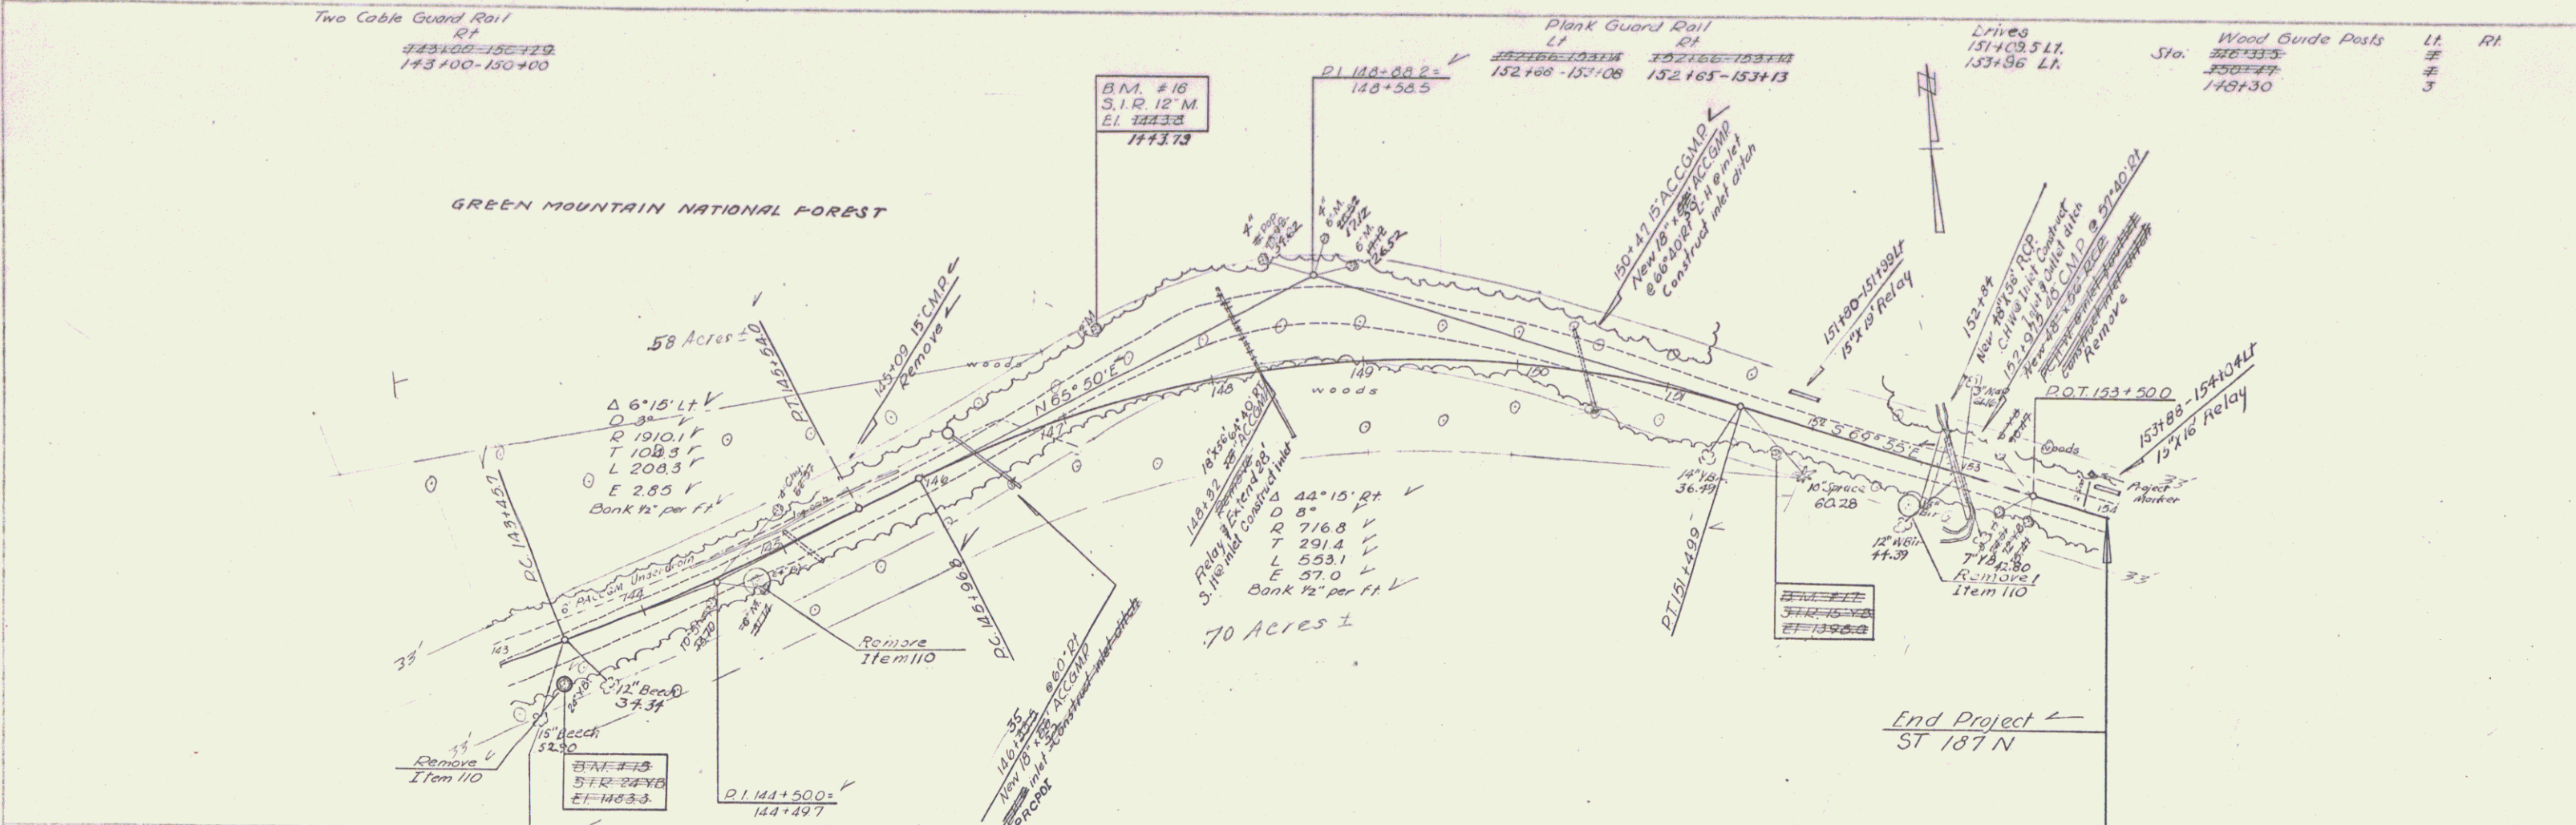

HANCOCK
 PROJ. NO. 187 N
 SHEET 16 OF 31