
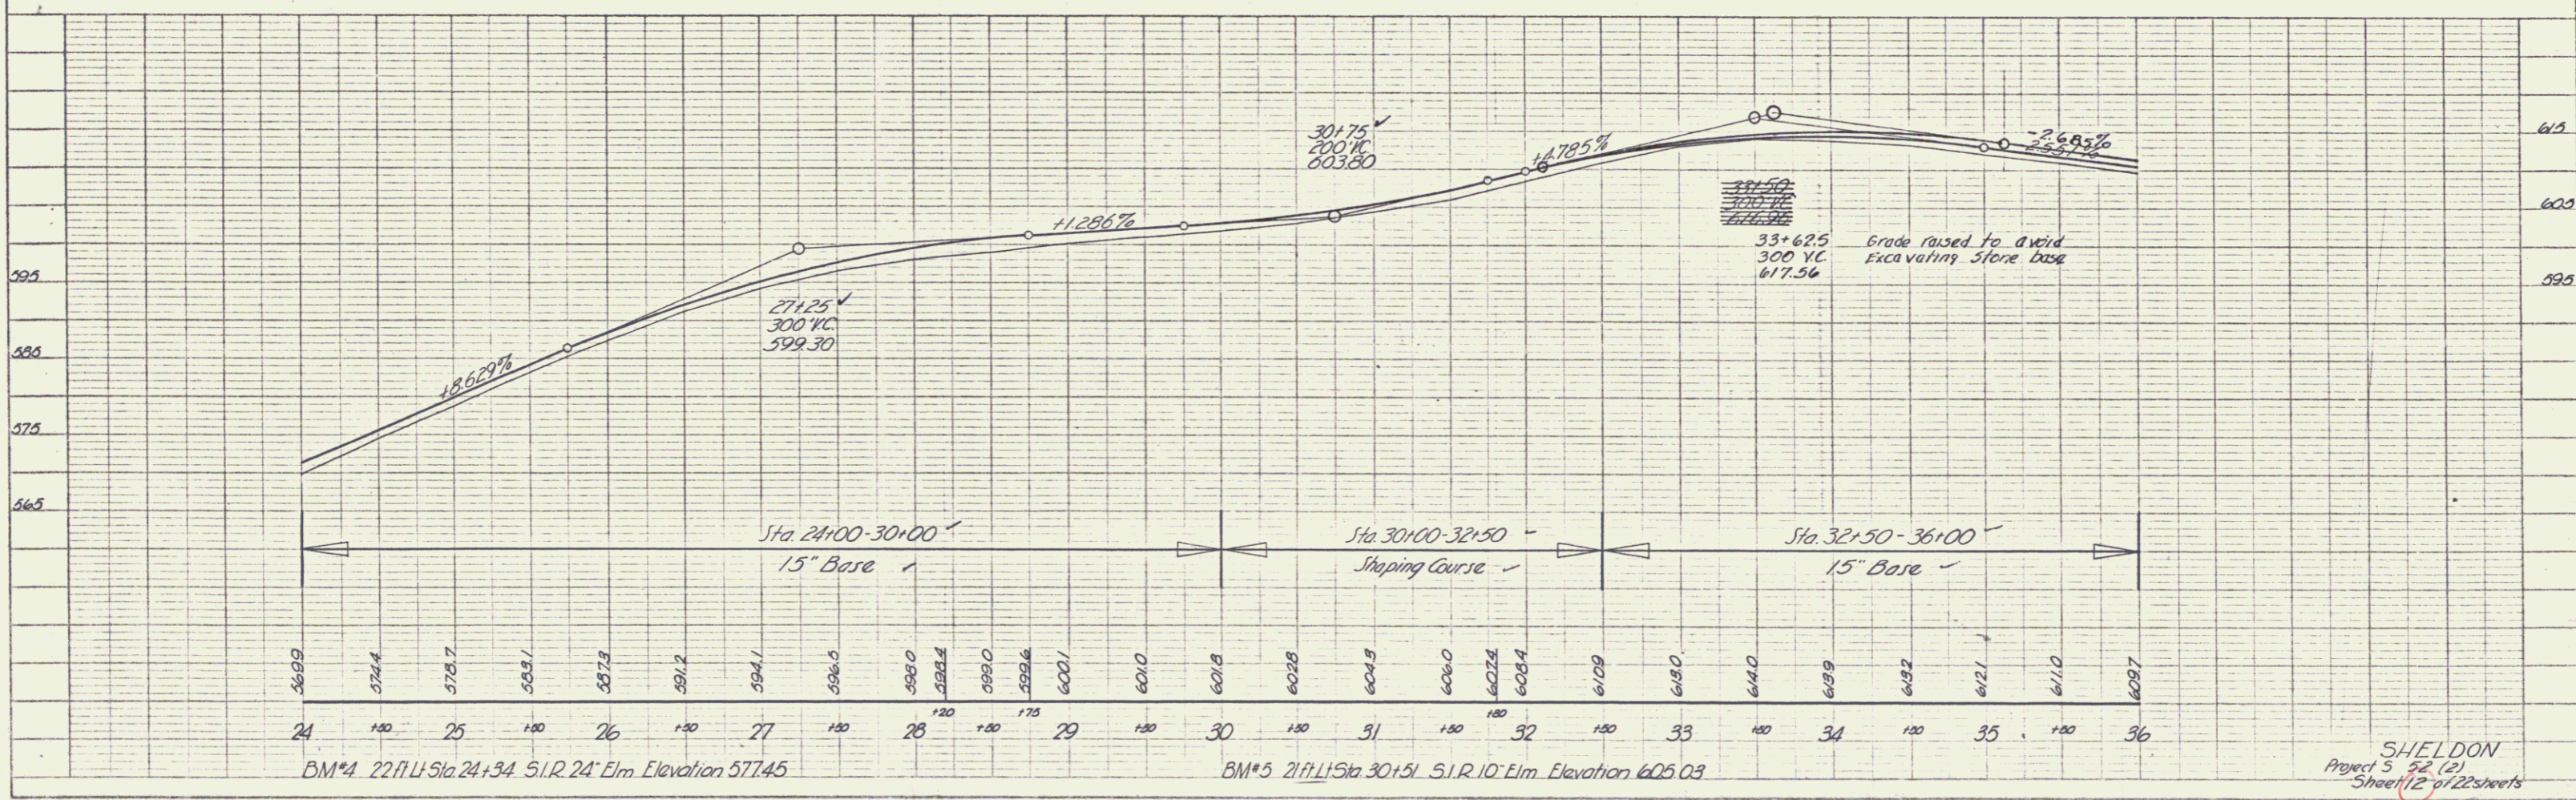


PLAN	REVISED	DATE	BY
PLANNED	1/28	1917	Hurlby
NOTED	1/28	1917	Hurlby
REVISION			
NO.			

PROFILE	REVISED	DATE	BY
PLANNED	1/28	1917	Hurlby
NOTED	1/28	1917	Hurlby
REVISION			
NO.			

Contract Drives	
33+50	27100
31+80	31180

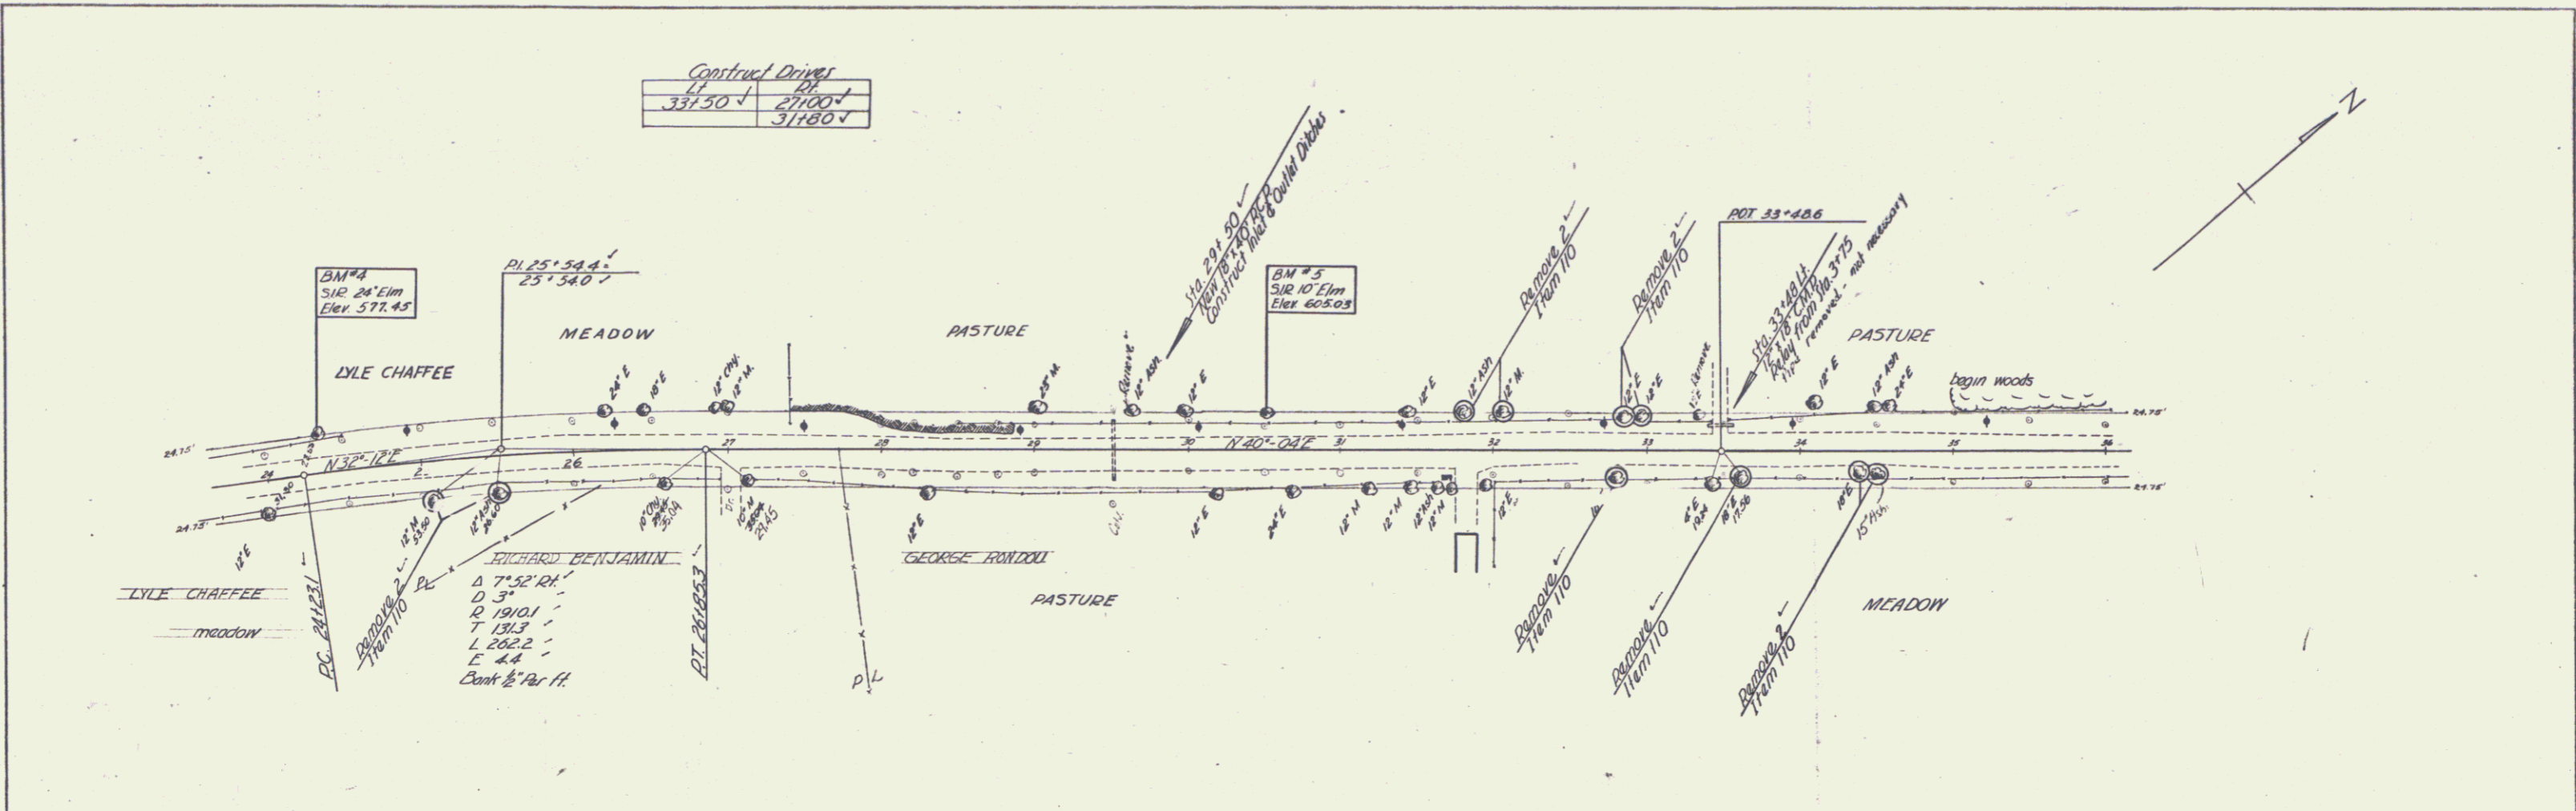

SHIELDON  
Project 5 52 (2)  
Sheet 12 of 22 sheets