


PLAN	DATE	BY
REVISED	2/25	Lavin
NOTE BOOK	REVISIONS CHECKED	Hurley
NO.		

PROFILE	DATE	BY
REVISED	2/25	Lavin
NOTE BOOK	REVISIONS CHECKED	Hurley
NO.		

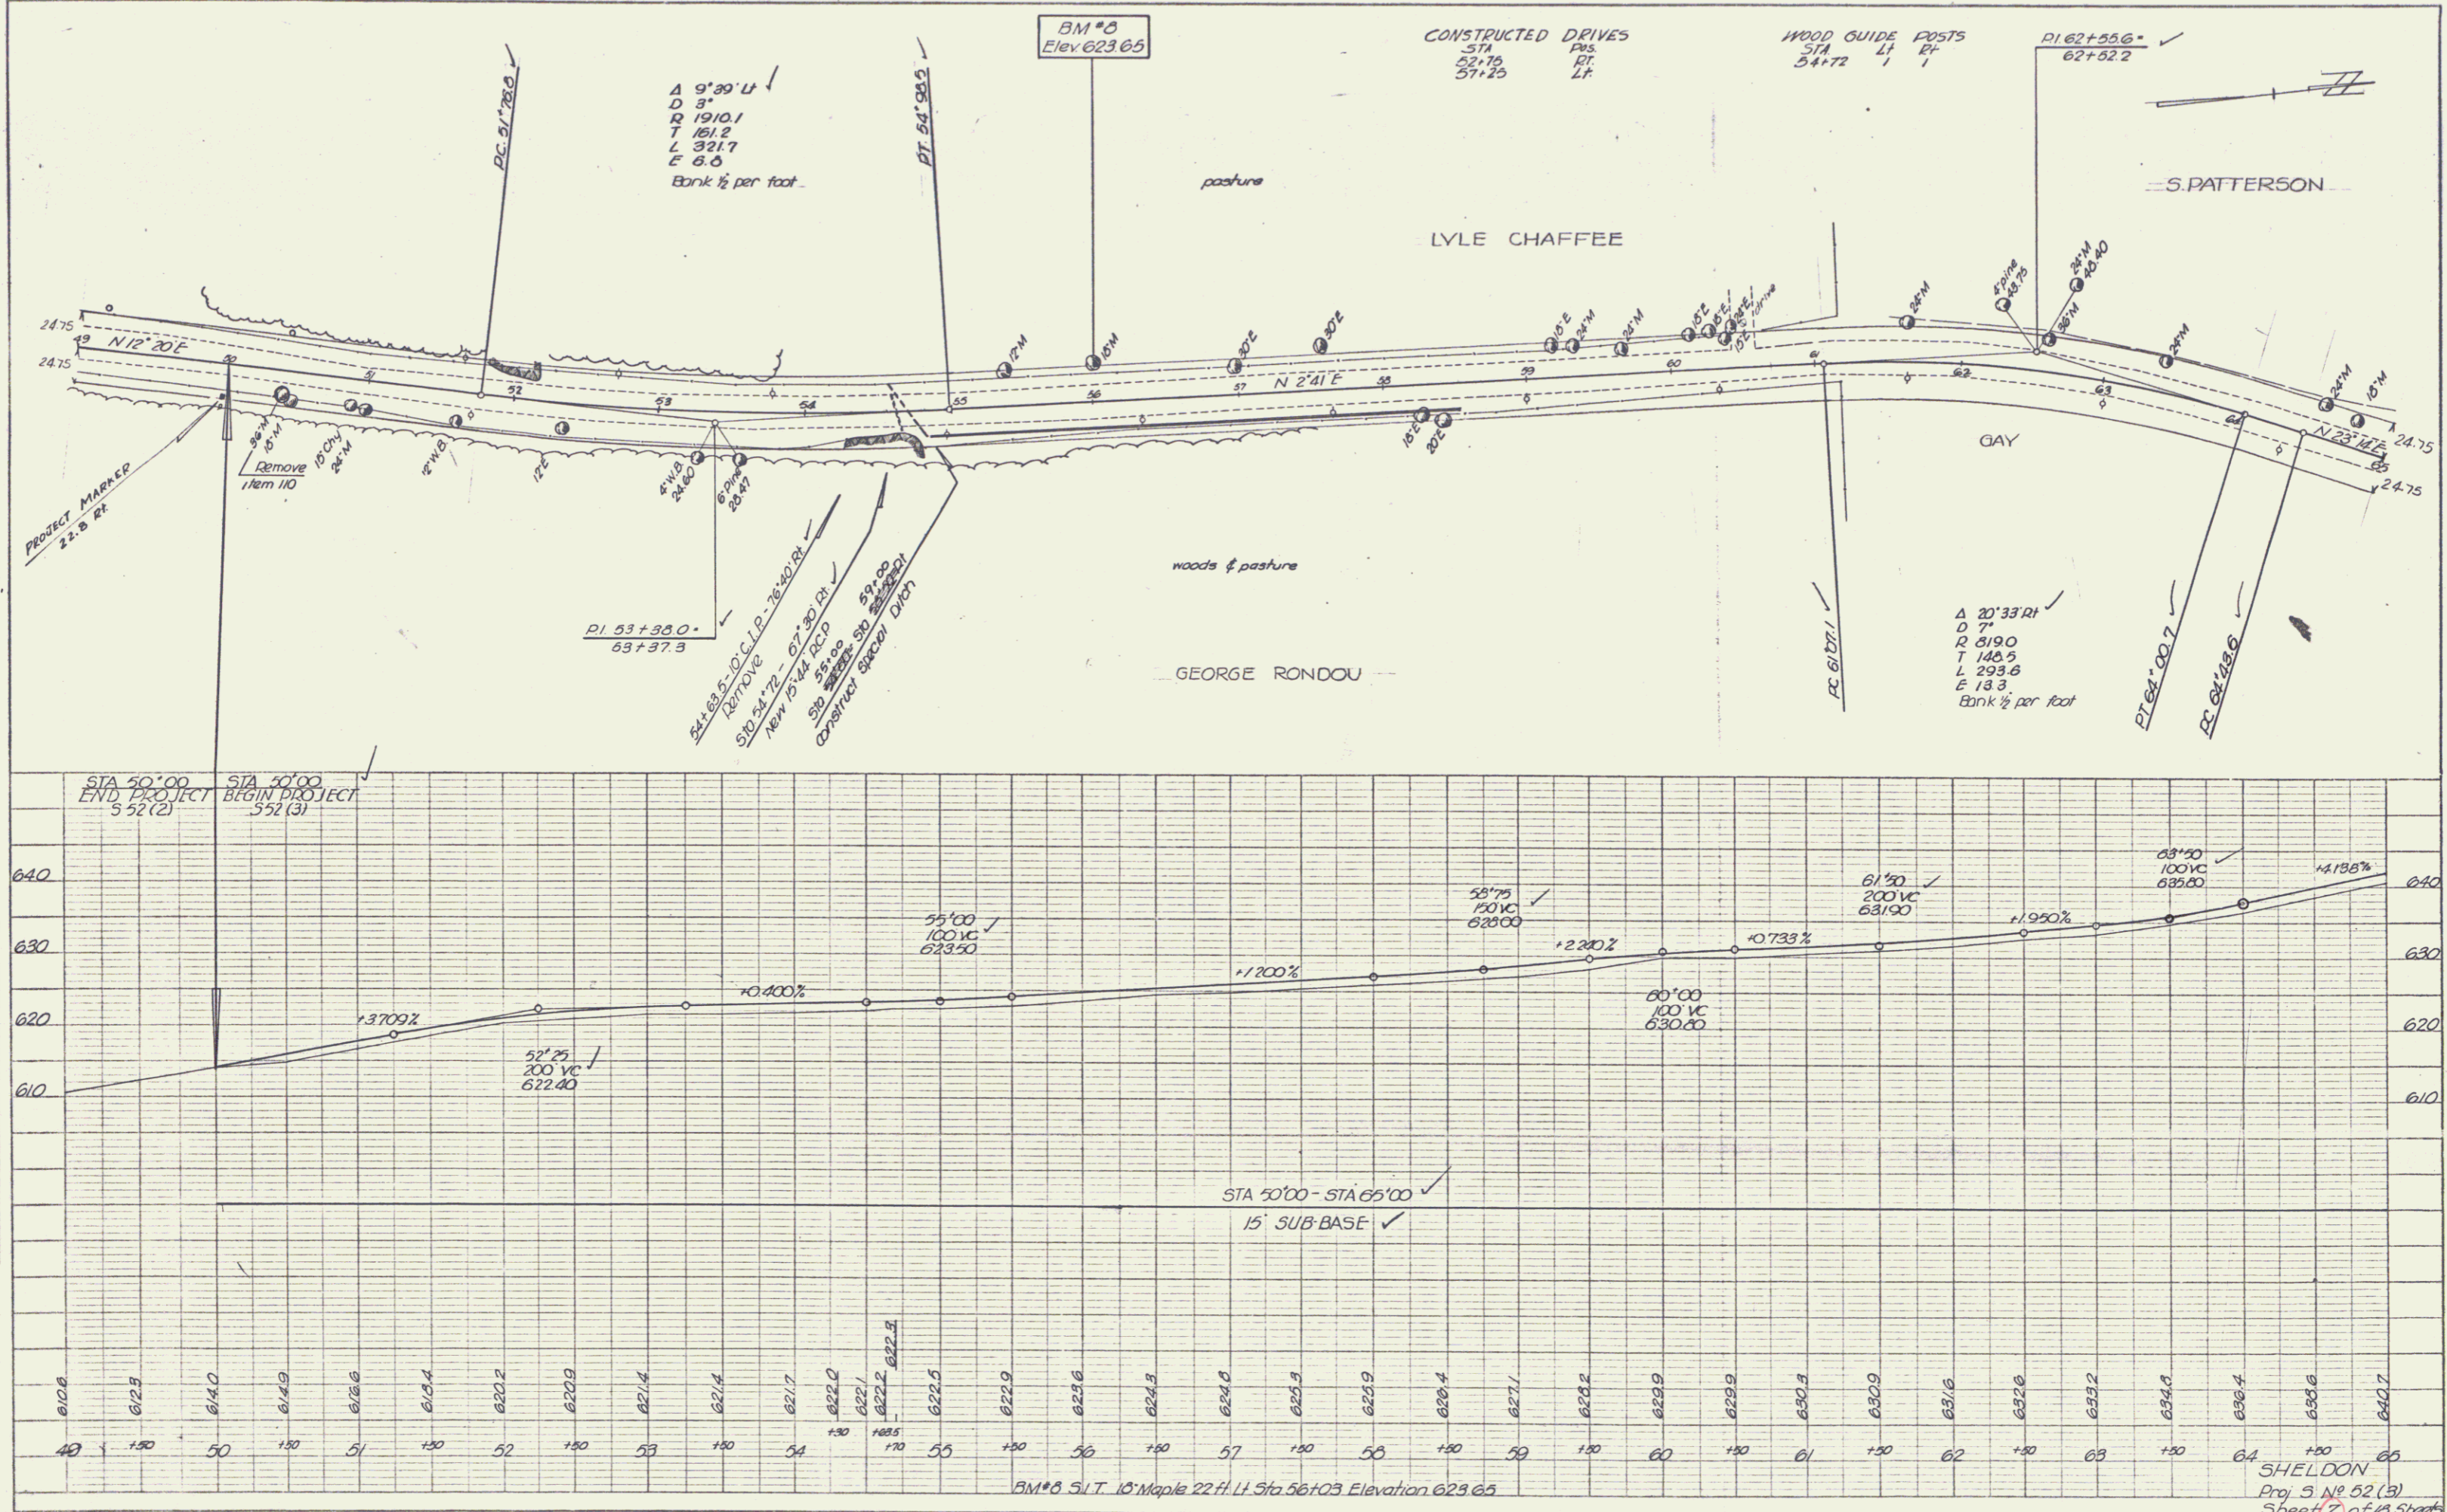

BM #0 S.I.T. 10' Maple 22 ft. Lt Sta 56+03 Elevation 623.65

SHELDON
Proj. 5 No 52 (3)
Sheet 7 of 13 Sheets

PLATE 11 - PLAN-PROFILE - P.E. & S. DIVISION
REVISED 2/25/00
P.E. & S. DIVISION