

PLAN  
 SHEET NO. 10110  
 DATE 10/10/10  
 BY [Signature]  
 CHECKED [Signature]  
 IN CHARGE [Signature]

PROFILE  
 SHEET NO. 10110  
 DATE 10/10/10  
 BY [Signature]  
 CHECKED [Signature]  
 IN CHARGE [Signature]

WOOD GUIDE POSTS  
 STA. LT. RT.  
 72+68-80+04 47  
 73+85 1  
 78+50 1

Construct Drives  
 STA. LT. RT.  
 67+30 x x  
 72+23 x x  
 72+70 x x  
 67+25 x x  
 72+25 x x  
 77+25 x x  
 77+75 x x

Δ 2' 09" LI  
 D 0' 15"  
 R 229' 18.3  
 T 430.0  
 L 680.0  
 E 4.1  
 to rd tank

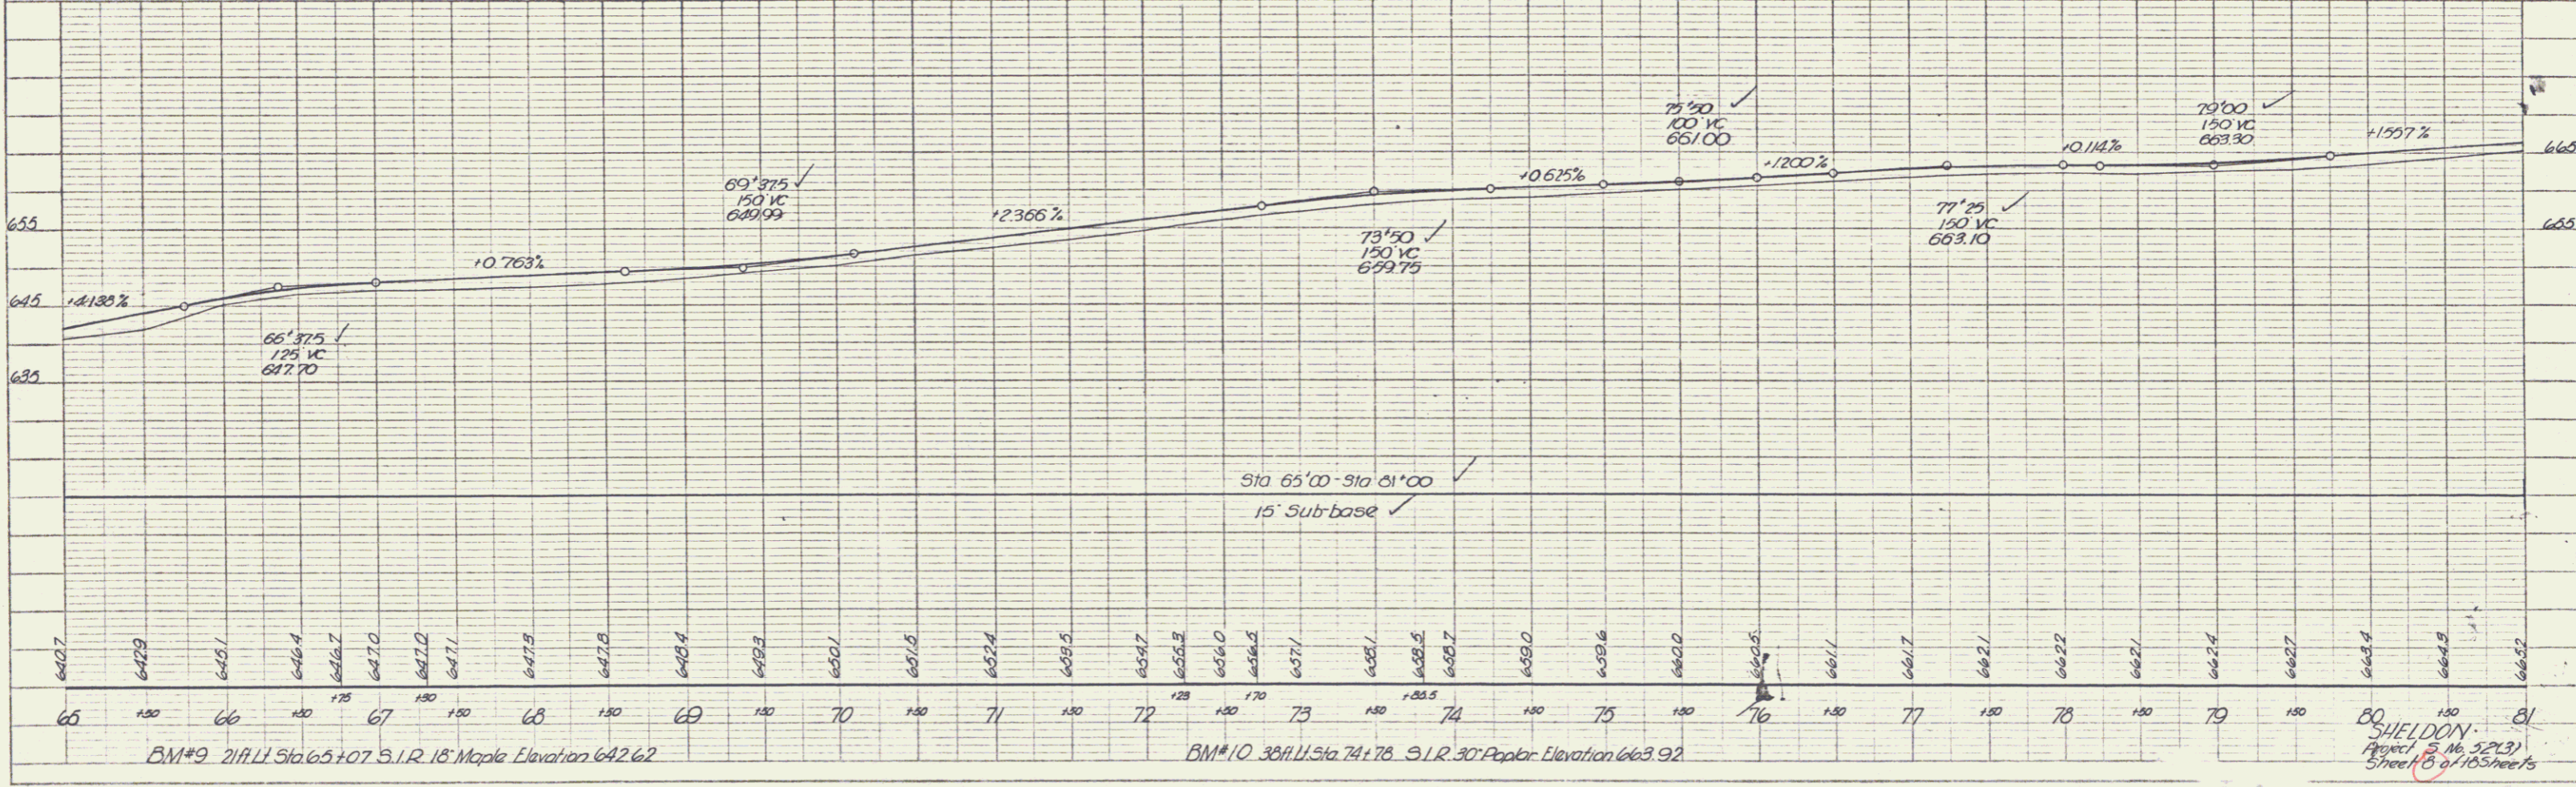
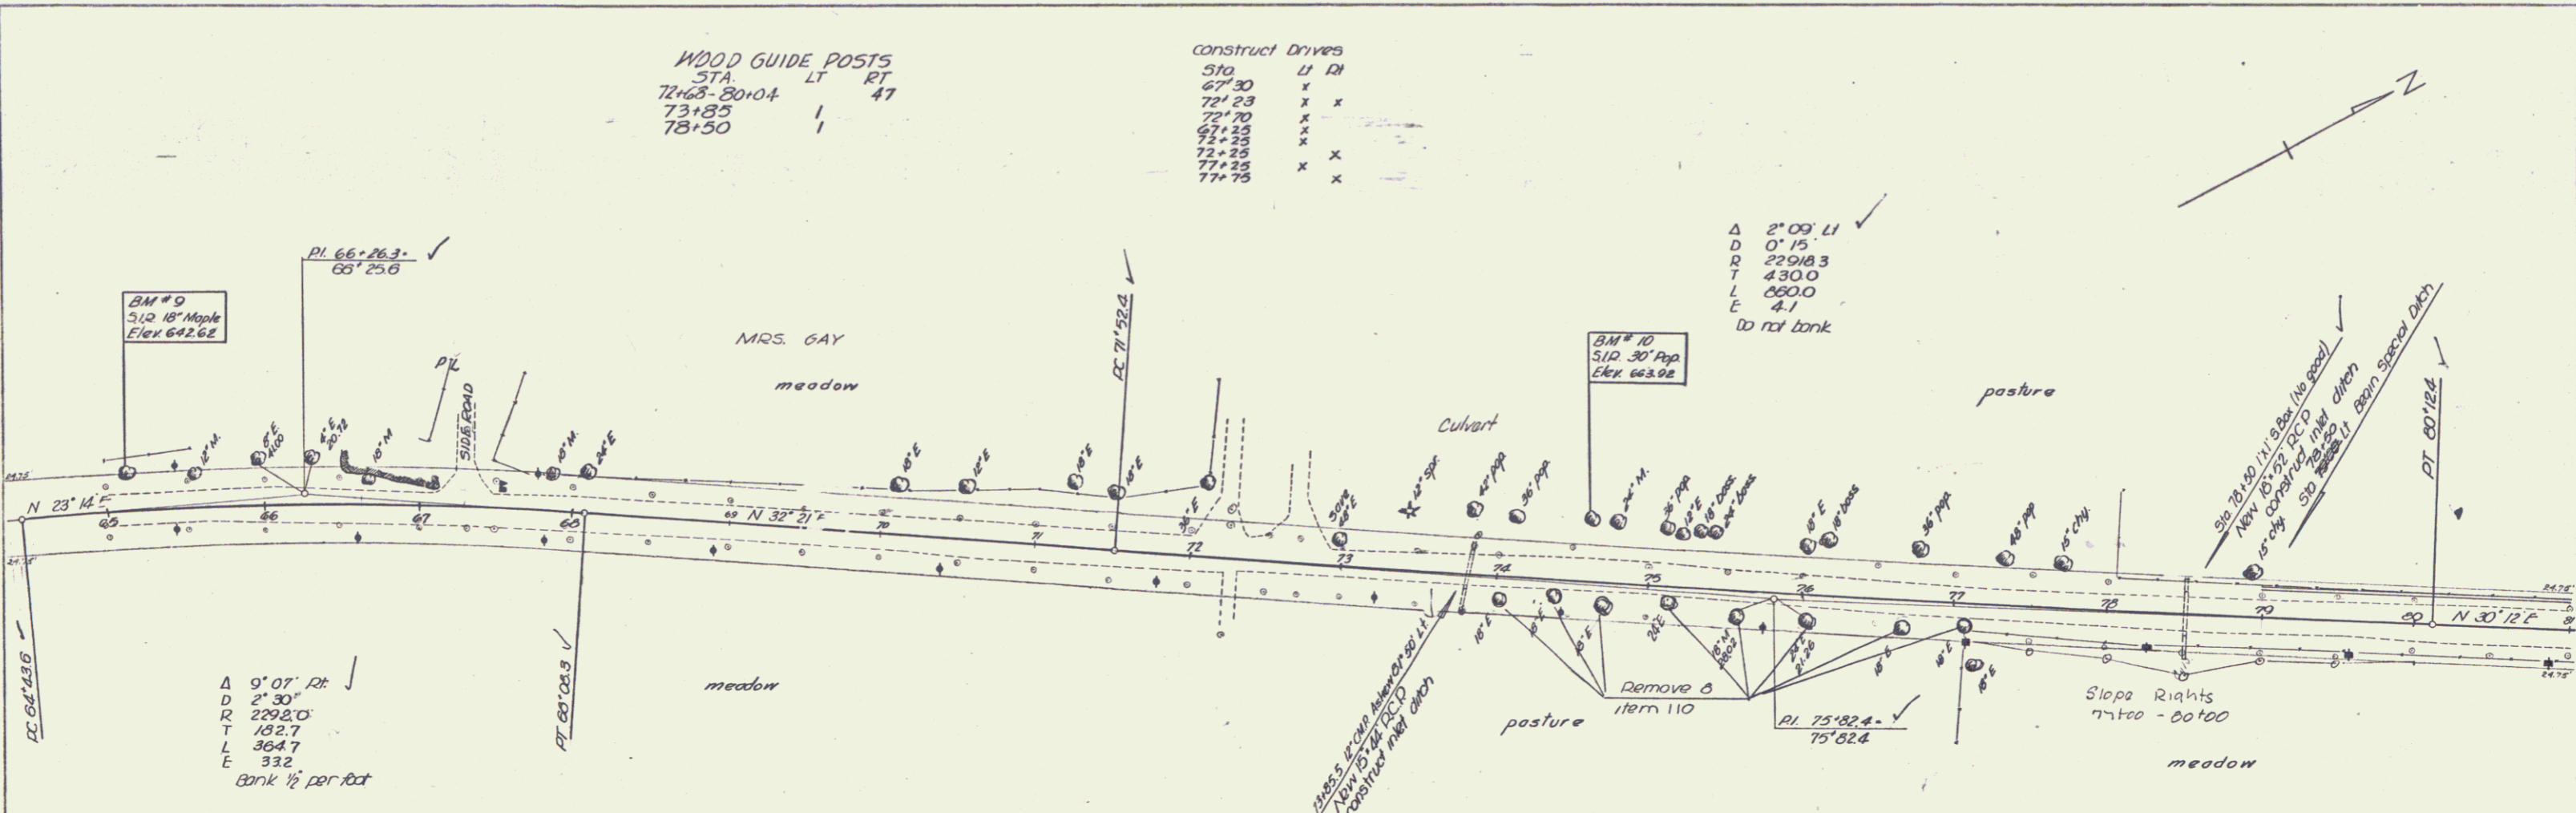


PLATE 1 - PLAN PROFILE  
 SHEET NO. 10110

SHELDON  
 Project 5 No. 5213  
 Street 18 of 185 feet

3