
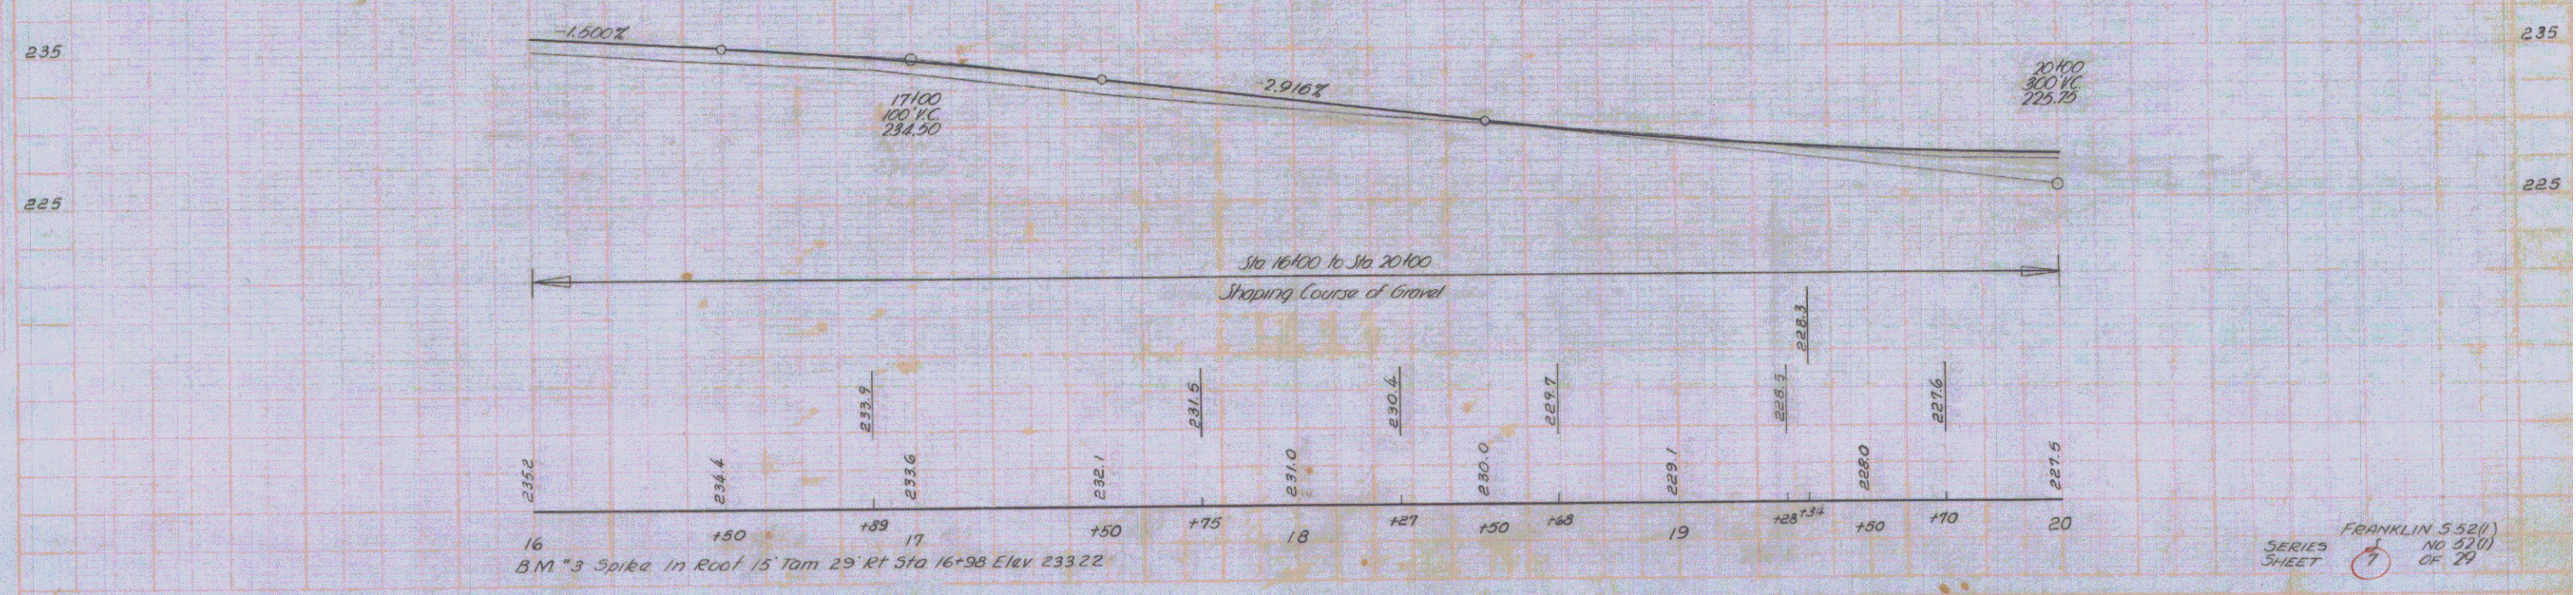


| FED. ROAD DIST. NO. | STATE | PROJECT NO. | FISCAL YEAR | SHEET NO. | TOTAL SHEETS |
|---------------------|-------|-------------|-------------|-----------|--------------|
| 1                   | 3201  | 1947        | 7           | 20        |              |

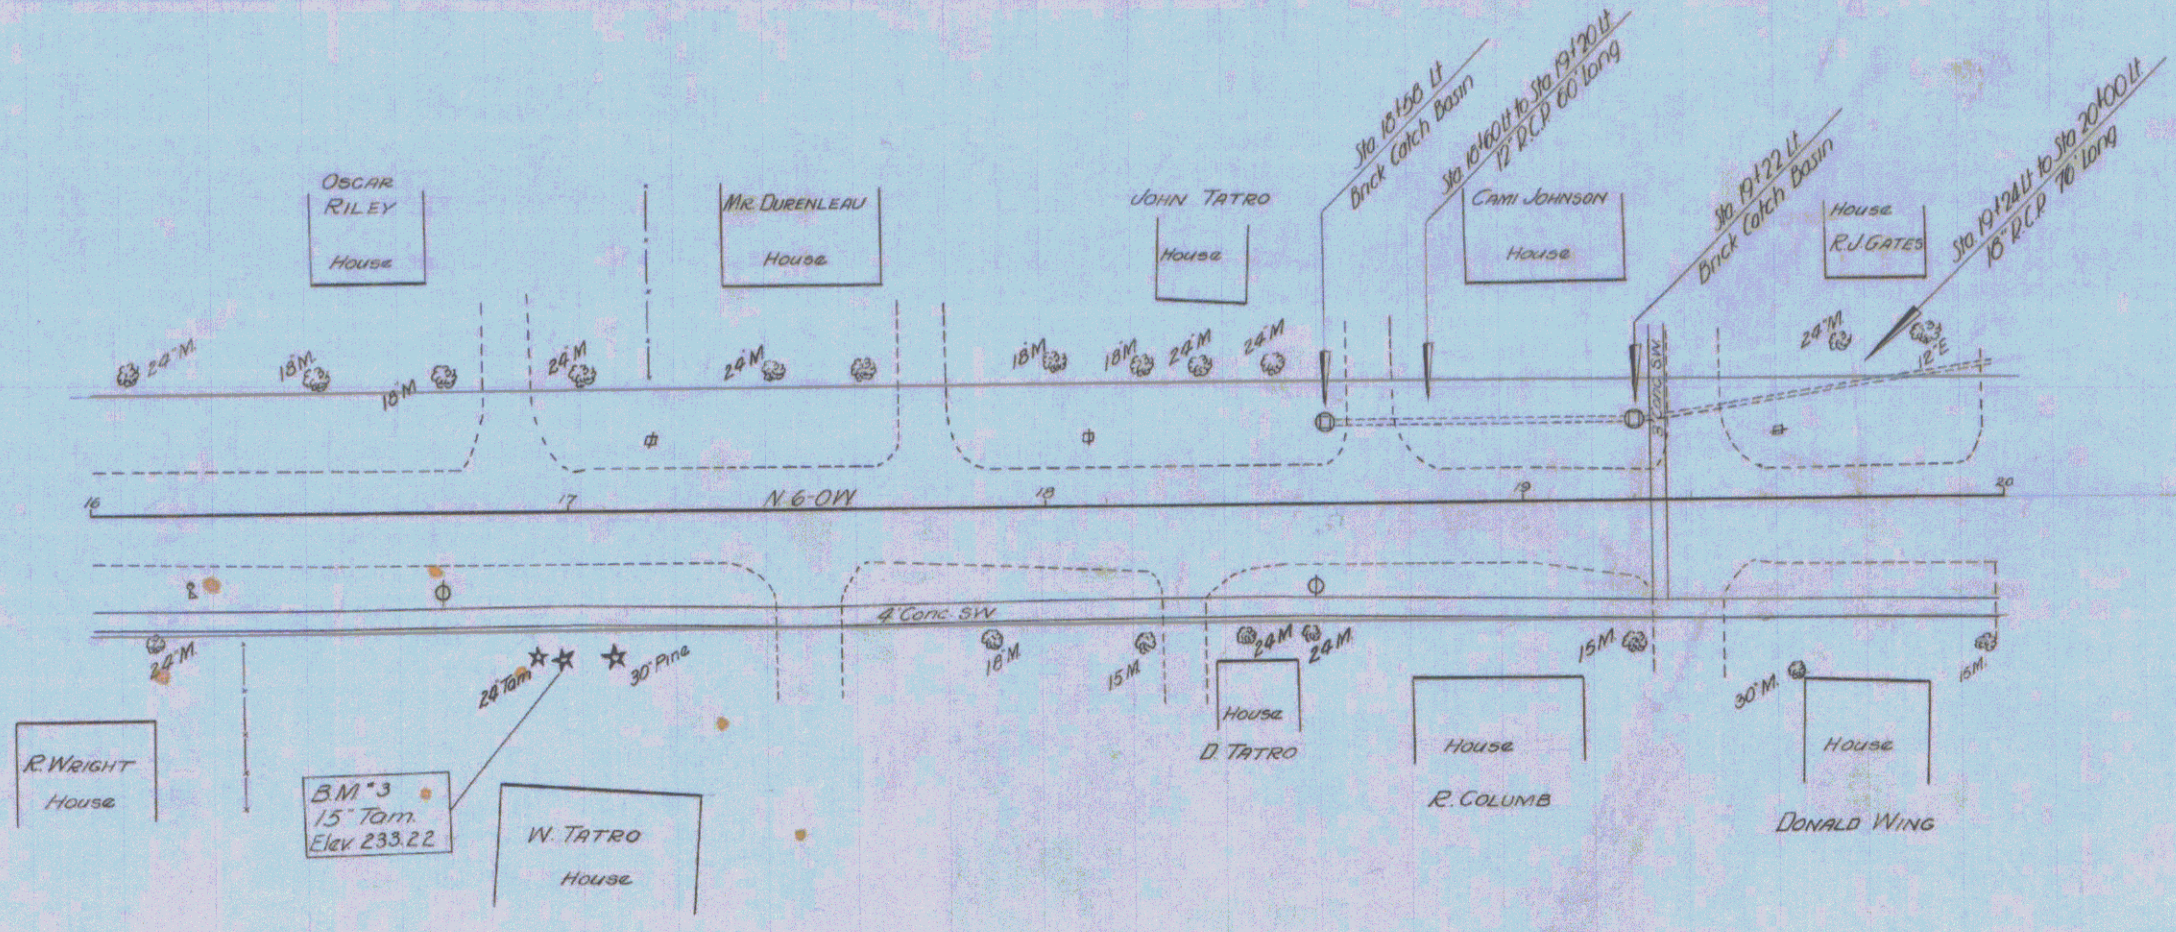

FRANKLIN 552(1)  
NO. 52(1)  
OF 20