
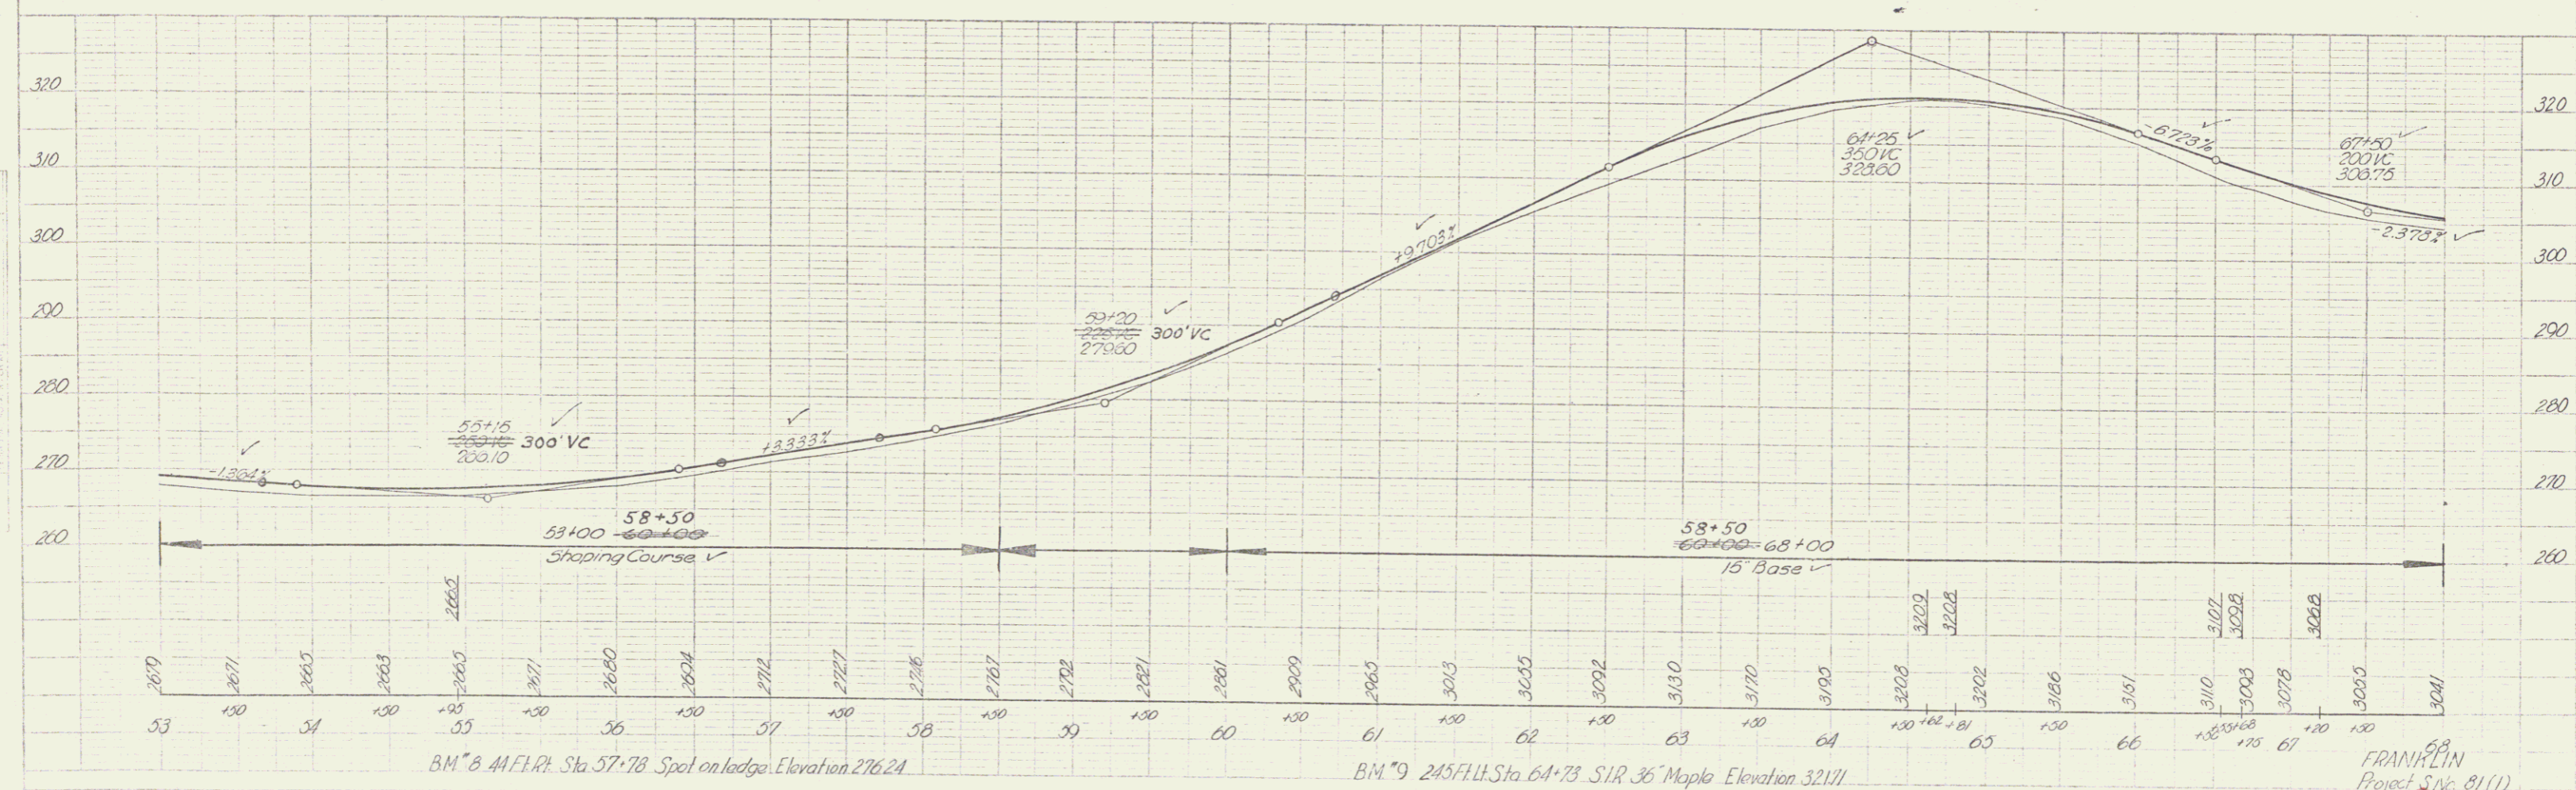


PLAN
 10-31
 10-31
 11-51

10-31
 11-51

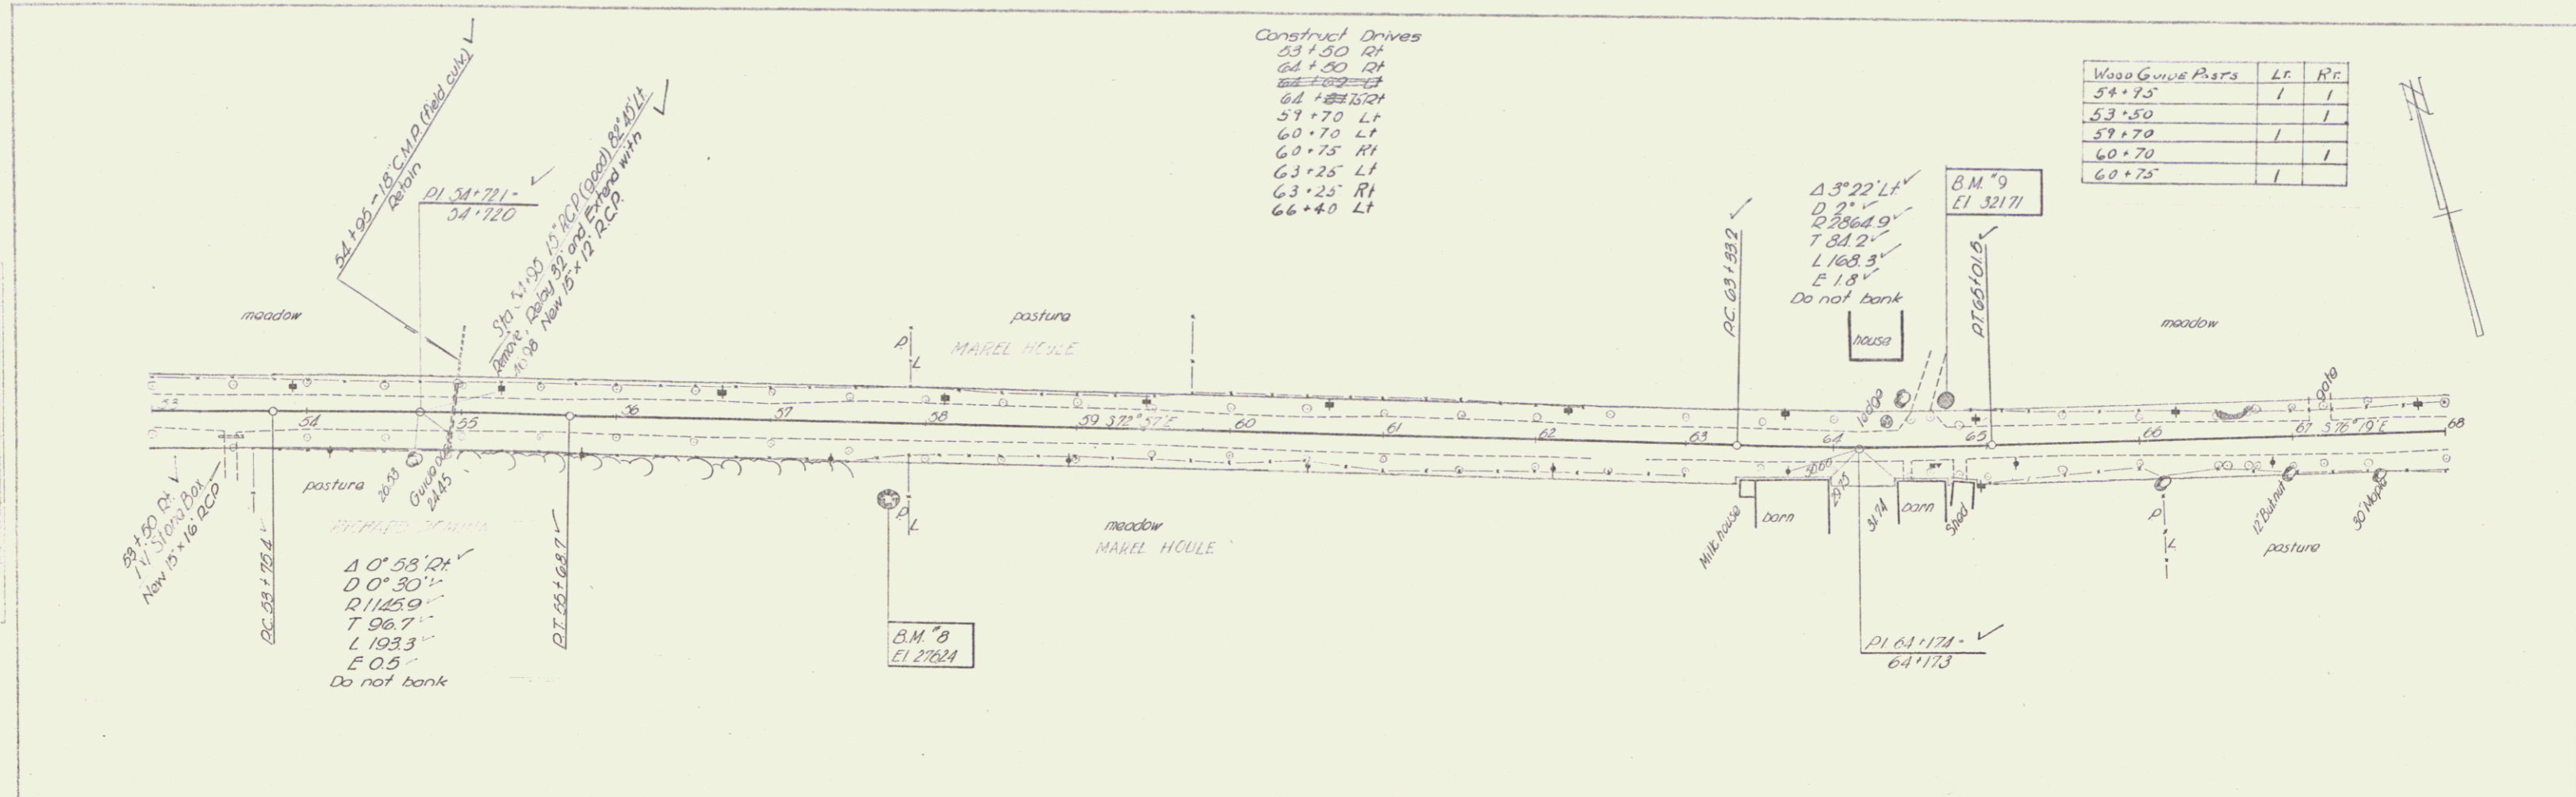

FRANKLIN
 Project No. 81(1)
 Sheet 12 of 27