


10-31
 10-31
 10-31

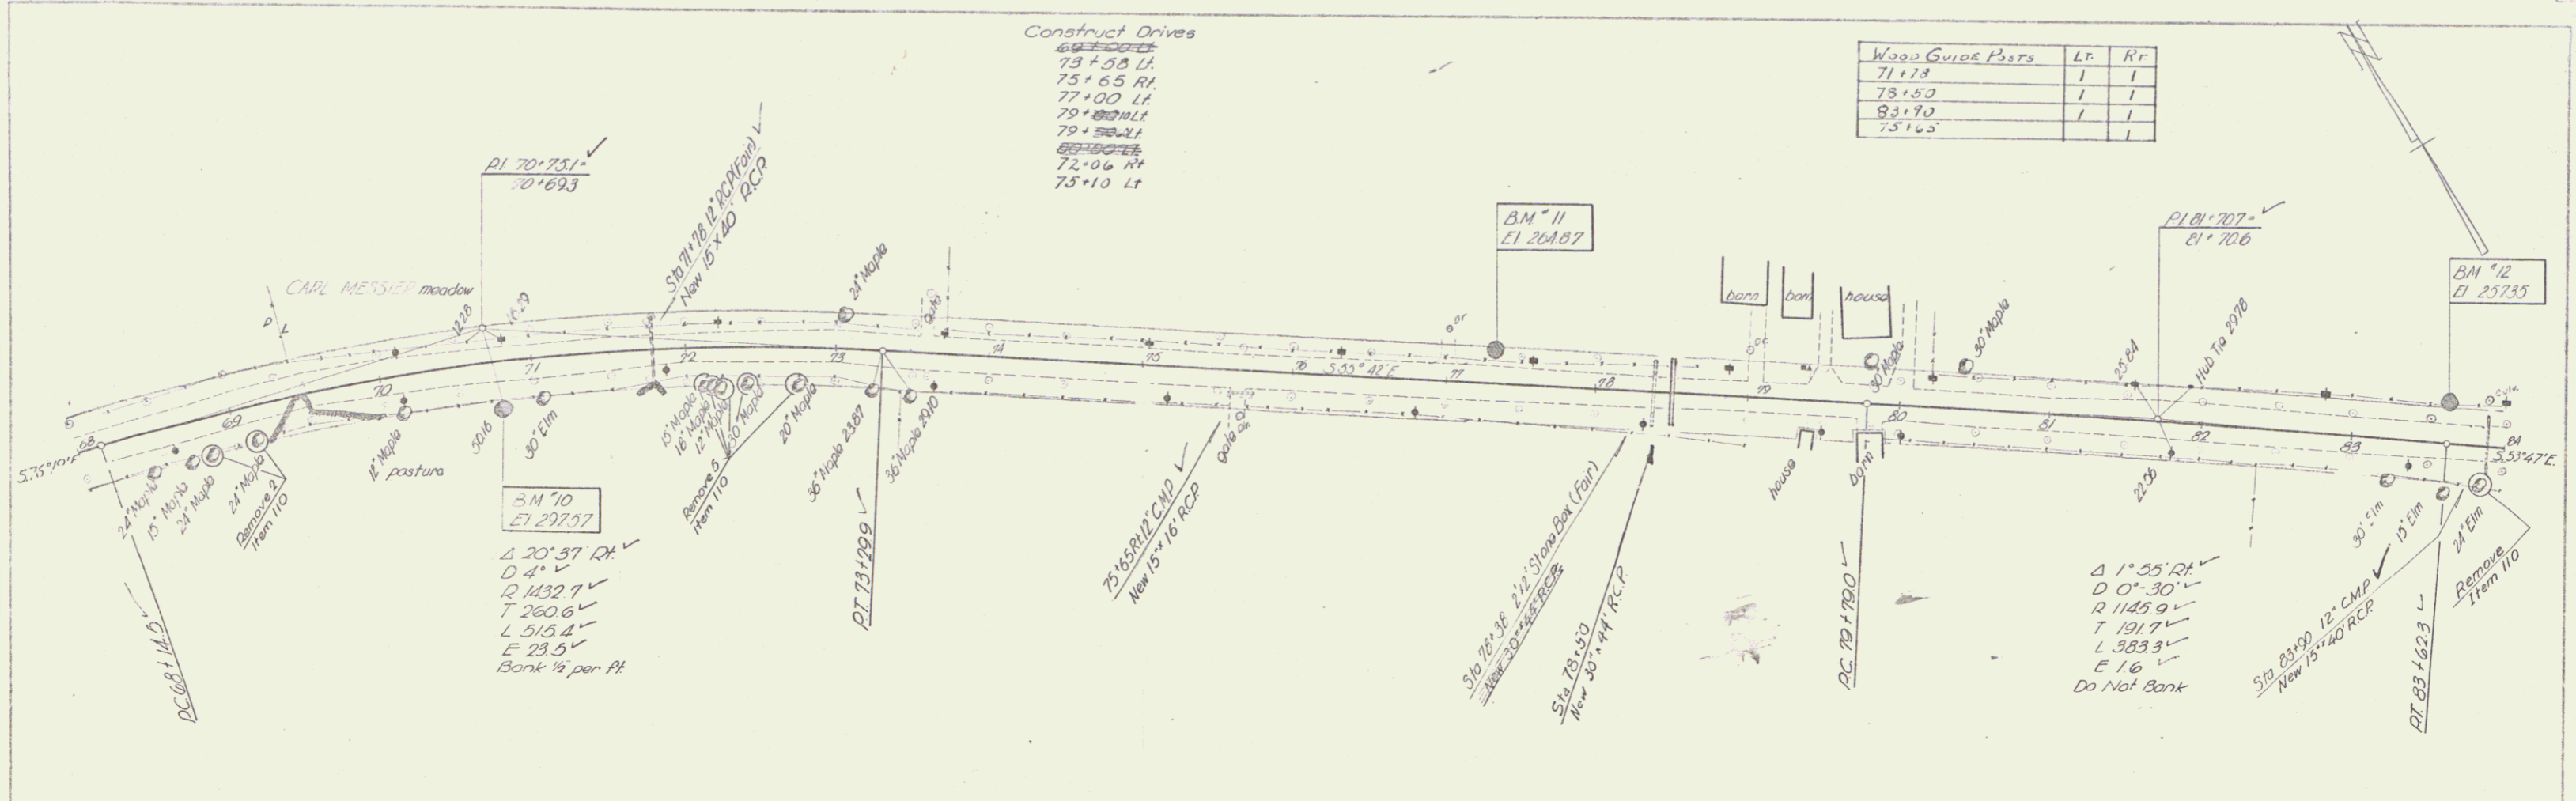


Construct Drives
 69+00
 73+58 Lt
 75+65 Rt
 77+00 Lt
 79+50 Lt
 82+00 Rt
 85+00 Lt
 87+00 Lt

Wood Guide Posts	LR	RR
71+13	1	1
73+53	1	1
83+70	1	1
75+65	1	1

B.M. 10
 El. 297.57
 Δ 20° 37' Rt
 D 4' ✓
 R 1432.1 ✓
 T 260.6 ✓
 L 515.4 ✓
 E 23.5 ✓
 Bank 1/2 per Ft

Δ 1° 55' Rt
 D 0° 30' ✓
 R 1145.9 ✓
 T 191.7 ✓
 L 383.3 ✓
 E 1.6 ✓
 Do Not Bank

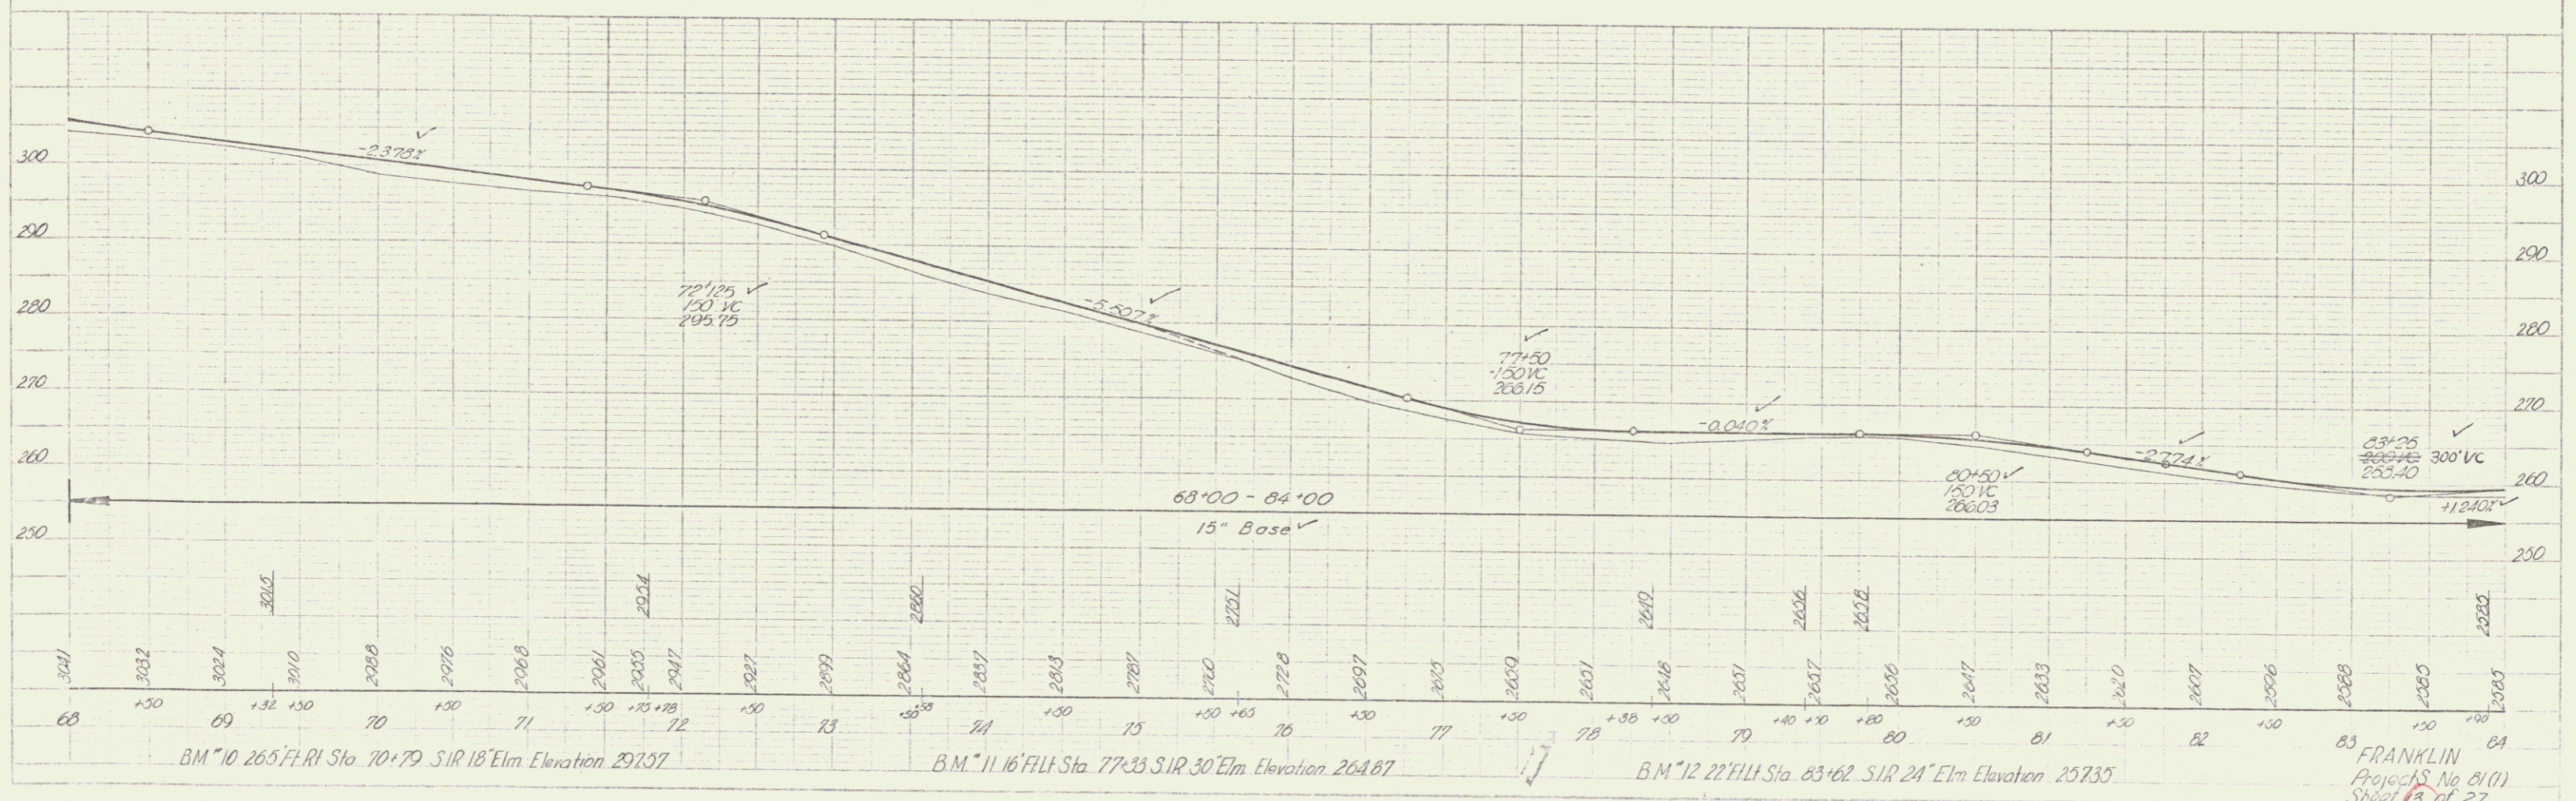

B.M. 10 265 Ft Rt Sta. 70+79 SIR 18' Elm Elevation 297.57

B.M. 11 16 Ft Lt Sta. 77+35 SIR 30' Elm Elevation 264.87

B.M. 12 22 Ft Lt Sta. 83+62 SIR 24' Elm Elevation 257.35

FRANKLIN
 Project No. 81(1)
 Sheet 13 of 27