
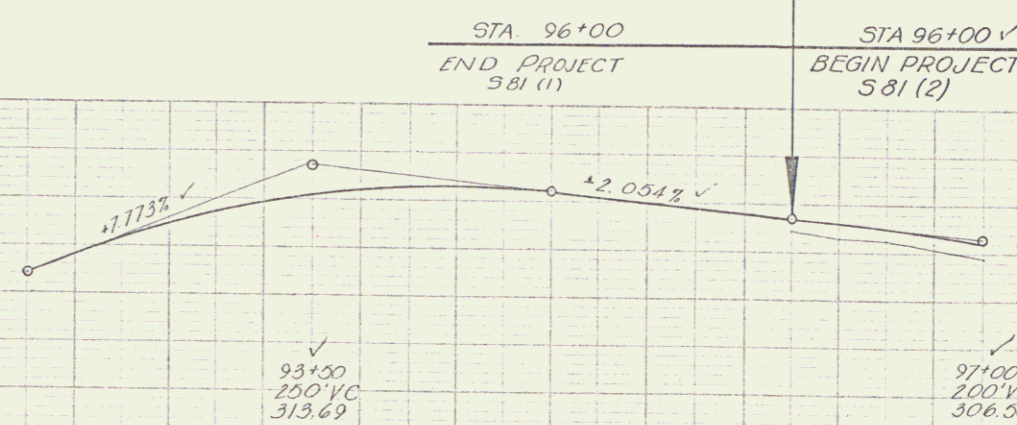


DATE: 09/21/01  
 DRAWN BY: [Signature]  
 CHECKED BY: [Signature]

DATE: 09/21/01  
 DRAWN BY: [Signature]  
 CHECKED BY: [Signature]

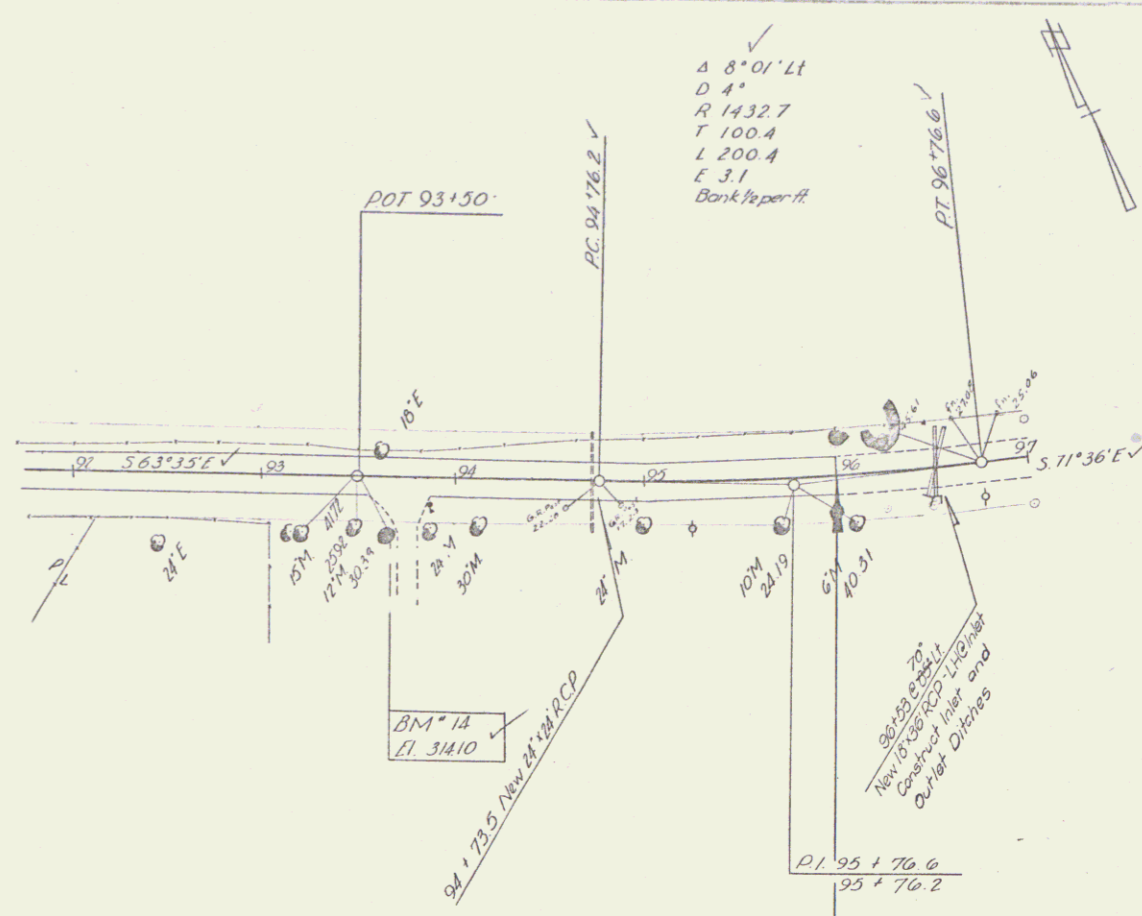

3002 3004 3001 3111 3111 3101 3076 3072 3071 3070 3072 3066 3062 3044  
 92 150 93 180 175 24 130 175 05 130 96 125 150 97  
 FRANKLIN  
 Proj 9 81 (2)  
 Sheet 16 of 70