


Scale	1" = 40'
Date	8-22-58
Author	FRANKLIN
Checker	
Project	5-81(1)
Sheet	10 of 10
City	FRANKLIN

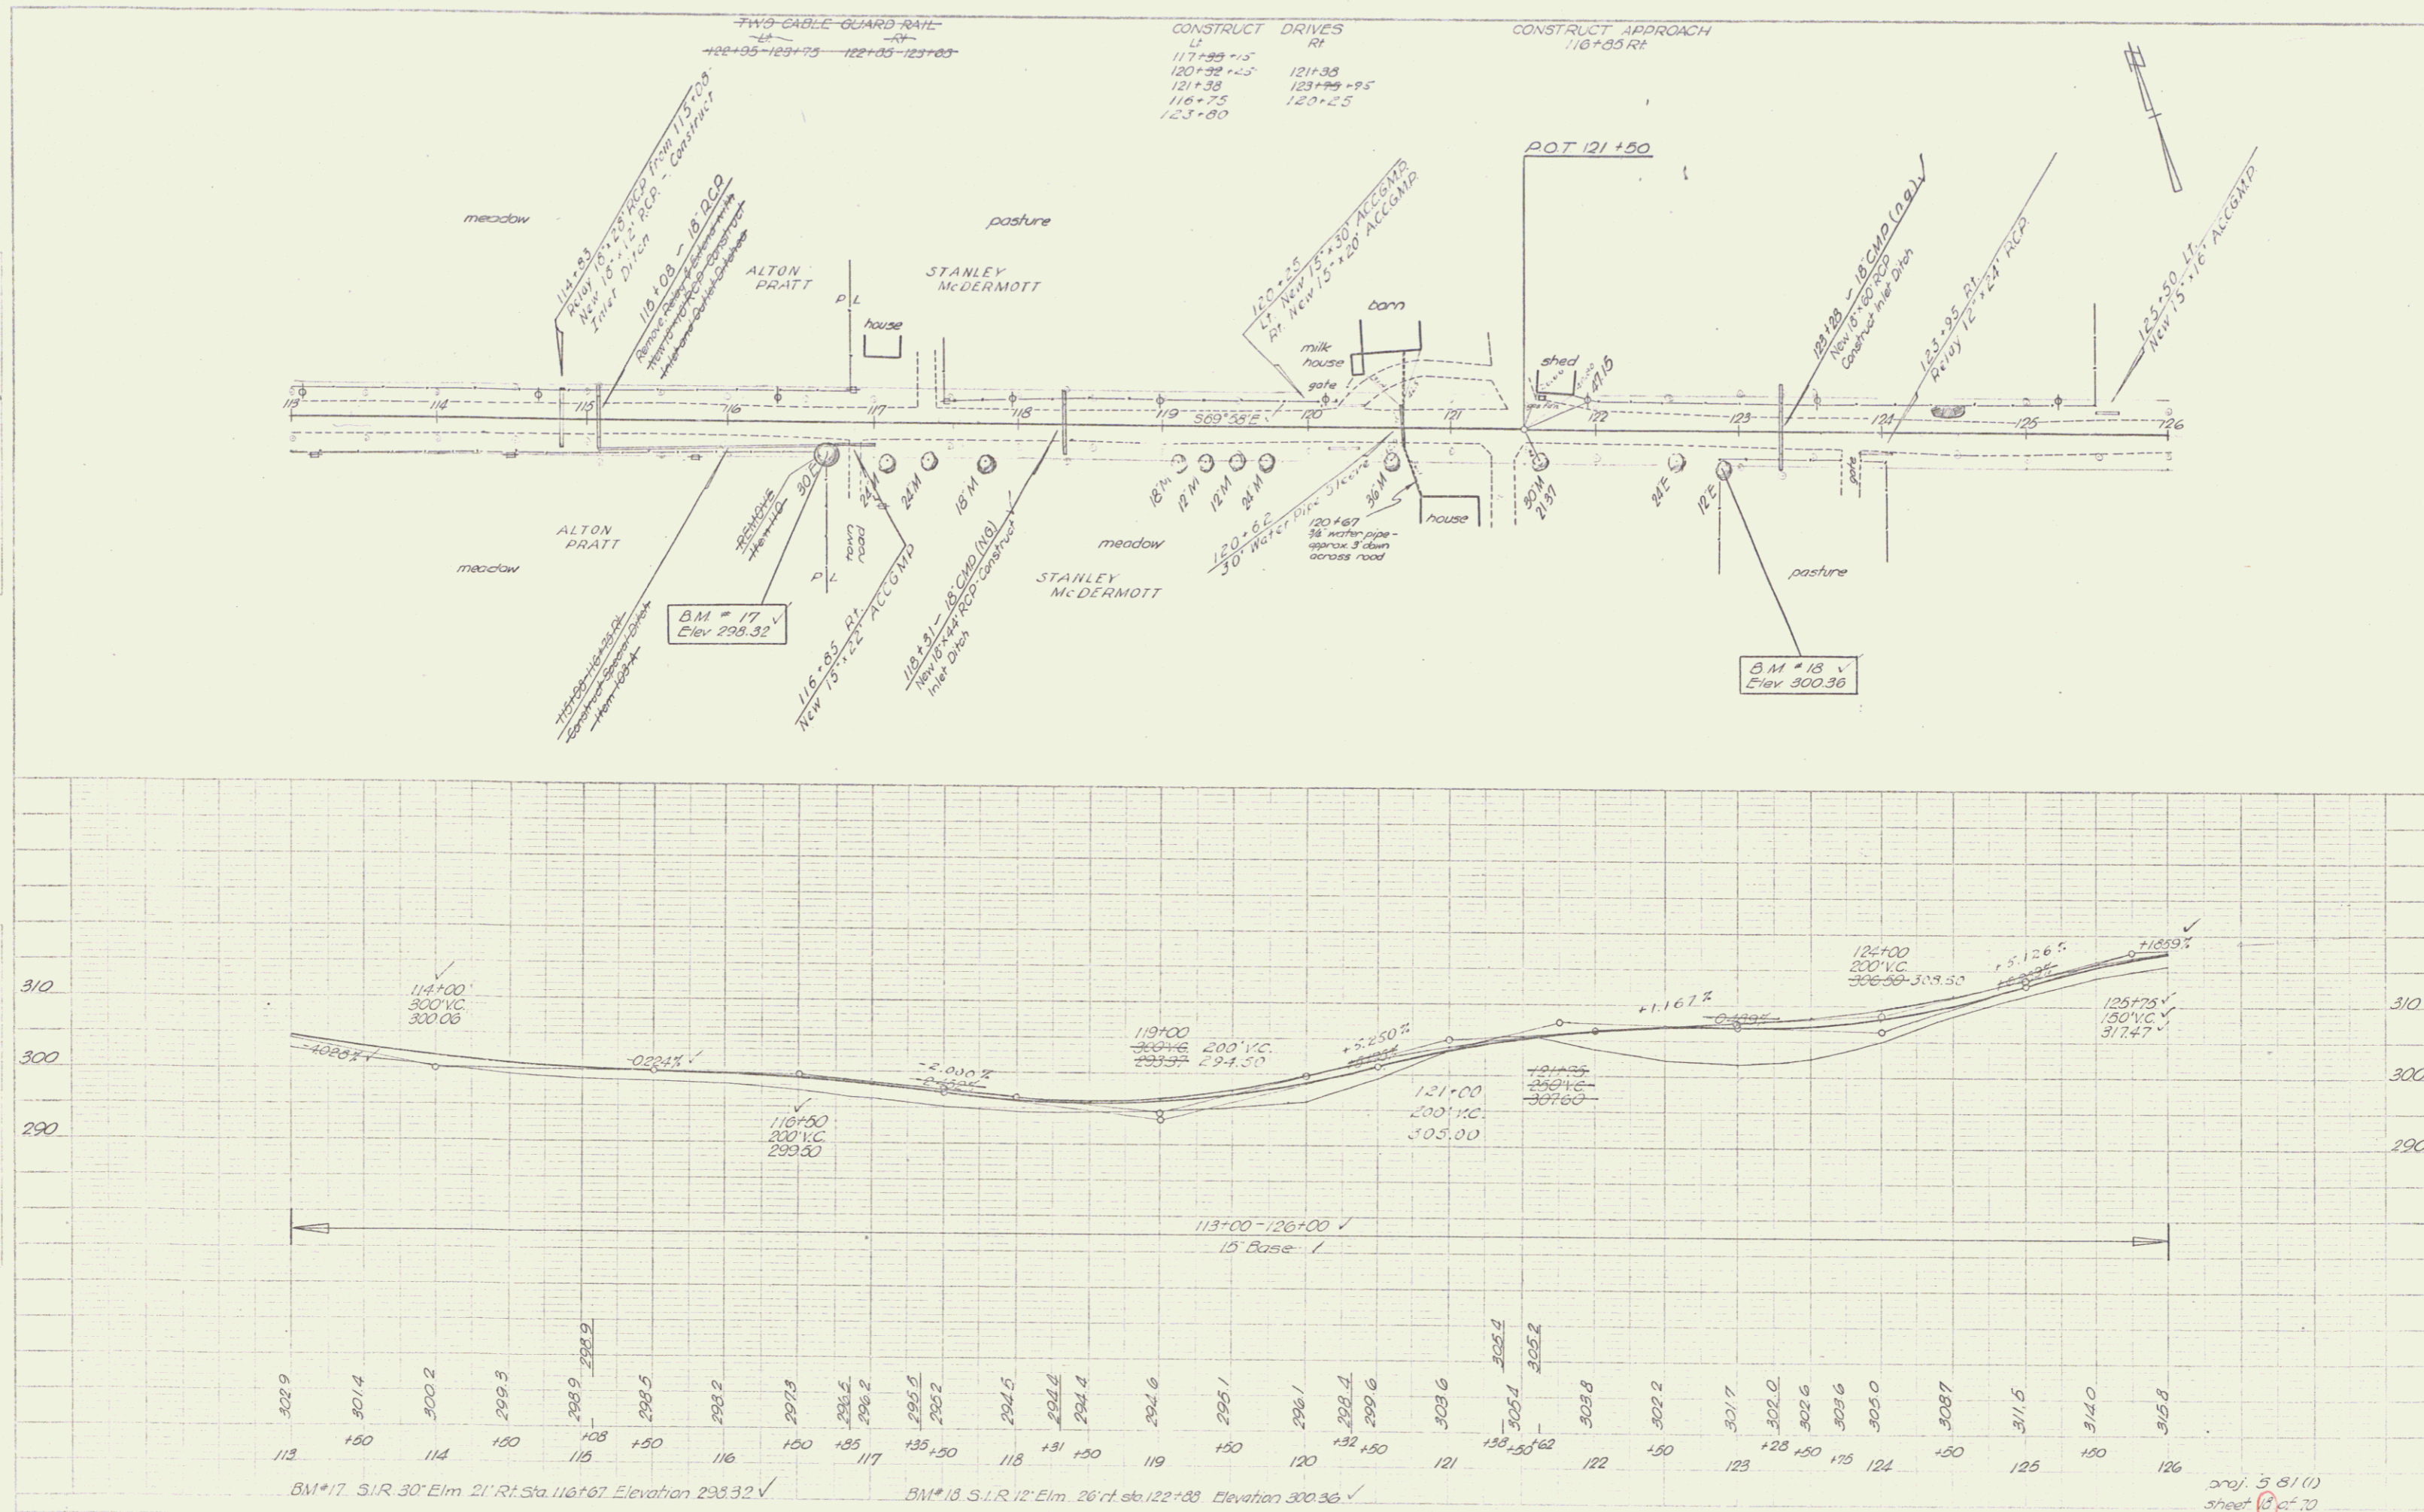

proj. 5-81(1)  
sheet 10 of 10  
FRANKLIN