

PLANK GUARD RAIL  
163+19 L-24 R-24 IF

BM \* 26  
11 220.59

PI 166+02.0  
165+966

CONSTRUCT DRIVES


L1	R1
167+09	153+50 ✓
167+35	174+00 ✓
168+25	175+00 ✓
168+30	175+66-40 ✓
168+38	175+50 ✓
170+00	176+10 ✓
170+25	✓
171+00	✓
172+00	✓
173+00 to 174+25	✓
170+70	✓

PI 170+33.0  
170+32.9


BM \* 27  
R 223.09

PI 177+02.0  
177+02.9

1963  
1/12  
1/18  
3 Foster  
Palmer  
Palmer  
1/18

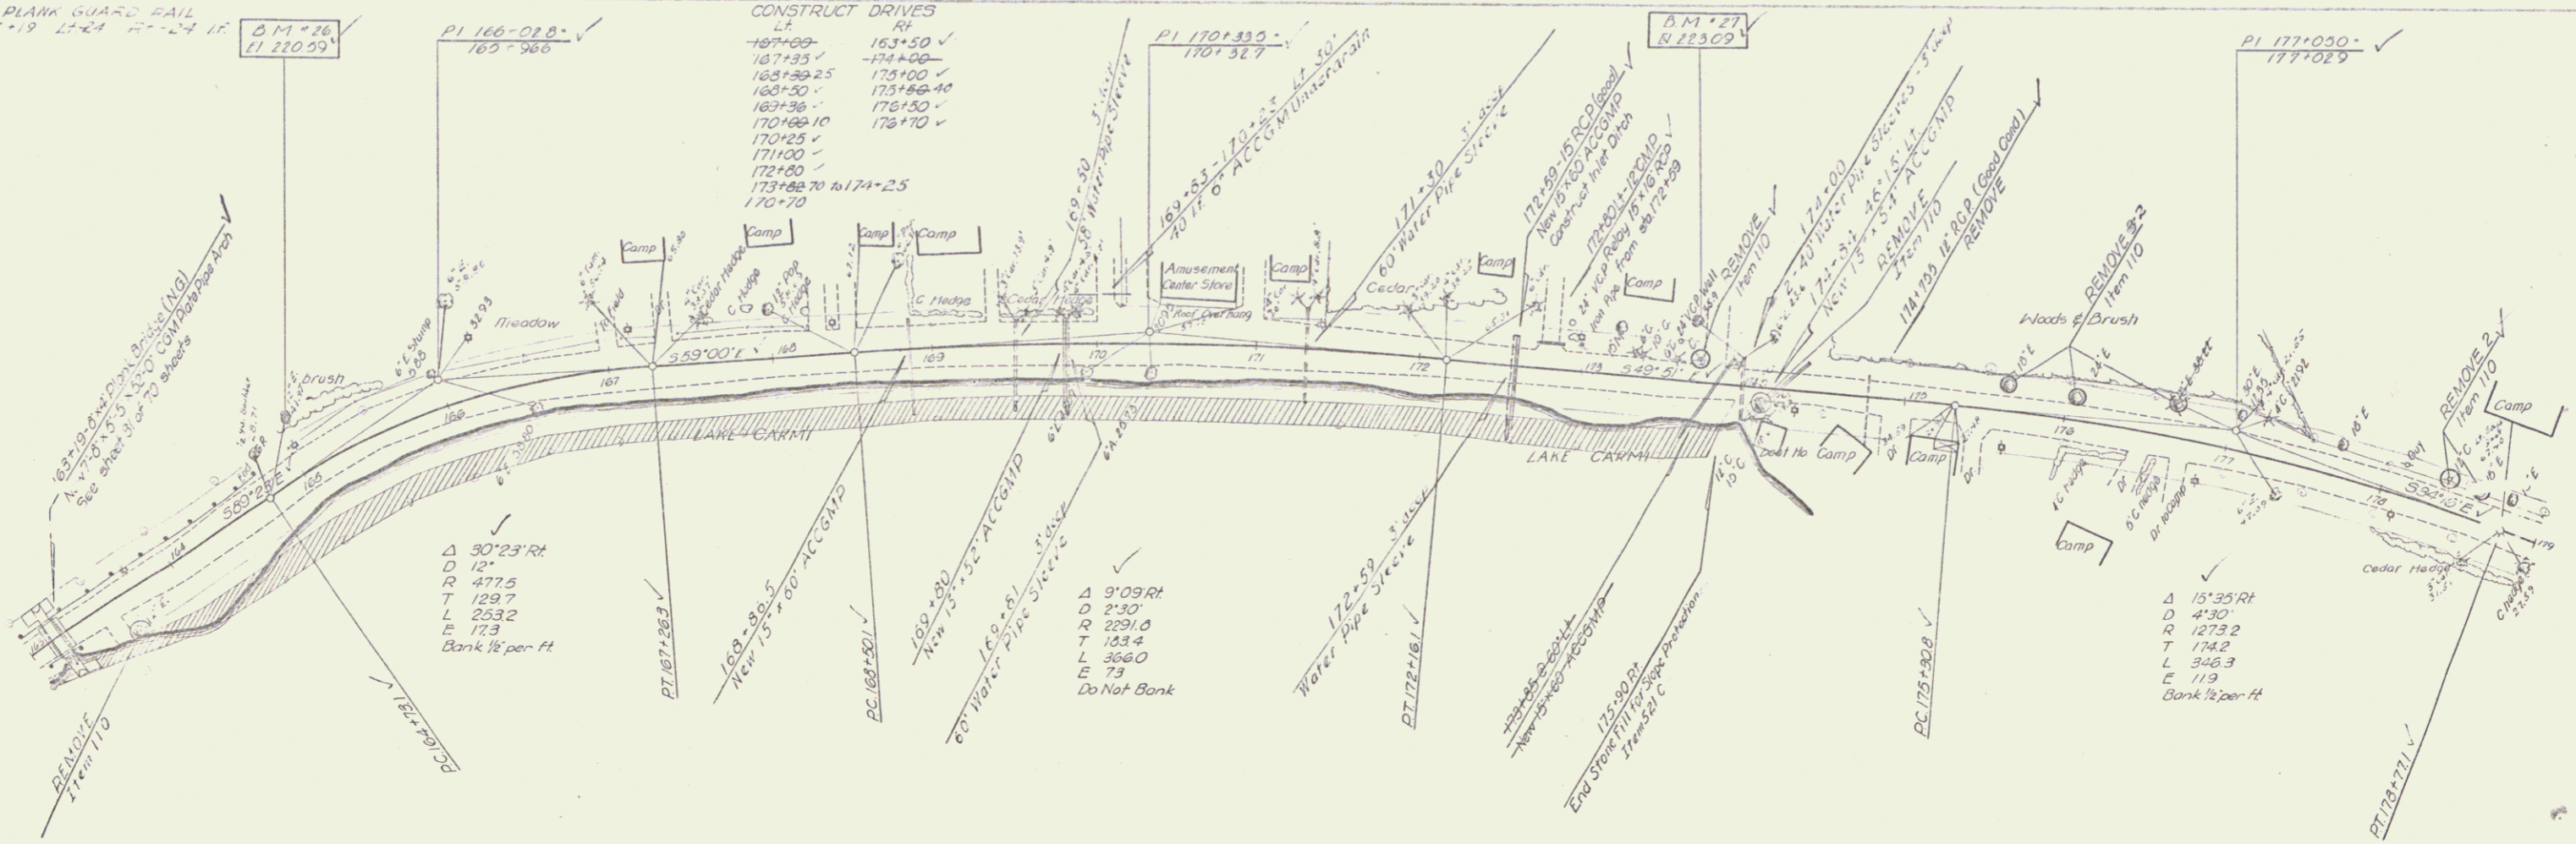

1963  
1/12  
1/18  
3 Foster  
Palmer  
Palmer  
1/18

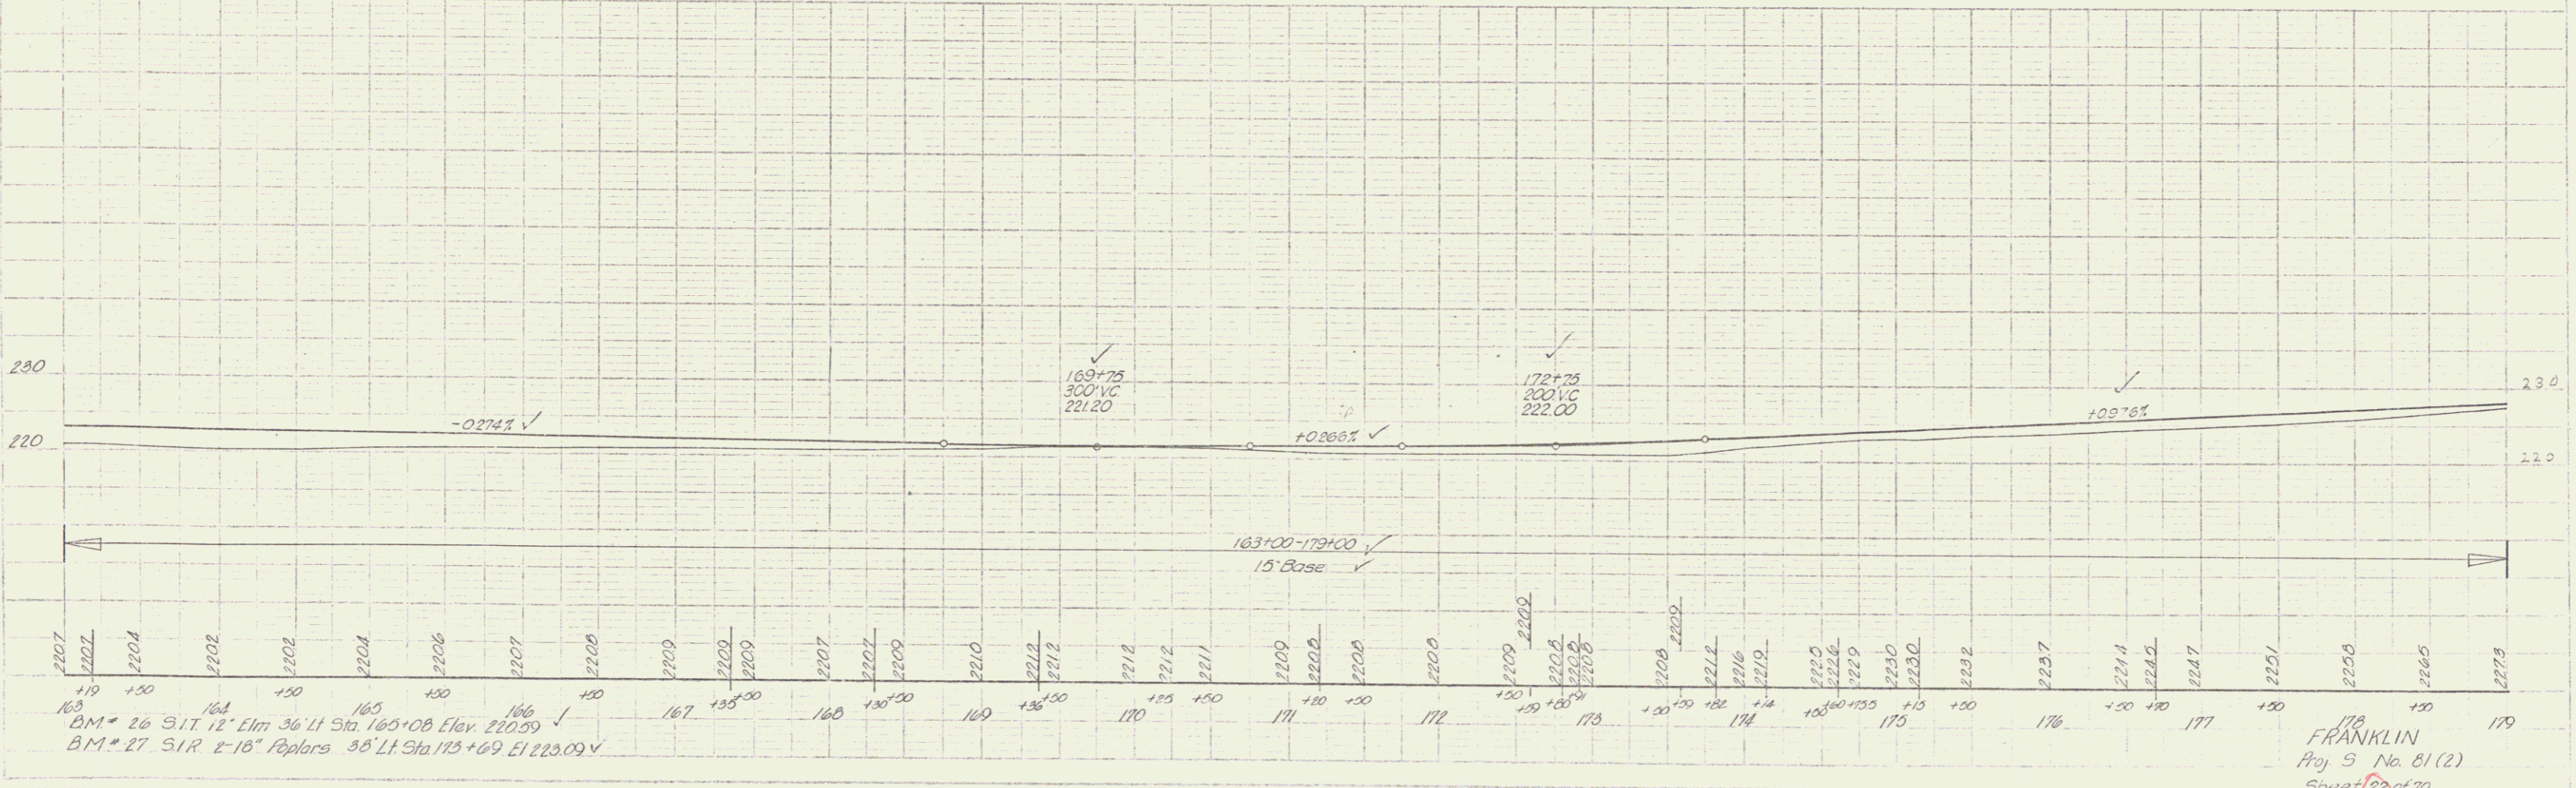

BM \* 26 9.11 12' Elm 36' Lt Sta 165+08 Elev 220.59  
BM \* 27 5.18 12' Poplar 36' Lt Sta 173+69 El 223.09

FRANKLIN  
Proj S No. 81 (2)  
Sheet 22 of 70