


4/24  
1/25  
B. E. Miller  
Planner  
1/24

4/23  
1/24  
B. E. Miller  
Planner  
1/24

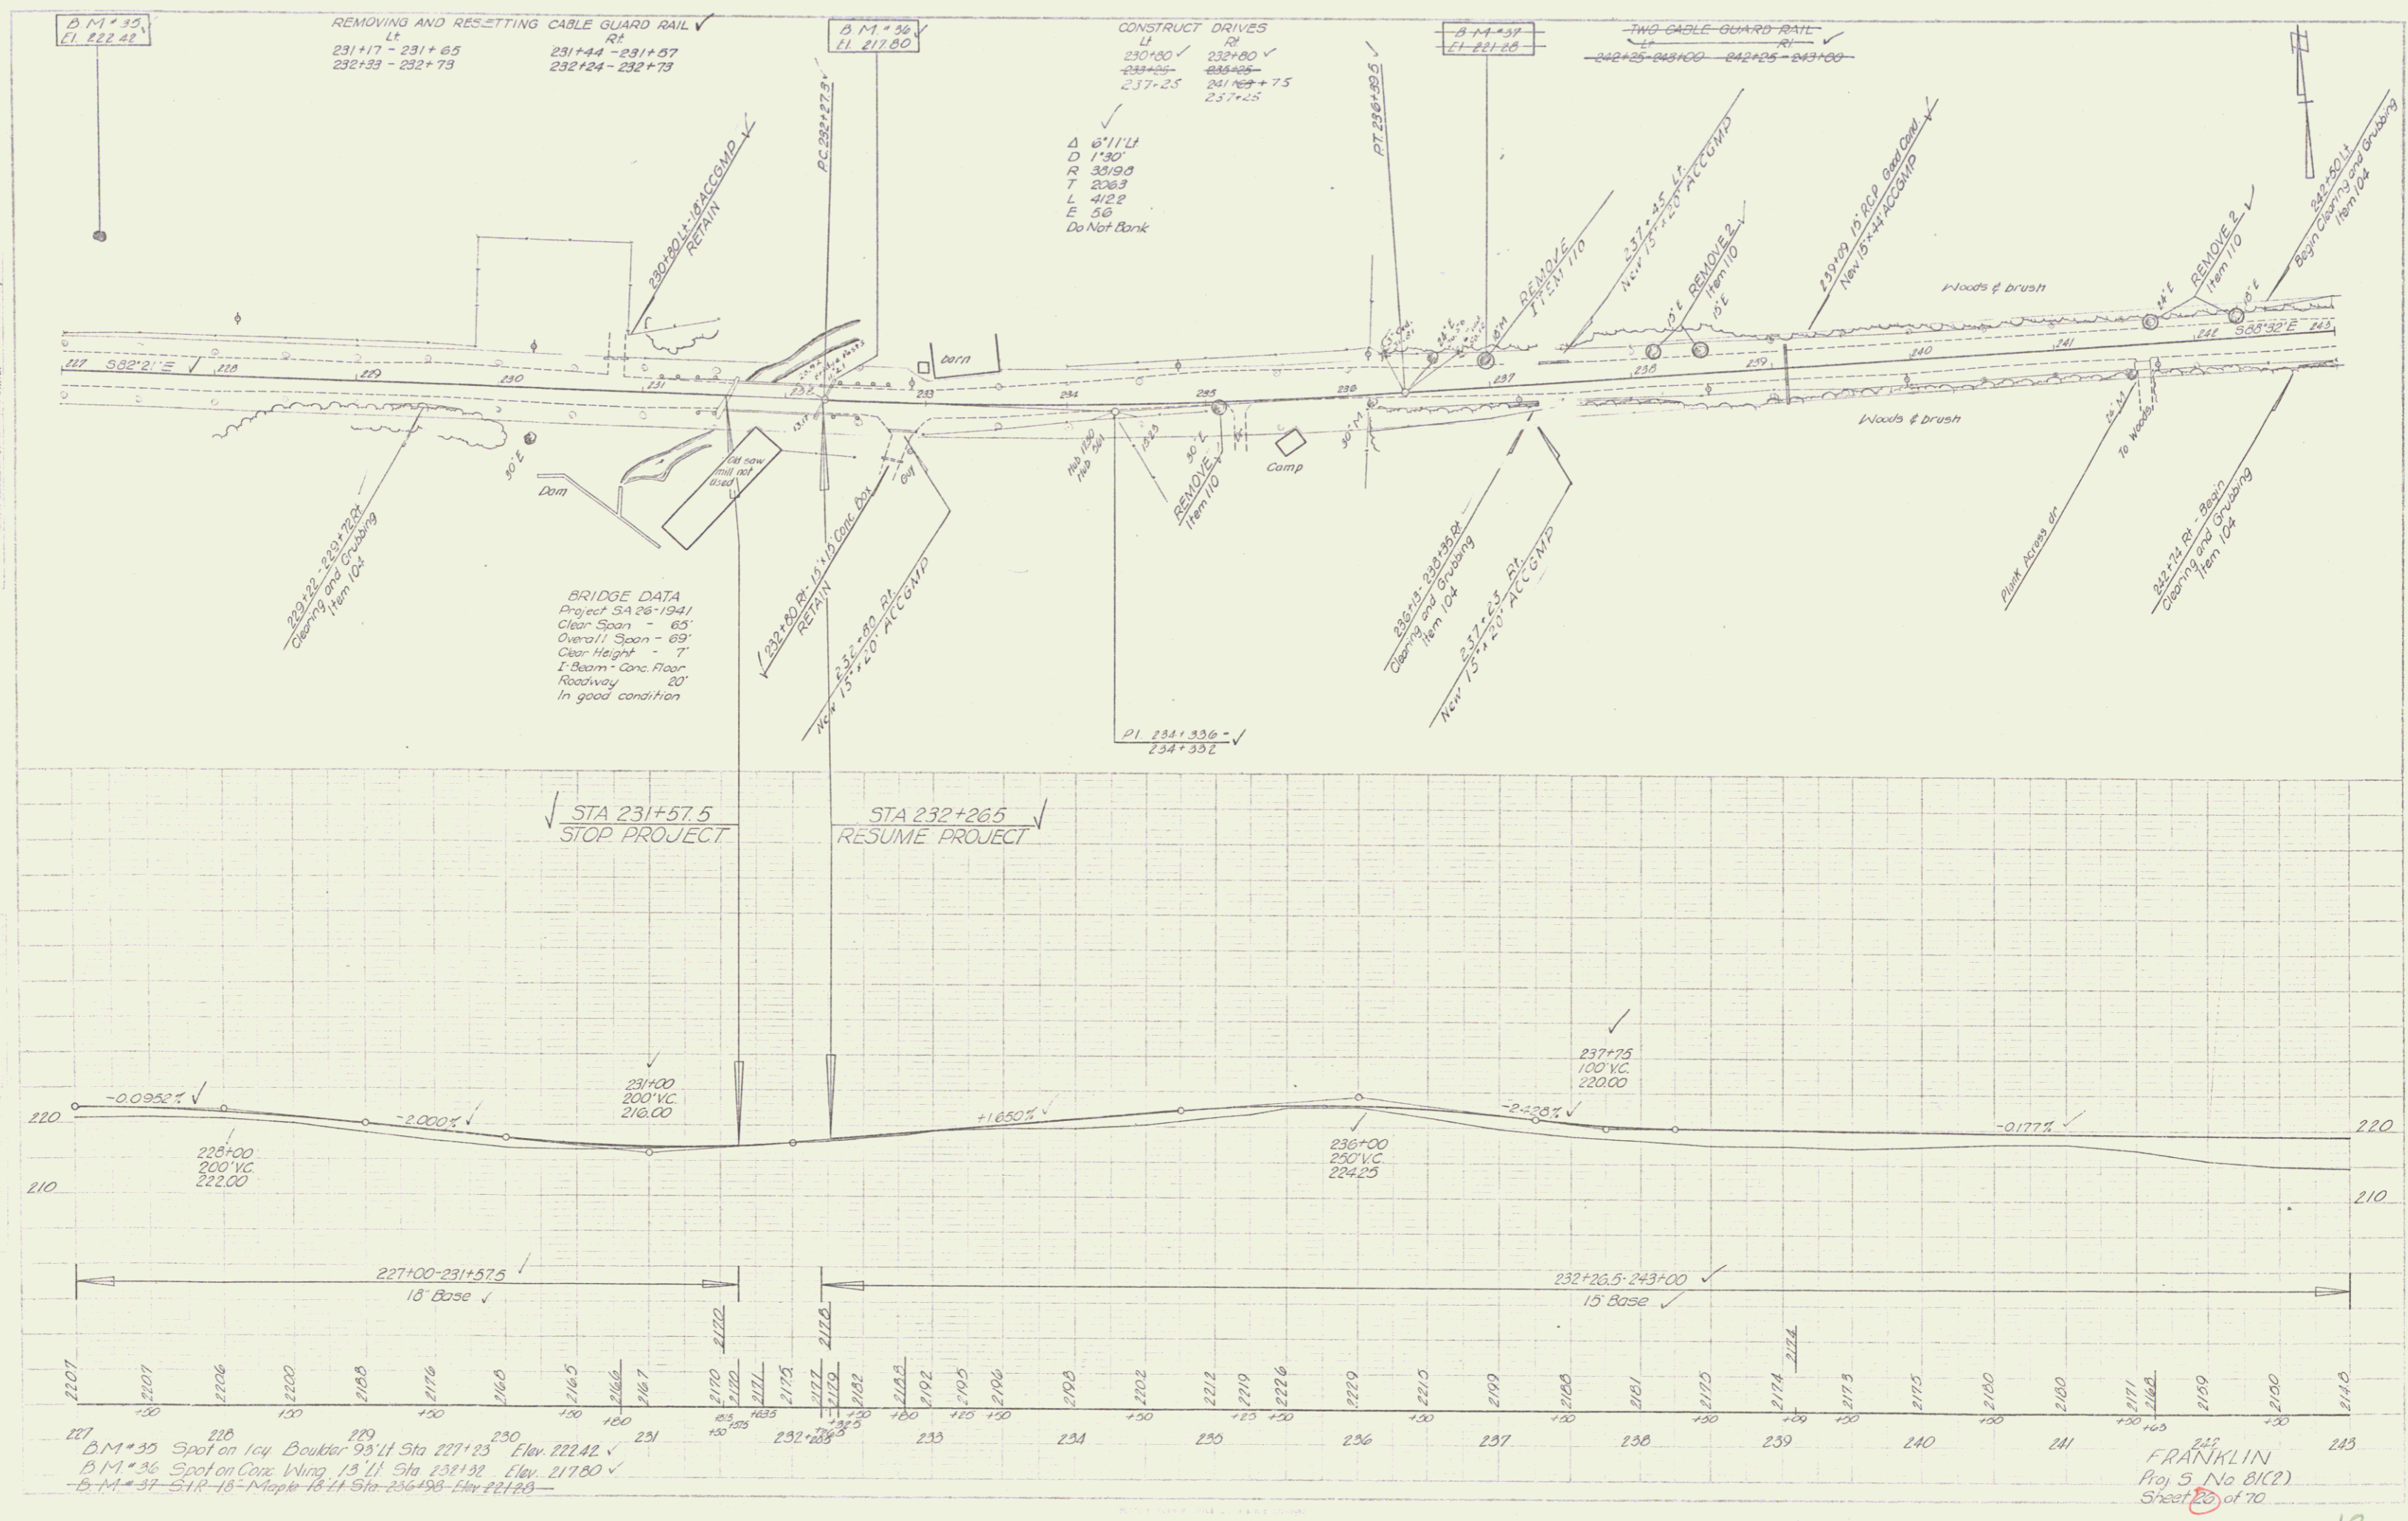

FRANKLIN  
 Proj 5 No 81(2)  
 Sheet 20 of 70