
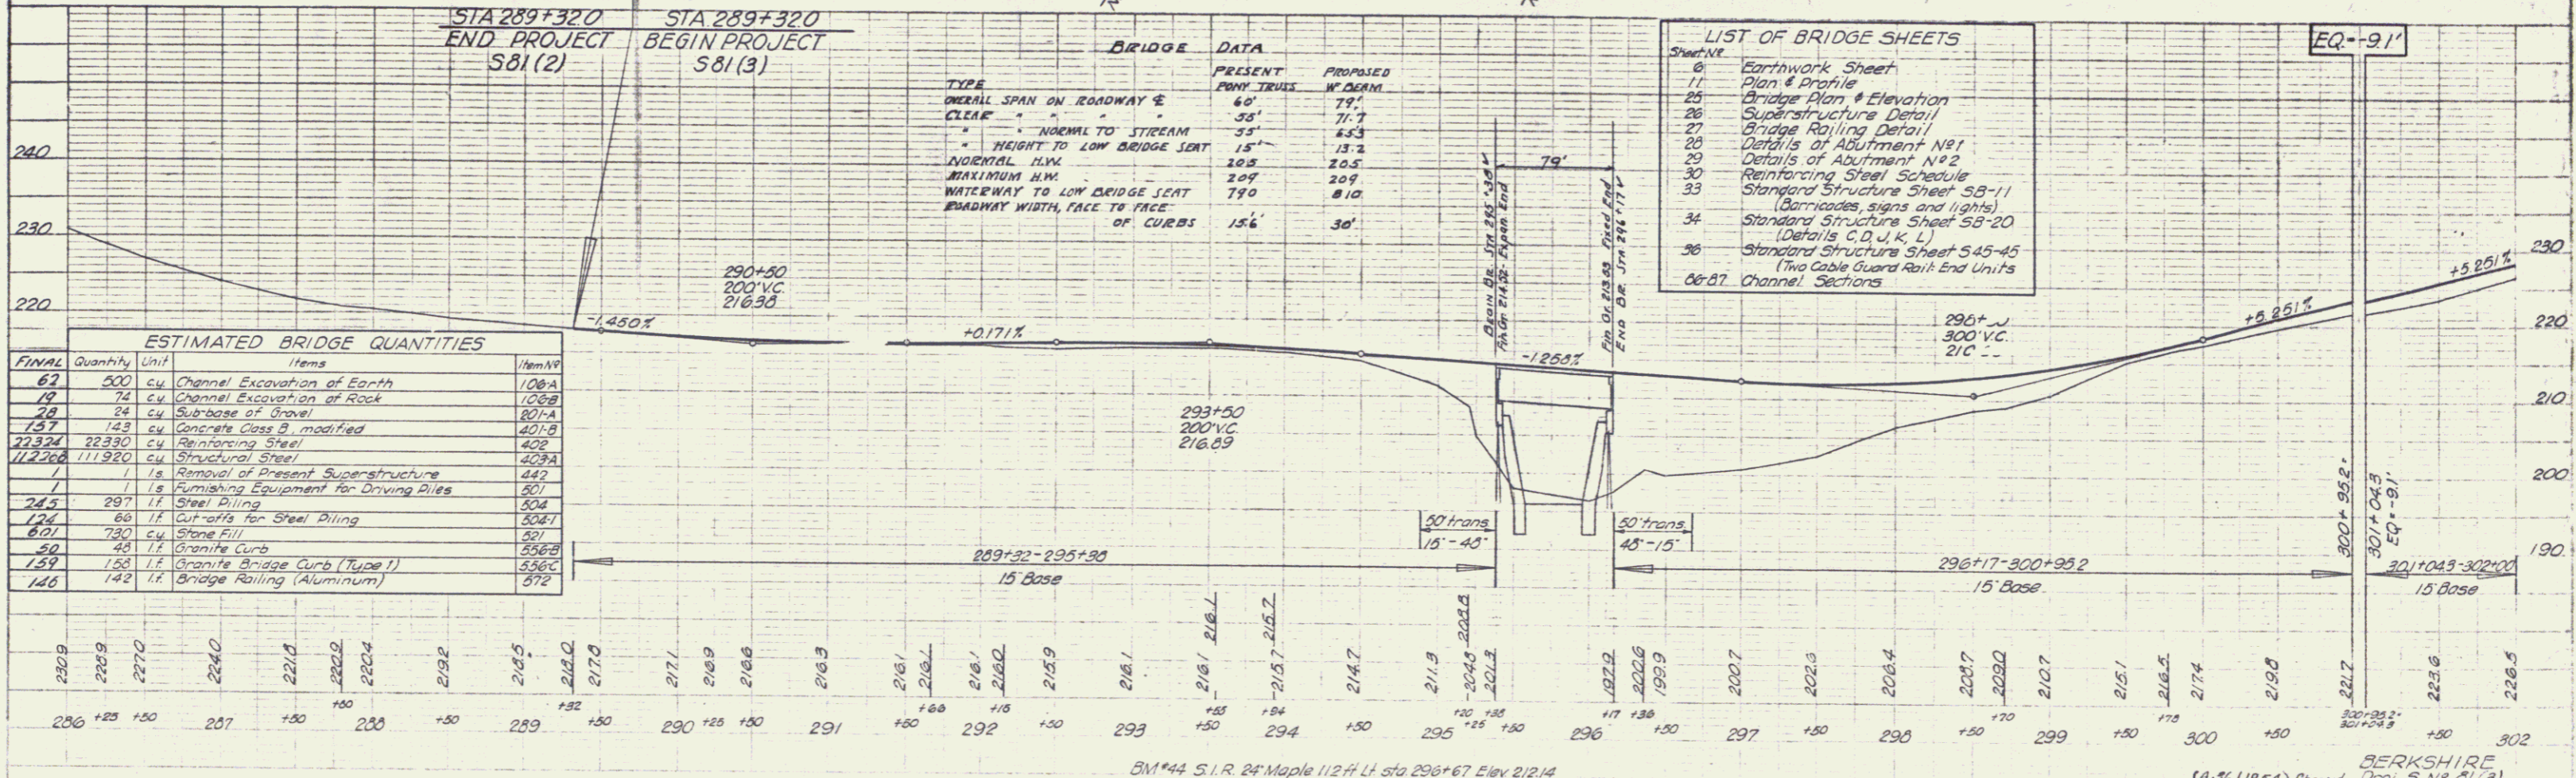


PLAN
 DRAWN BY: **WALKER**
 CHECKED BY: **WALKER**
 DATE: **6-45**

PROJECT
 NO. **111920**
 SHEET NO. **EQ-91**

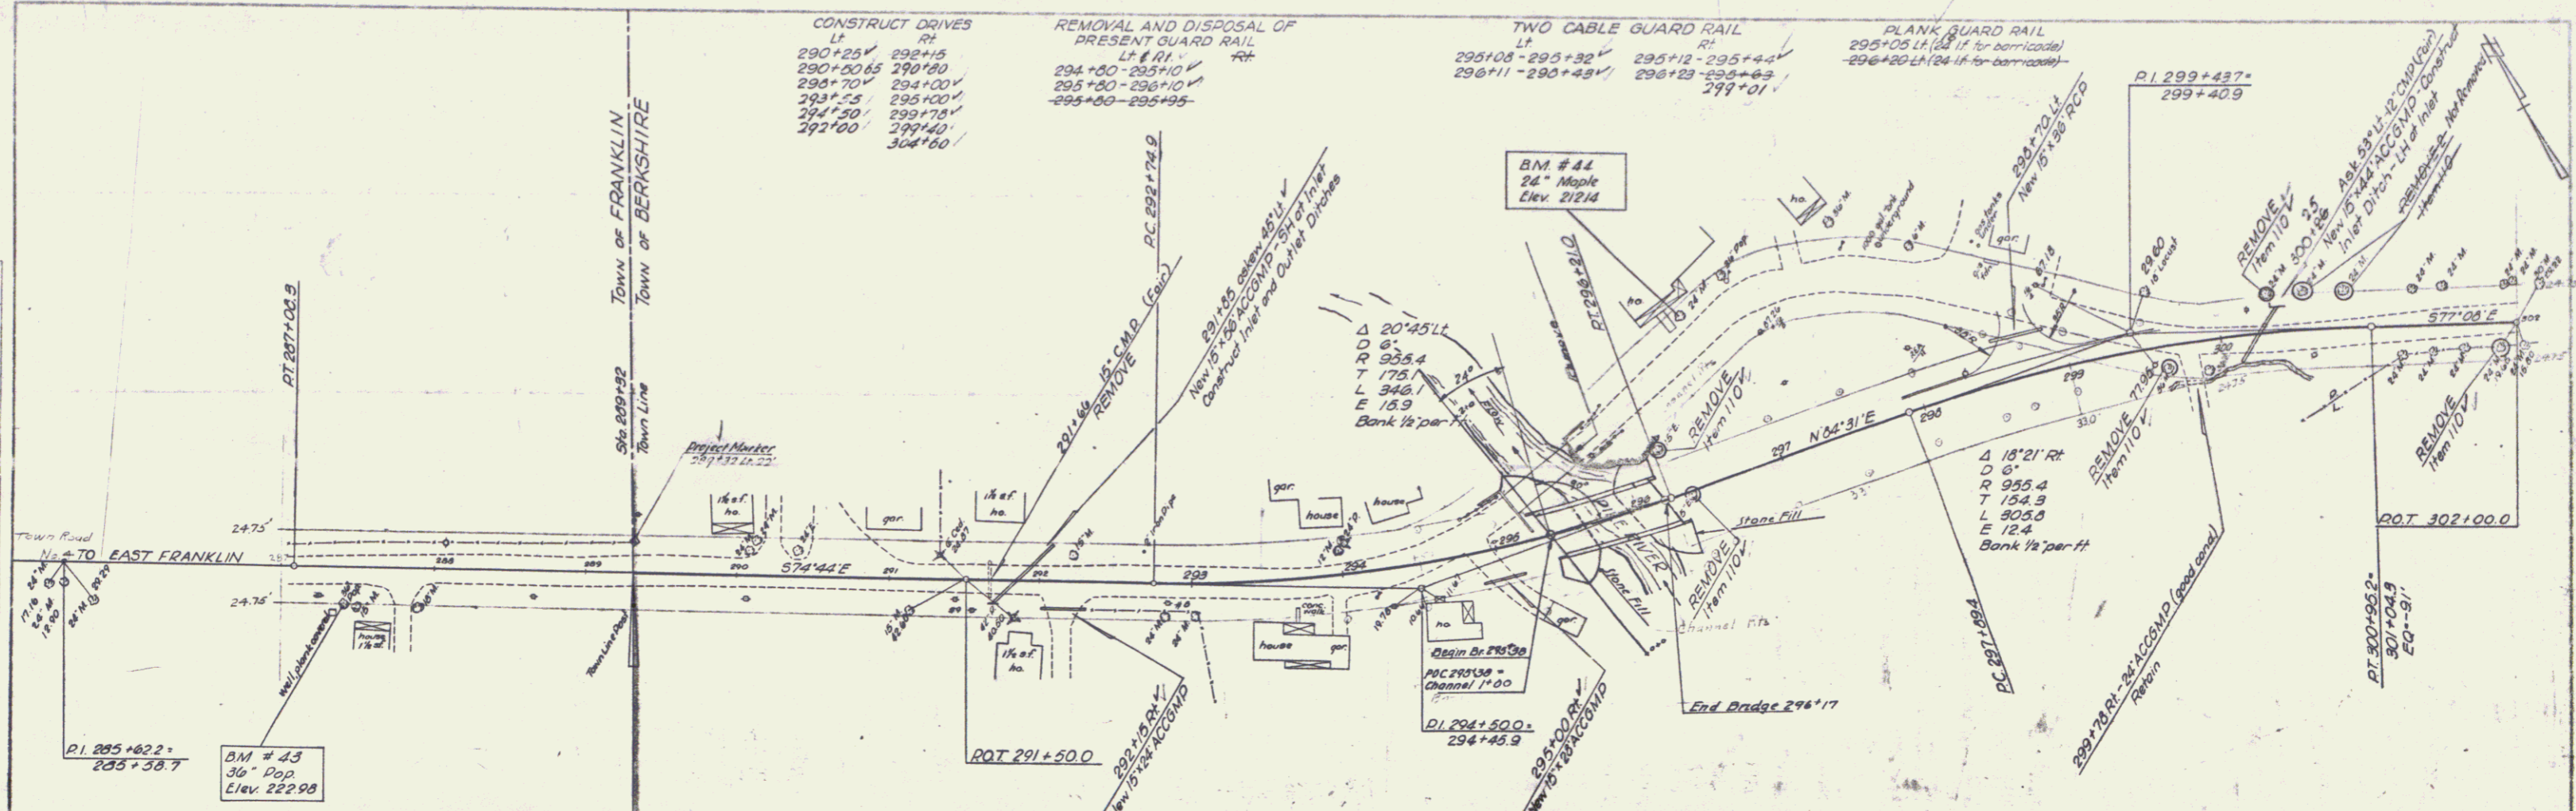

BERKSHIRE
 Proj. 5 No. 81(3)
 Sheet 7 of 26