
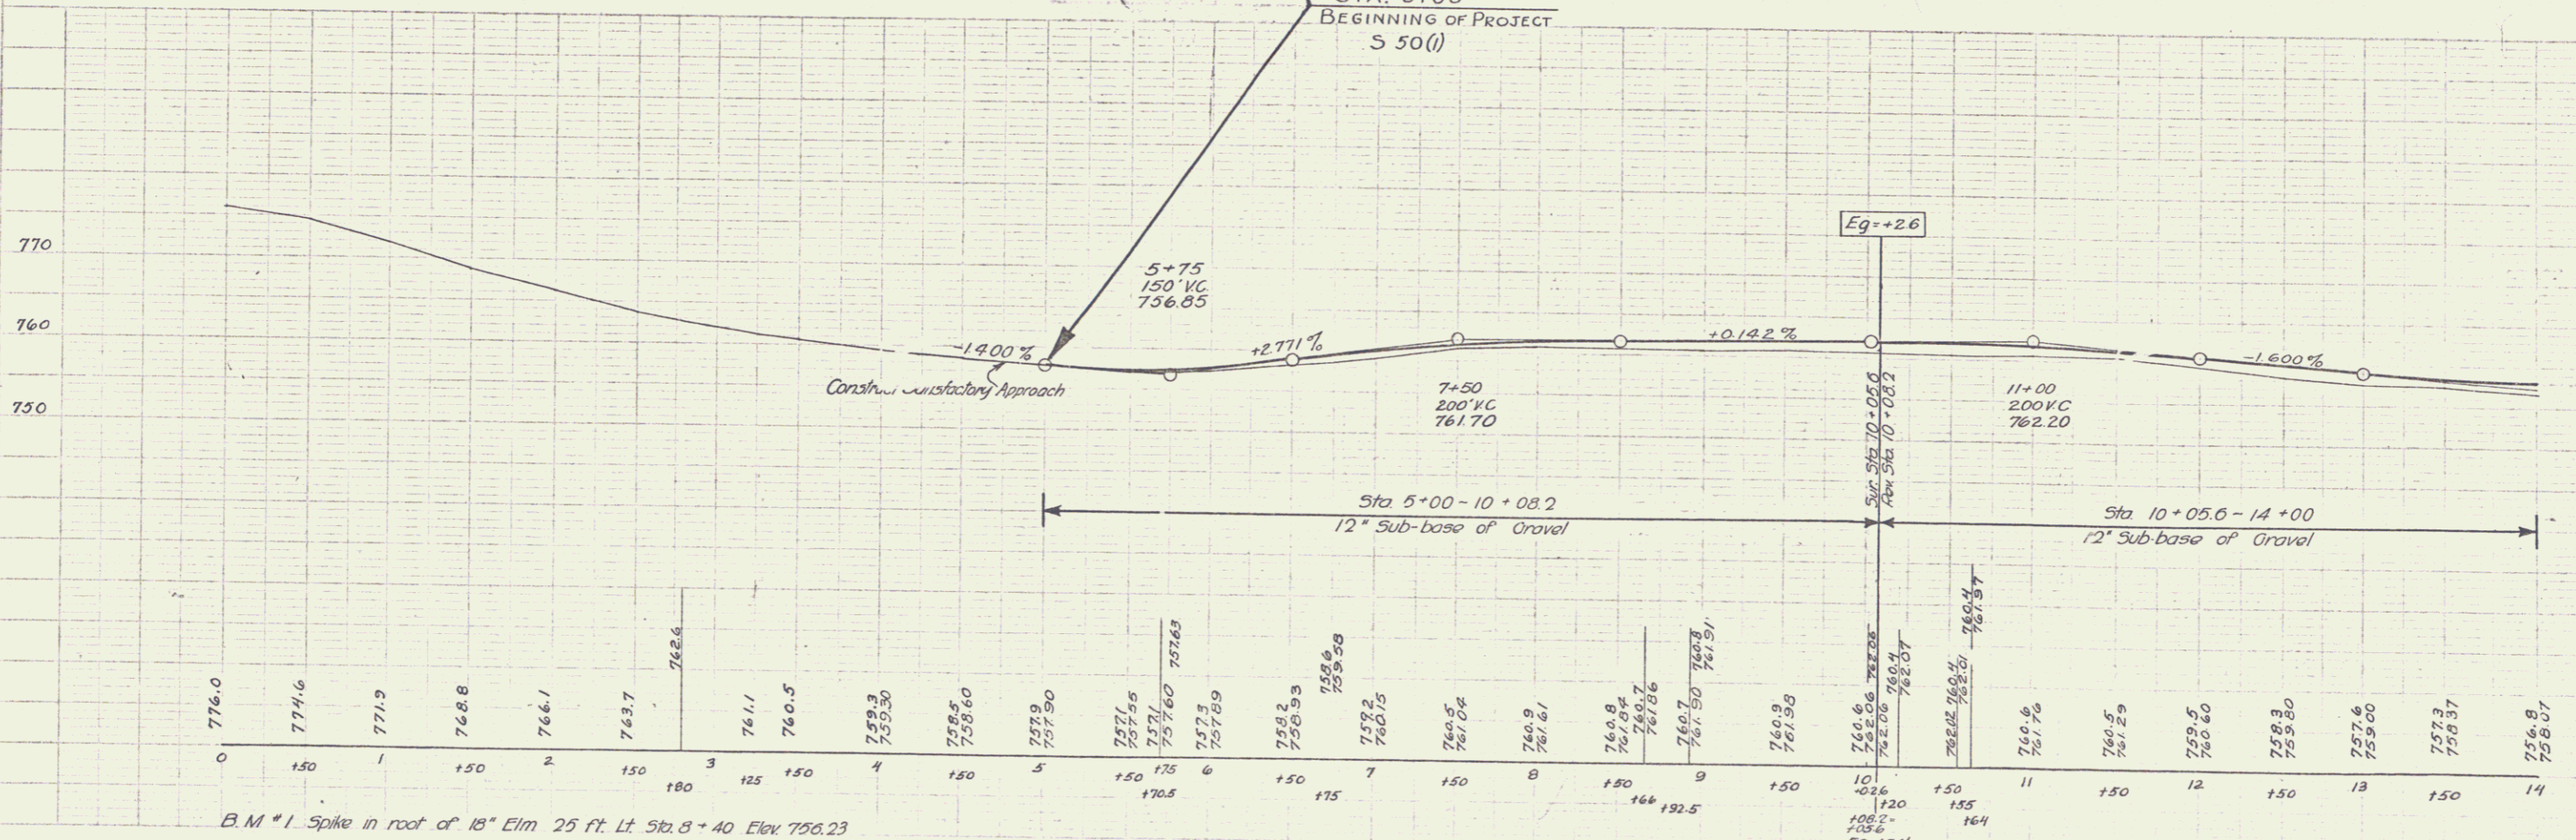


PLAN  
 11/16  
 11/16  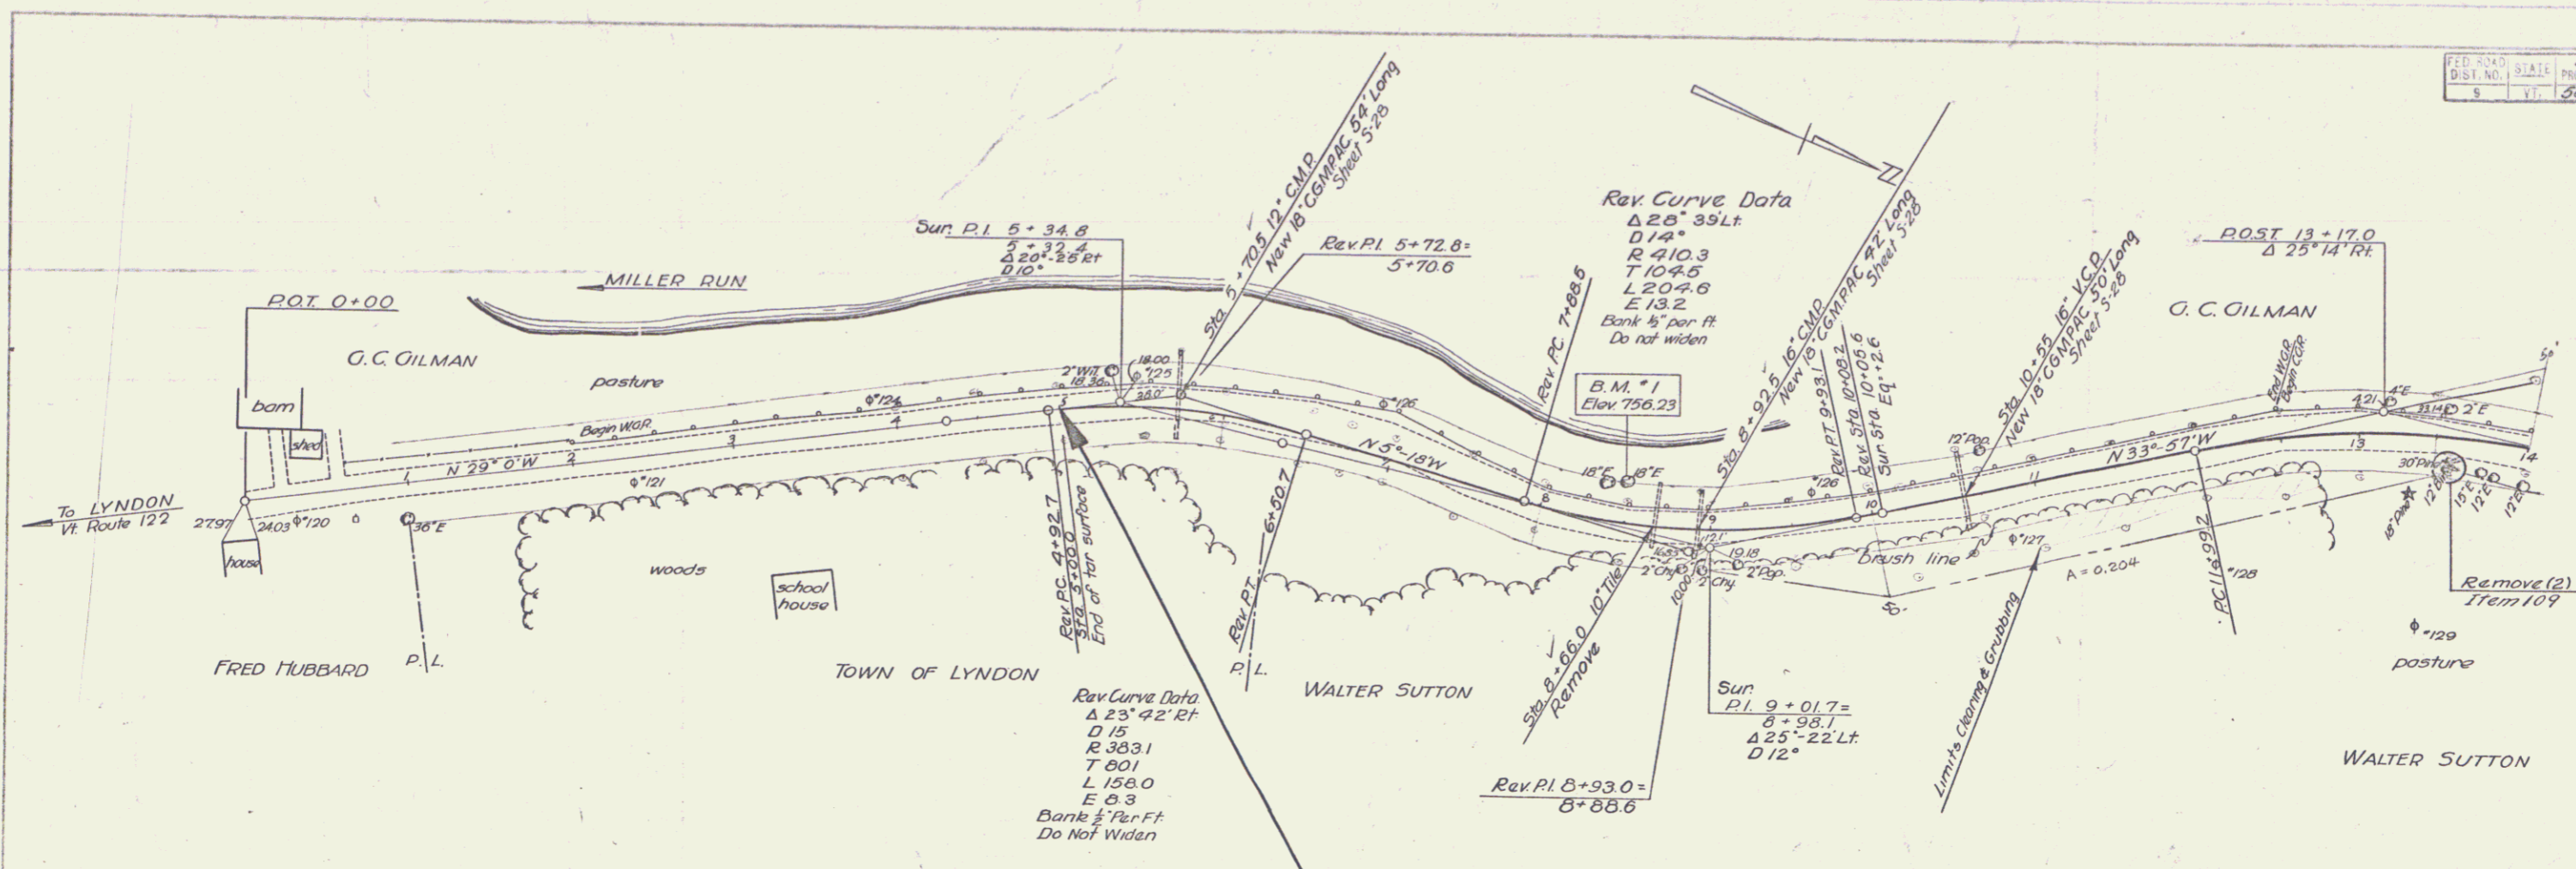
B.M. #1 Spike in roof of 18" Elm 25 ft. Lt Sta. 8+40 Elev 756.23