

INDEX OF SHEETS

1.	Title
2.	Typical (2" x 11" Cons. Pavement)
3.	Drainage and Road Quantity Sheet
4.	Earthwork and Earthwork Summary
5-6.	Plans
7-8.	Side Sheets
9.	Blank
10.	Plan and Profile
11-23.	Bridge Series 100
24.	Blank

25.	Bridge Standards
26.	E-1 Approach Signs - Bridge Construction
27.	E-2-1-1 Sheet 1 of 2
28.	E-2-1-2 Sheet 2 of 2
29.	E-2-1-3 General Information
30.	E-2-1-4 E-2-1-5 E-2-1-6
31.	Blank

32.	Bridge Standards
33.	E-3-1 Slopes in Solid Rock Escar
34.	E-3-2 Typical Slope Bounding
35.	E-3-3 Reinf. Conc. Drop Inlets
36.	E-3-4 Re Project Construction Signs
37.	E-3-5
38.	E-3-6 Wood Marker Posts
39.	E-3-7 Approach Railing (2 Rail Aluminum)
40.	E-3-8 Boundary Markers
41.	E-3-9 Temporary Erosion Control
42.	E-3-10 Temporary Erosion Control
43.	Blank
44-48.	Sections

METAL PIPES- NORTHEASTERN CULVERT CORP, WESTMINSTER, VT.
 CAST IRON GRATE/W/ FRAME- E.L. LEBARON FOUNDRY CO. INC., BROCTON, MA.
 JOINT SEALER, POLYURETHANE- KIBBY EQUIPMENT CO., WHITE RIVER JCT. VT.
 EPOXY COATING COMPOUND-
 GRANITE BRIDGE CURB- NATIONAL FENCE & GRANITE CO. INC., CONCORD, N.H.
 BOUNDARY MARKERS- GRISWOLD FENCE CO. INC., ESSEX JCT. VT.
 WOOD MARKER POSTS-
 SEED, FERTILIZER, LIMESTONE- OLD FOX CHEMICAL CO., LYNDONVILLE, VT.

CONTRACT DATED- SEPT. 9, 1974
 CONTRACT STARTED- SEPT. 18, 1974
 CONTRACT COMPLETED- AUG. 29, 1975
 CONTRACT ACCEPTED- SEPT. 4, 1975

CONTRACTOR- MORSE CONSTR. CO.
 ST. JOHNSBURY, VT.
 RESIDENT ENGR- SIDNEY ACHILLES
 RECORD PLANS- S.C. MURRAY
 COMPLETED- AUG. 29, 1975

CONVENTIONAL SIGNS

COUNTY LINE	---
TOWN LINE	---
LIMITS OF ACCESS	---
POINT OF ACCESS	X
FENCE LINE	---
STONE WALL	---
TRAVELED WAY	---
RAILROAD	---
SURVEY LINE	---
CULVERT	---
POWER POLE	---
TELEPHONE POLE	---
TREES	---
F.A. CONSTRUCTION SIGNS	---
PROPERTY LINE	---
R.O.W. TAILING LINE	---
SLOPE RIGHTS	---
TOP OF CUT	---
TOE OF SLOPE	---

WHEELOCK RS 0259 (2) RECORD PLANS MATERIALS

GRAN. BKE FOR STRUCTURES- BRILLFIT, WHEELOCK, VT.
 SUBBASE OF GRAVEL-
 EMULSIFIED ASPHALT } PIKE INDUSTRIES INC., WATERFORD, VT.
 BITUMINOUS CONCRETE PAV. }
 CONCRETE CL. A & B - CALKINS REDIMIX CONCRETE, LYNDONVILLE, VT.
 STRUCTURAL STEEL
 BRIDGE RAILING- 2 RAIL ALUM. } VISTRUCT. STEEL CORP.
 APPROACH RAILING- 2 RAIL ALUM. } BURL. VT.
 REINF. STEEL- BETHLEHEM STEEL CO.
 SHEAR CONNECTORS- NELSON STUD WELDING CO.
 UNITED GARR DIV. T.R.W. INC. - LORRAIN, CO.
 SHEET MEMBRANE WATERPROOFING- PROTECTO WRAP CO.,
 DENVER, COLO.

STATE OF VERMONT DEPARTMENT OF HIGHWAYS



FEDERAL AID SECONDARY

PROPOSED IMPROVEMENT

TOWN OF WHEELOCK



COUNTY OF CALEDONIA

VT. ROUTE #122

BEGINNING AT A POINT ON VERMONT ROUTE
 NUMBER 122 IN THE TOWN OF WHEELOCK,
 0.465 MILE SOUTHEASTERLY OF THE WHEELOCK-
 SHEFFIELD TOWN LINE AND EXTENDING SOUTH-
 EASTERLY 0.170 MILE.

LENGTH OF ROADWAY 0.153 MI.
 LENGTH OF BRIDGE 0.017 MI.
 LENGTH OF PROJECT 0.170 MI.

1973 ADT	485
1993 ADT	753
1993 DHV	110
D	53%
T	5%
V	40 MPH

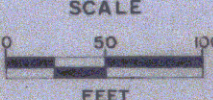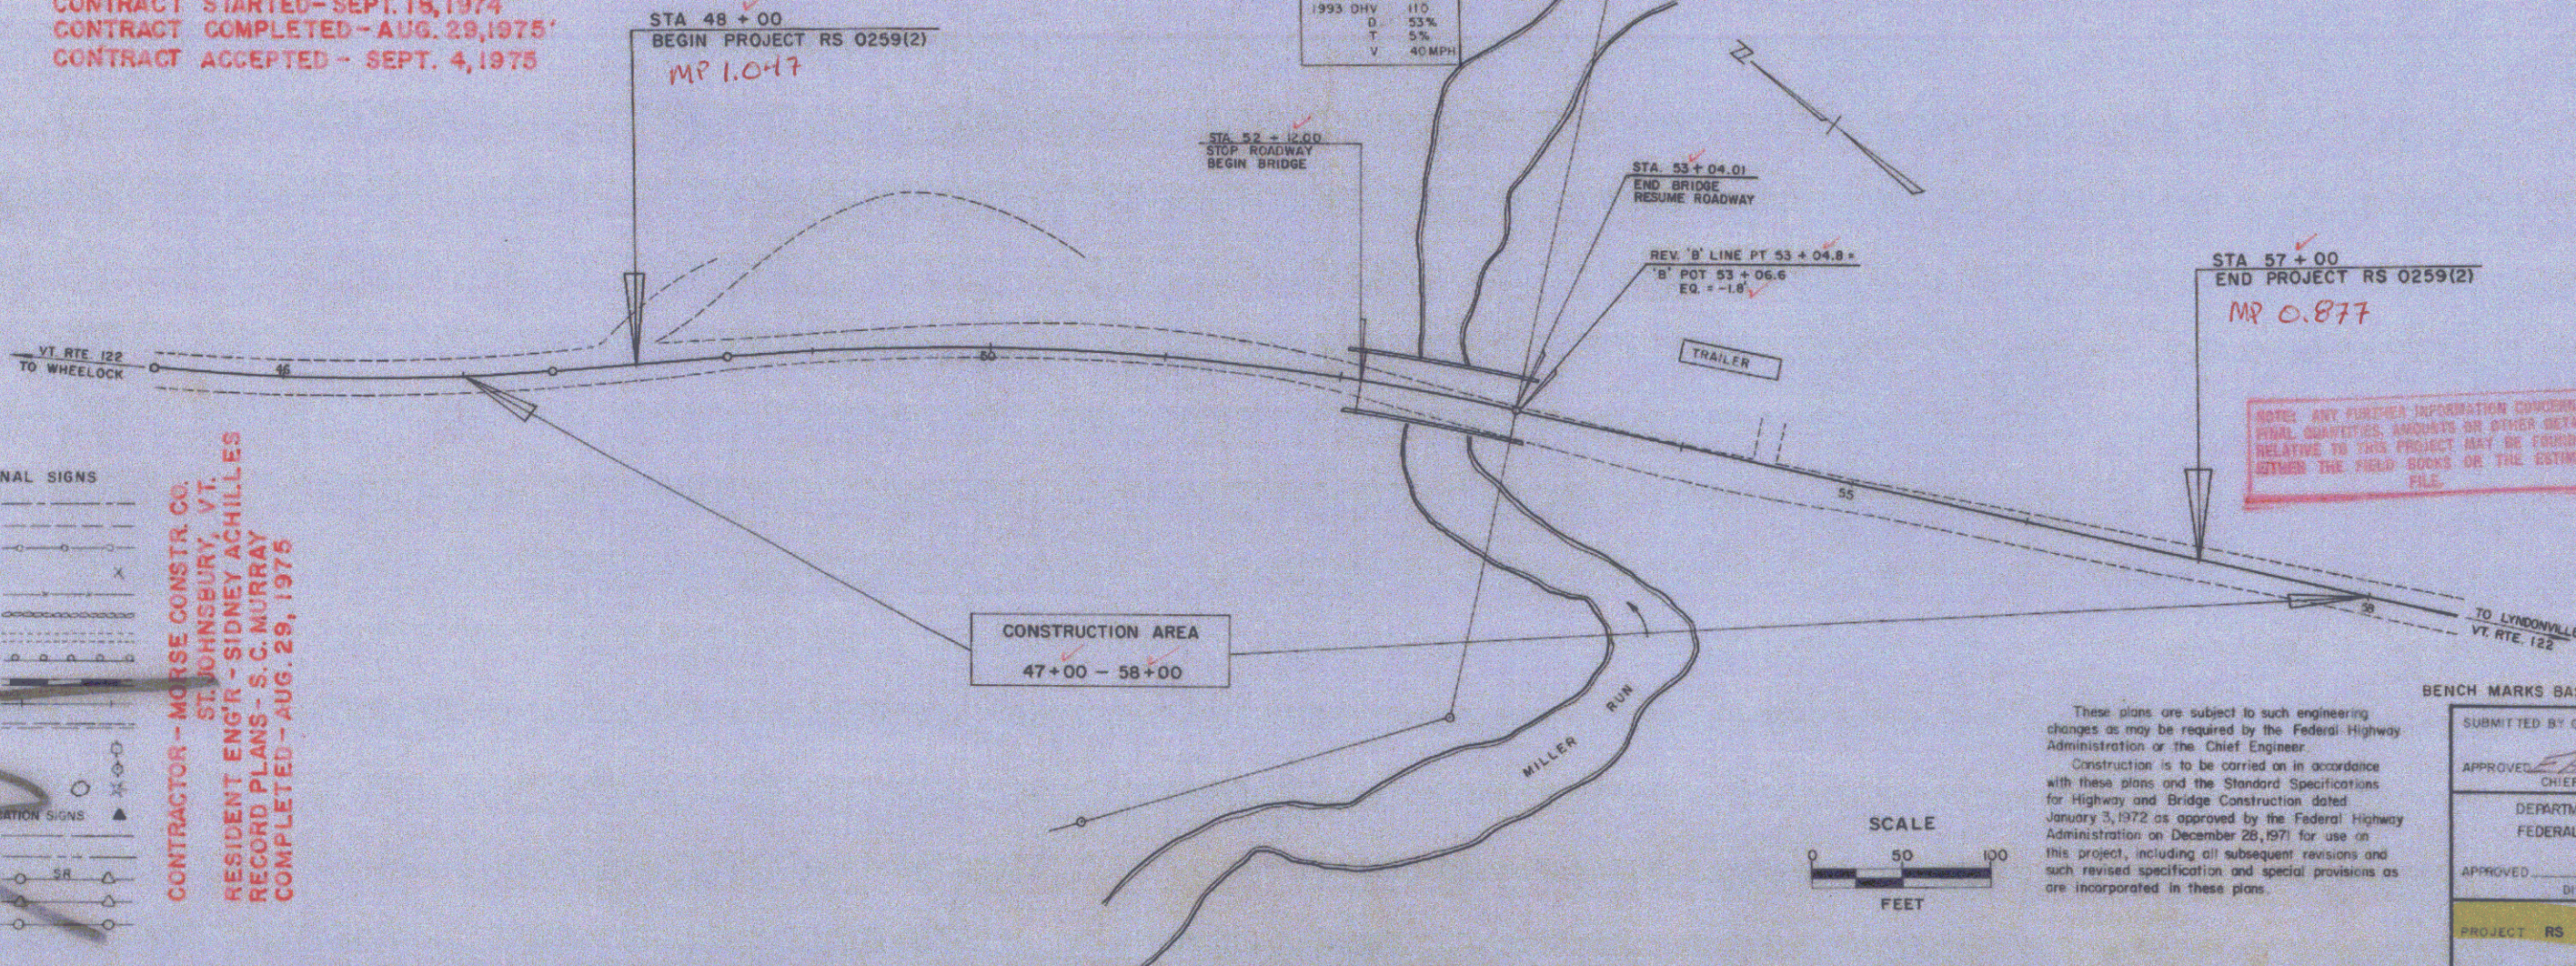

These plans are subject to such engineering
 changes as may be required by the Federal Highway
 Administration or the Chief Engineer.
 Construction is to be carried on in accordance
 with these plans and the Standard Specifications
 for Highway and Bridge Construction dated
 January 3, 1972 as approved by the Federal Highway
 Administration on December 28, 1971 for use on
 this project, including all subsequent revisions and
 such revised specification and special provisions as
 are incorporated in these plans.

BENCH MARKS BASED ON U.S.G.S. ELEVATIONS

SUBMITTED BY ORDER OF THE STATE HIGHWAY BOARD

APPROVED: *[Signature]* DATE: July 74
 CHIEF ENGINEER


DEPARTMENT OF TRANSPORTATION
 FEDERAL HIGHWAY ADMINISTRATION

APPROVED: _____ DATE: _____
 DIVISION ENGINEER

PROJECT RS 47 0259 (2)

SHEET 1 OF 48 SHEETS

D-10 SRS 12/17/70

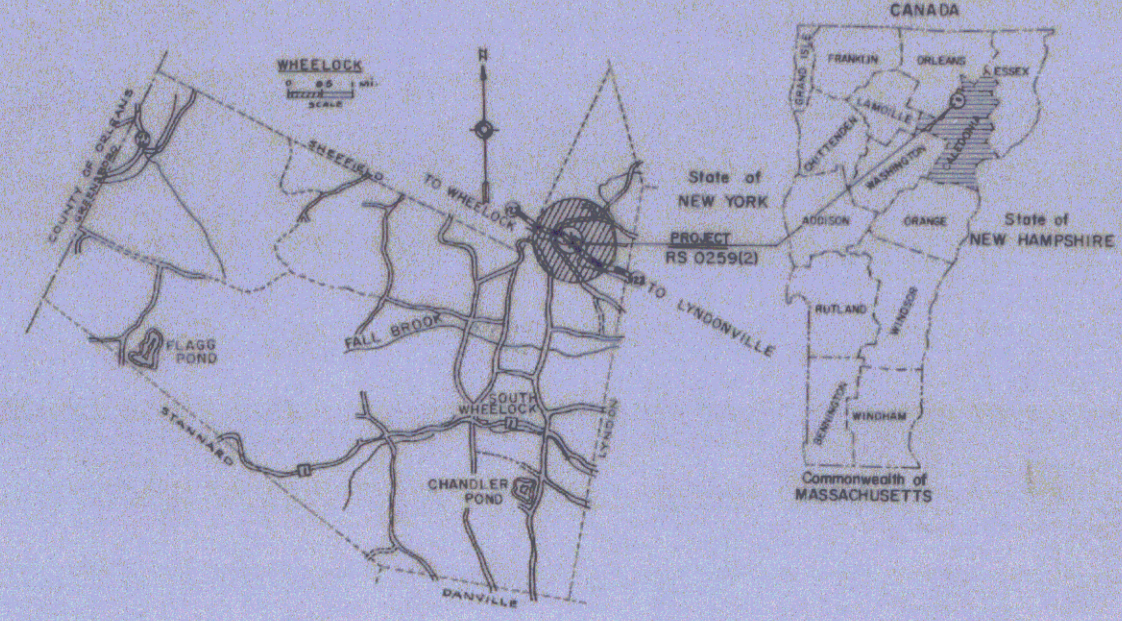

Pin # 992599
 Date 4/30/1974