

PLAN
 SHEET NO. 13 OF 69
 NOTE BOOK TO WHICH REFERRED
 DATE 10/1/54
 PROJECT
 SHEET NO. 13 OF 69

PROFILE
 SHEET NO. 13 OF 69
 NOTE BOOK TO WHICH REFERRED
 DATE 10/1/54
 PROJECT
 SHEET NO. 13 OF 69

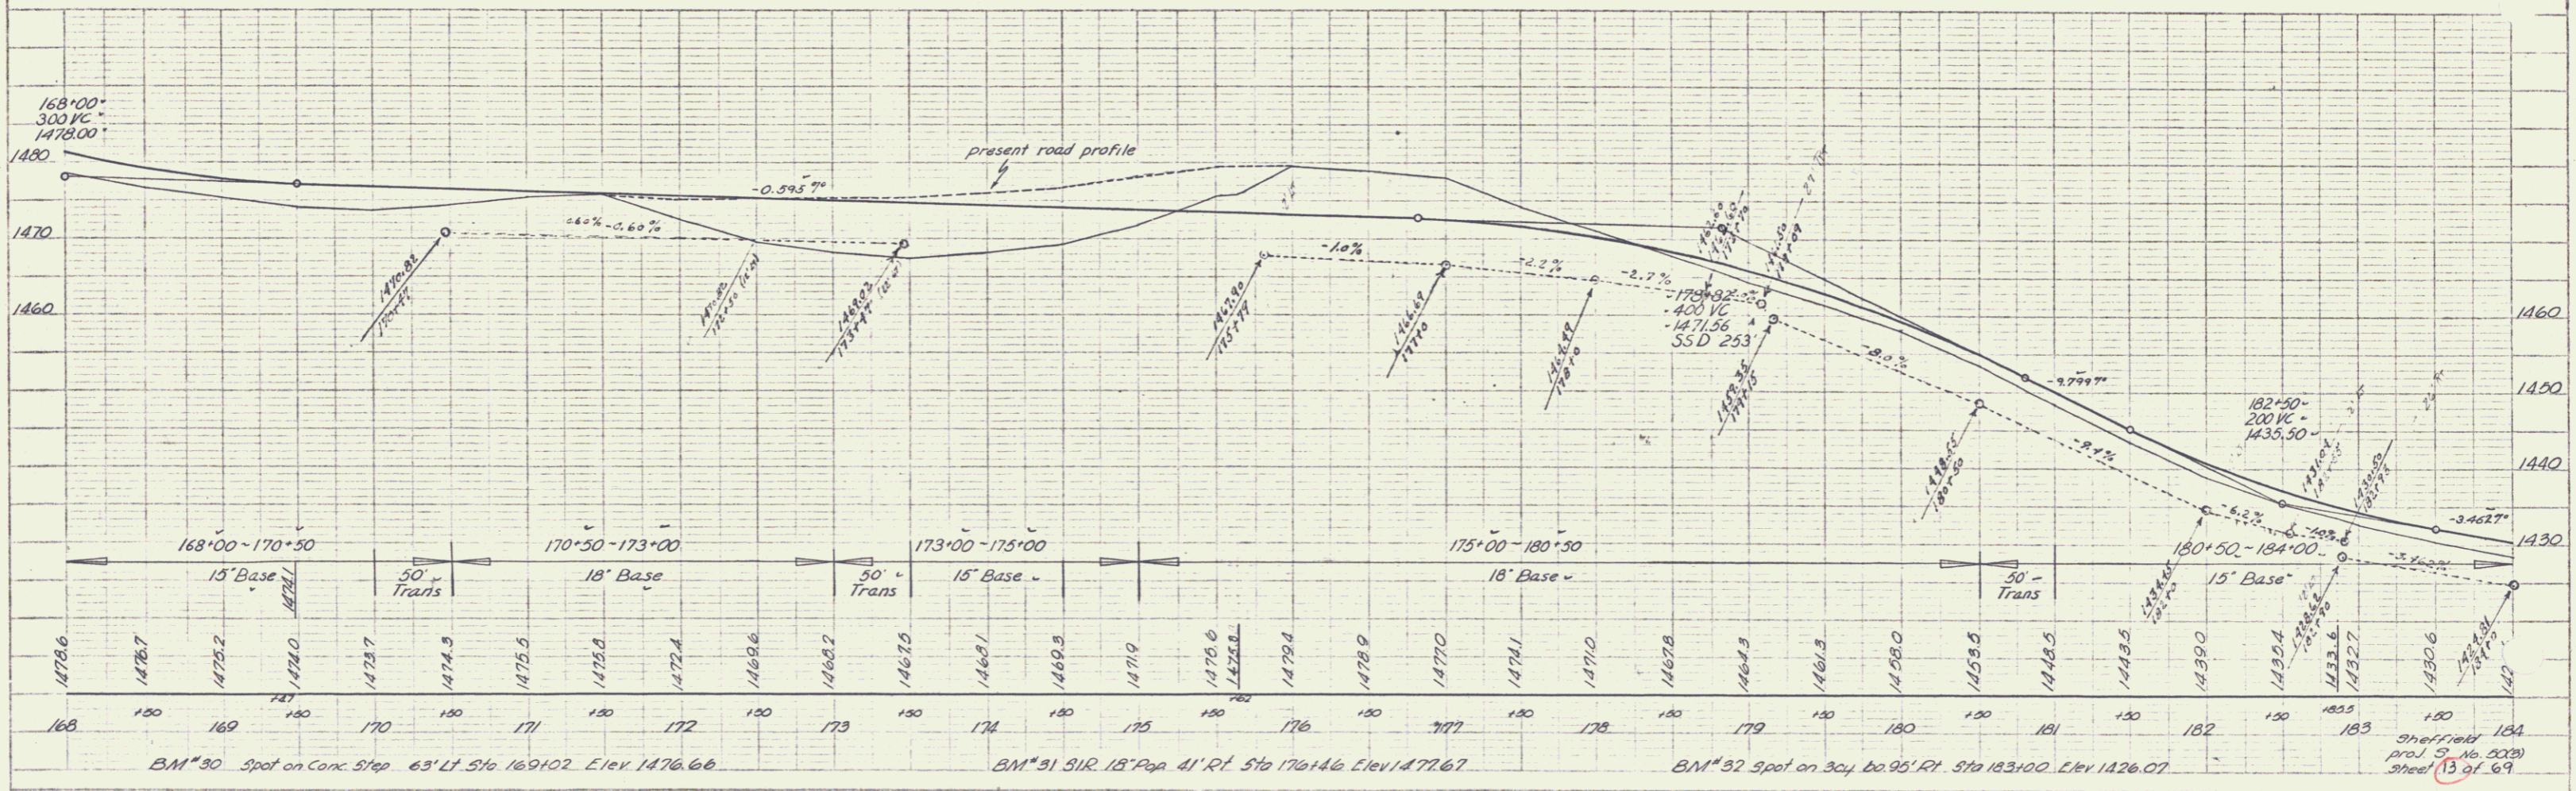
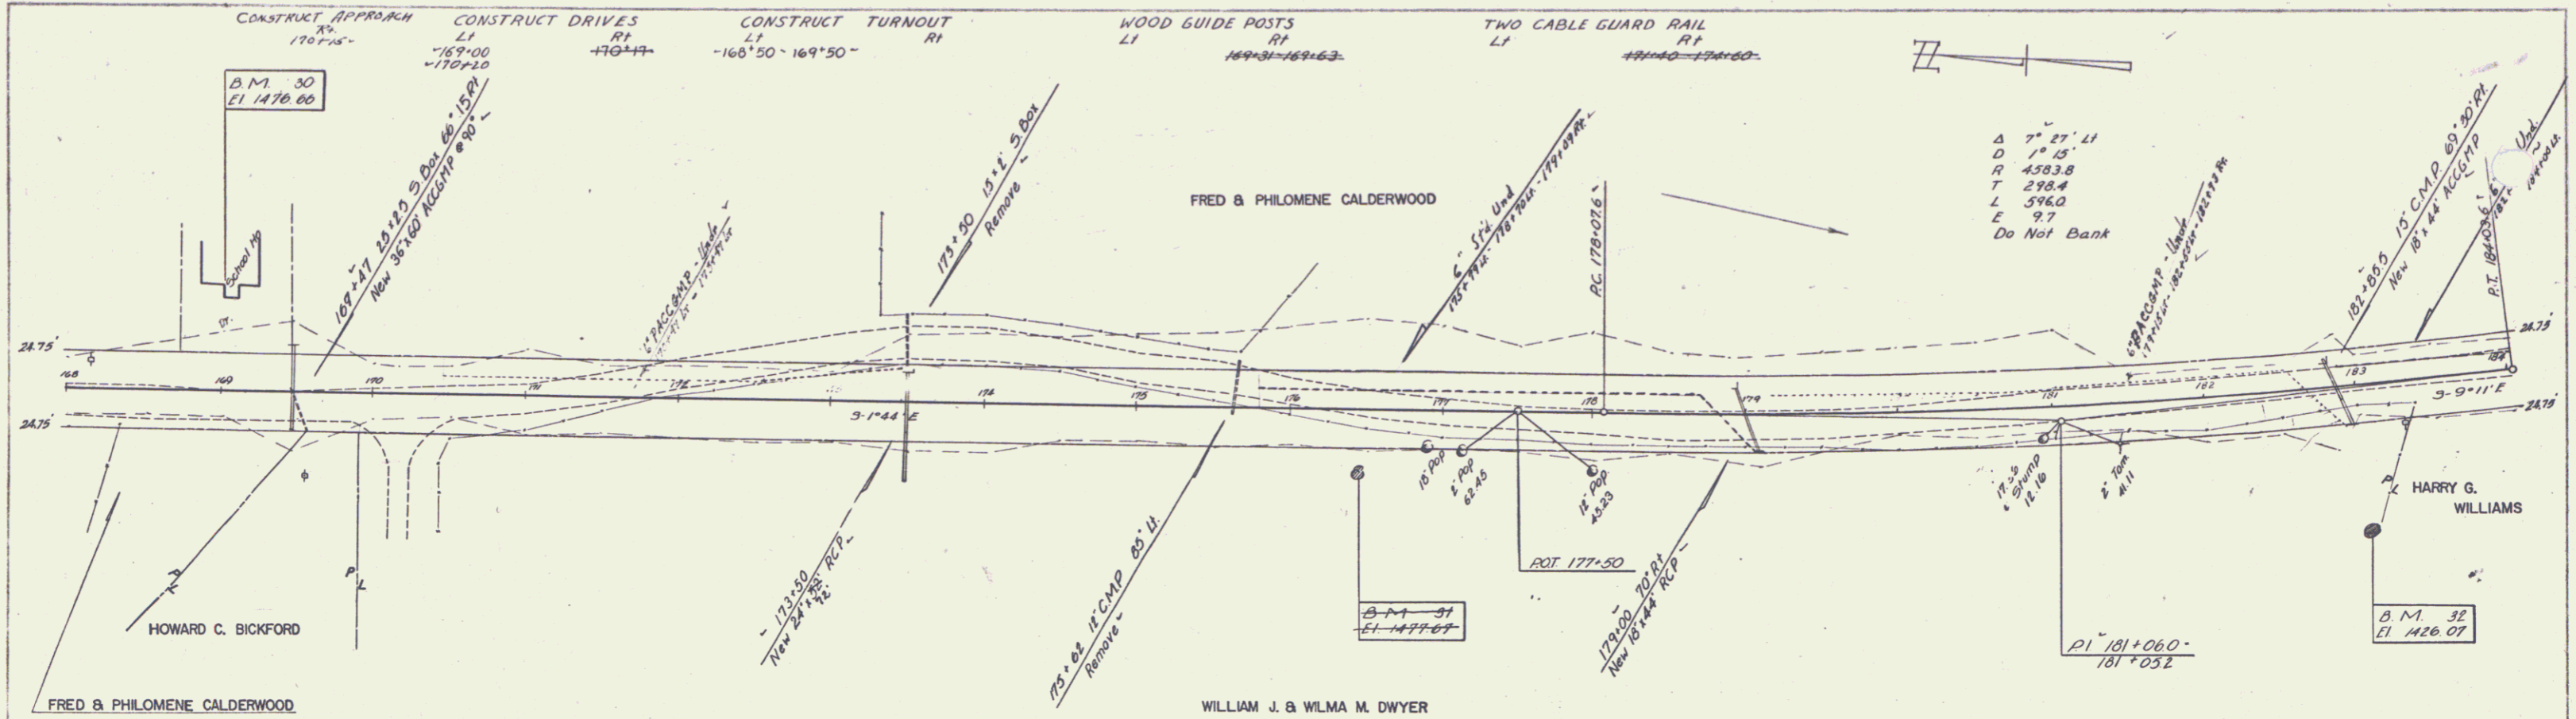


PLATE 11 - ROAD PROFILE
 SHEET NO. 13 OF 69