

PLAN  
 SHEET NO. 1166  
 DATE 10/1/68  
 DRAWN BY [Signature]  
 CHECKED BY [Signature]

PROFILE  
 SHEET NO. 1166  
 DATE 10/1/68  
 DRAWN BY [Signature]  
 CHECKED BY [Signature]

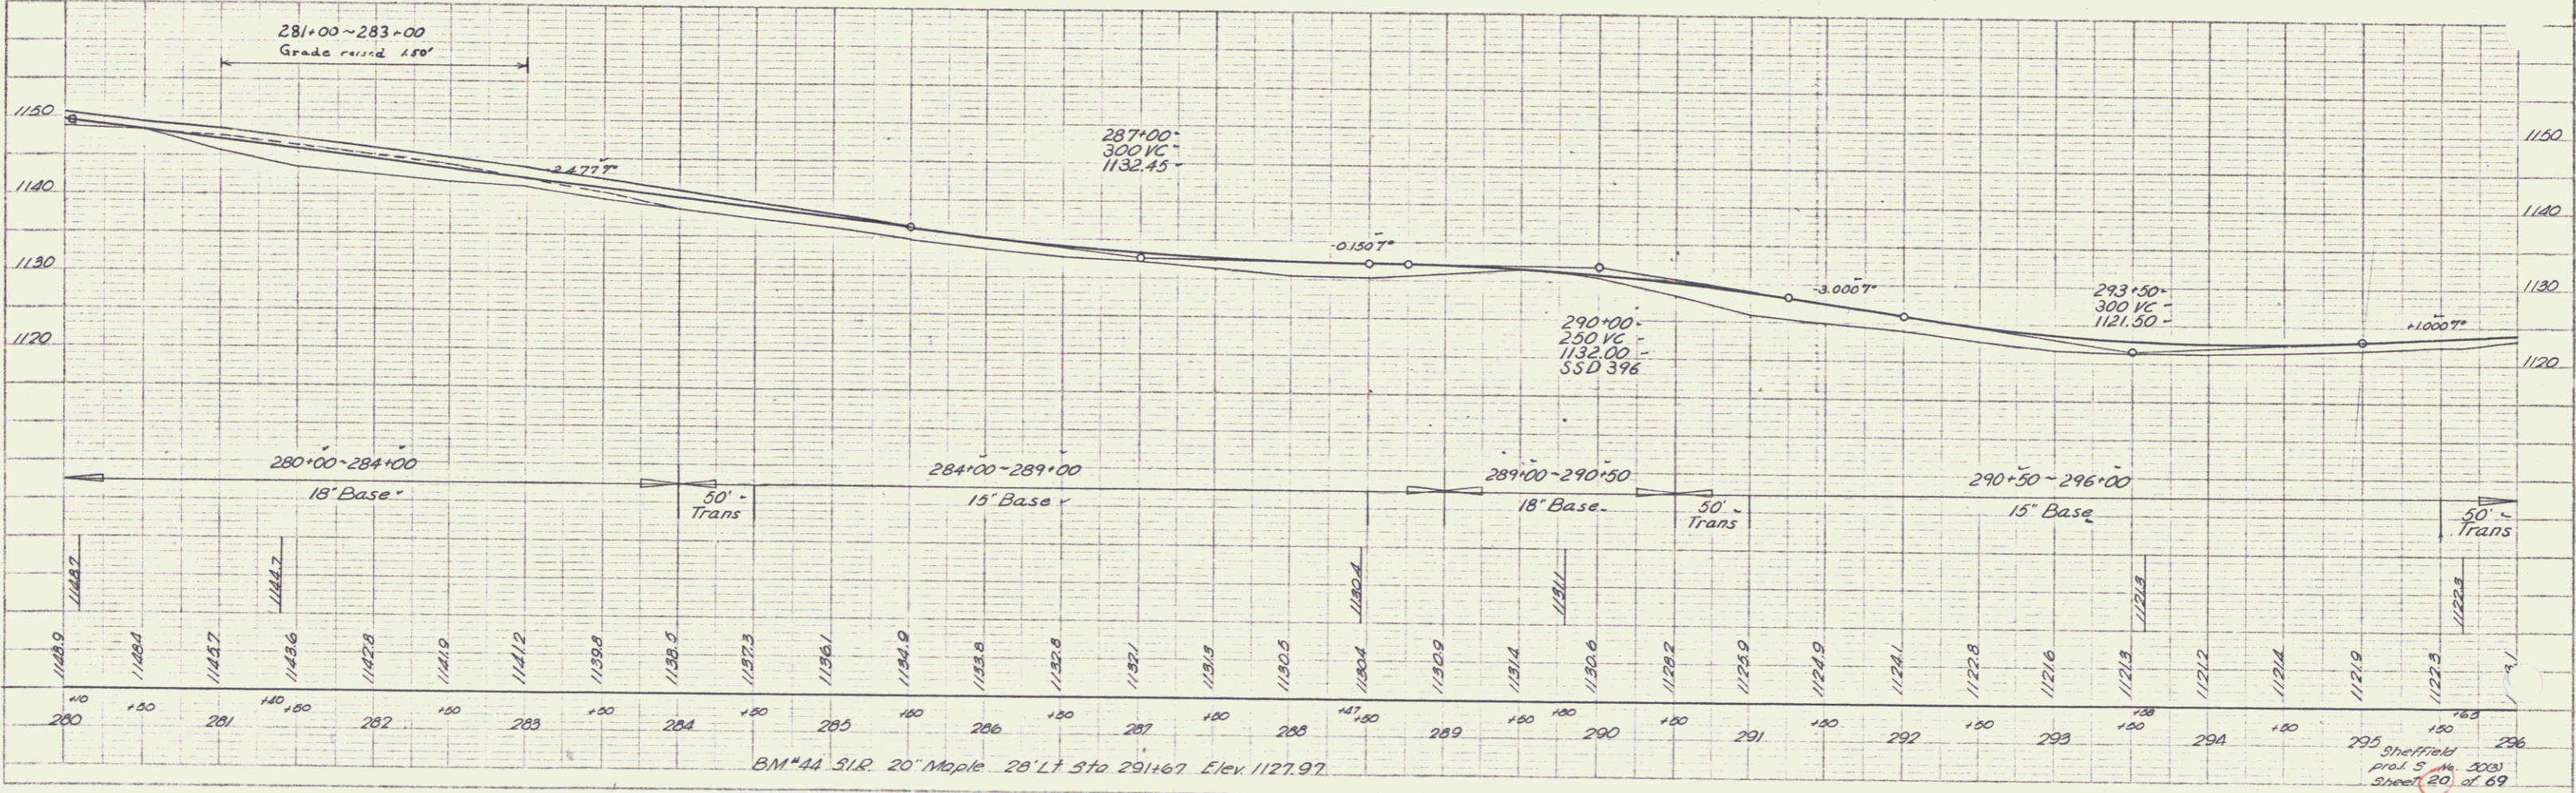
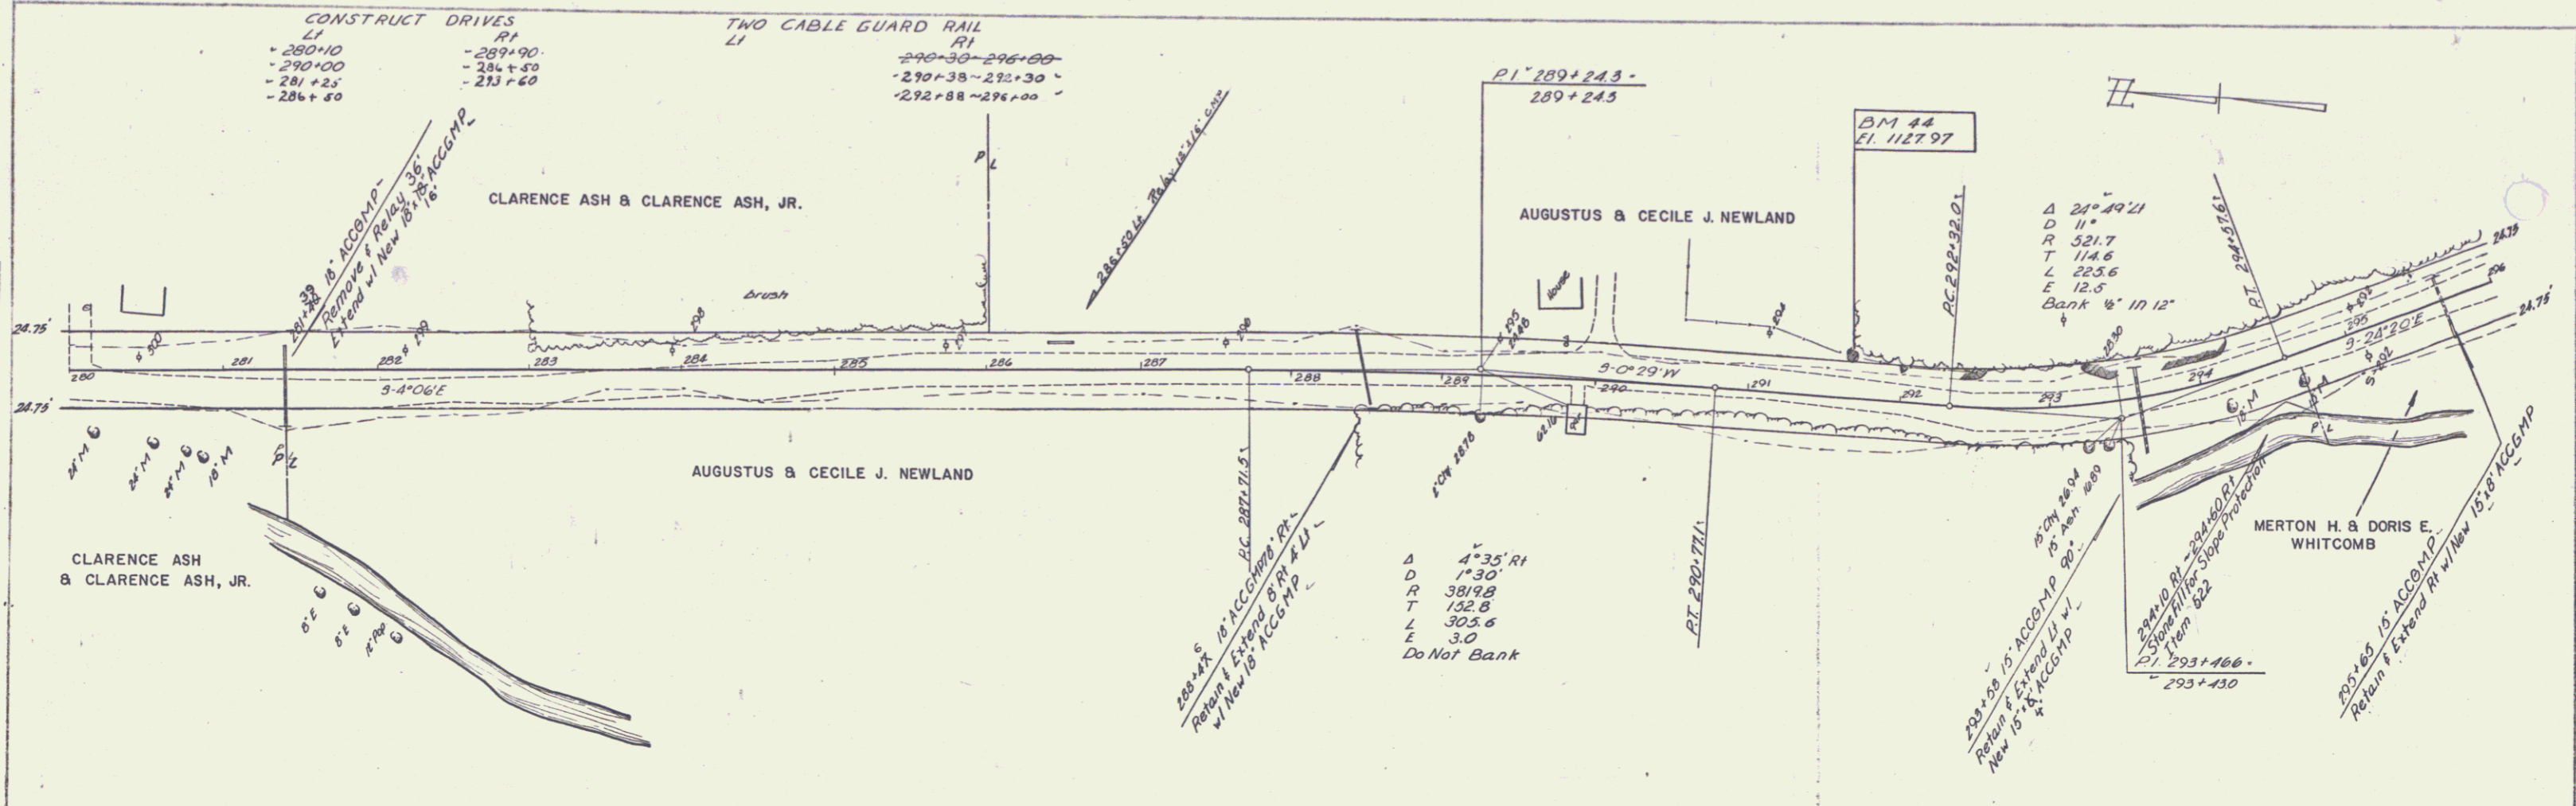


PLATE 1 - PLAN PROFILE  
 SHEET NO. 1166  
 DATE 10/1/68