
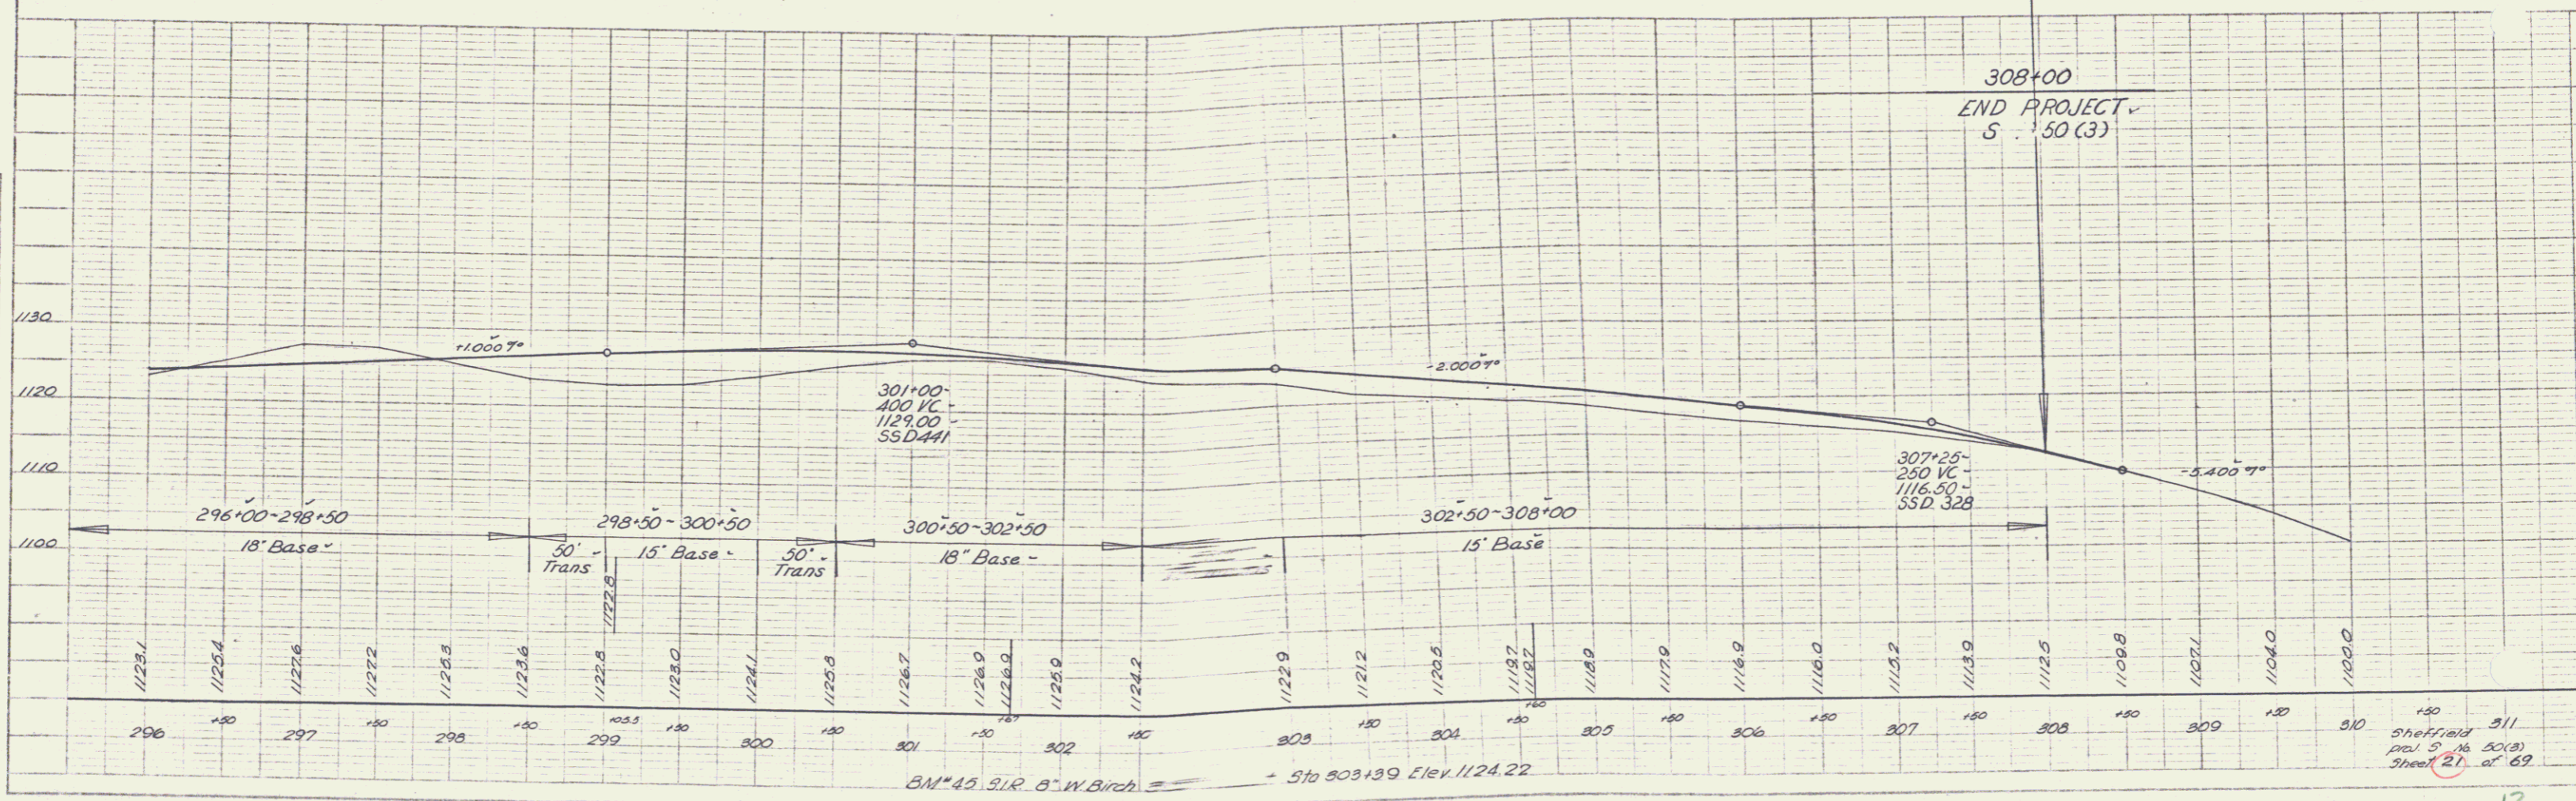


P.L.W. SHEFFIELD  
 CIVIL ENGINEER  
 1100 S. 10th St.  
 Lincoln, Nebraska 68502  
 PHONE 338-1111  
 FAX 338-1112  
 SHEFFIELD ENGINEERING & ARCHITECTURE  
 1100 S. 10th St.  
 Lincoln, Nebraska 68502  
 PHONE 338-1111  
 FAX 338-1112

PROFILE  
 NOTE BOOK  
 SHEET NO. 21  
 OF 69

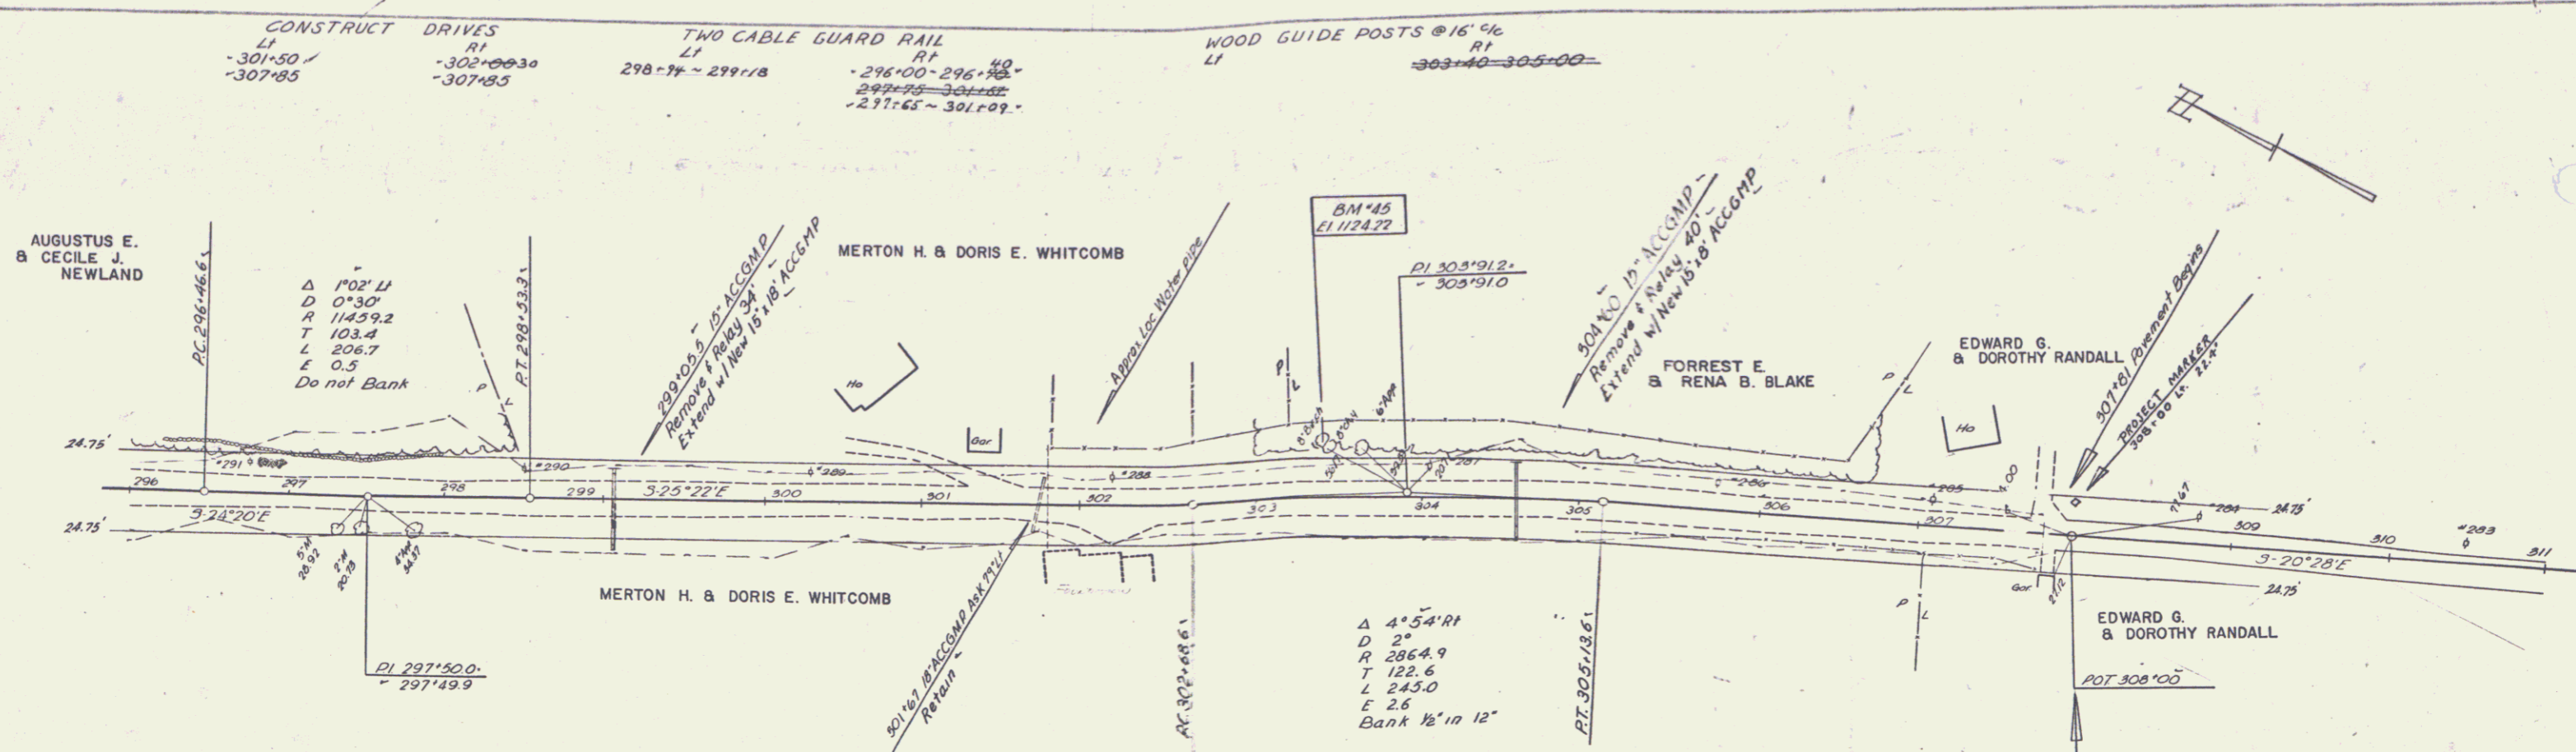

150  
 311  
 Sheffield  
 pol 5 16 50(8)  
 Sheet 21  
 of 69