



Plank Guard Rail
34+18 Lt & Rt 24 in ft, each

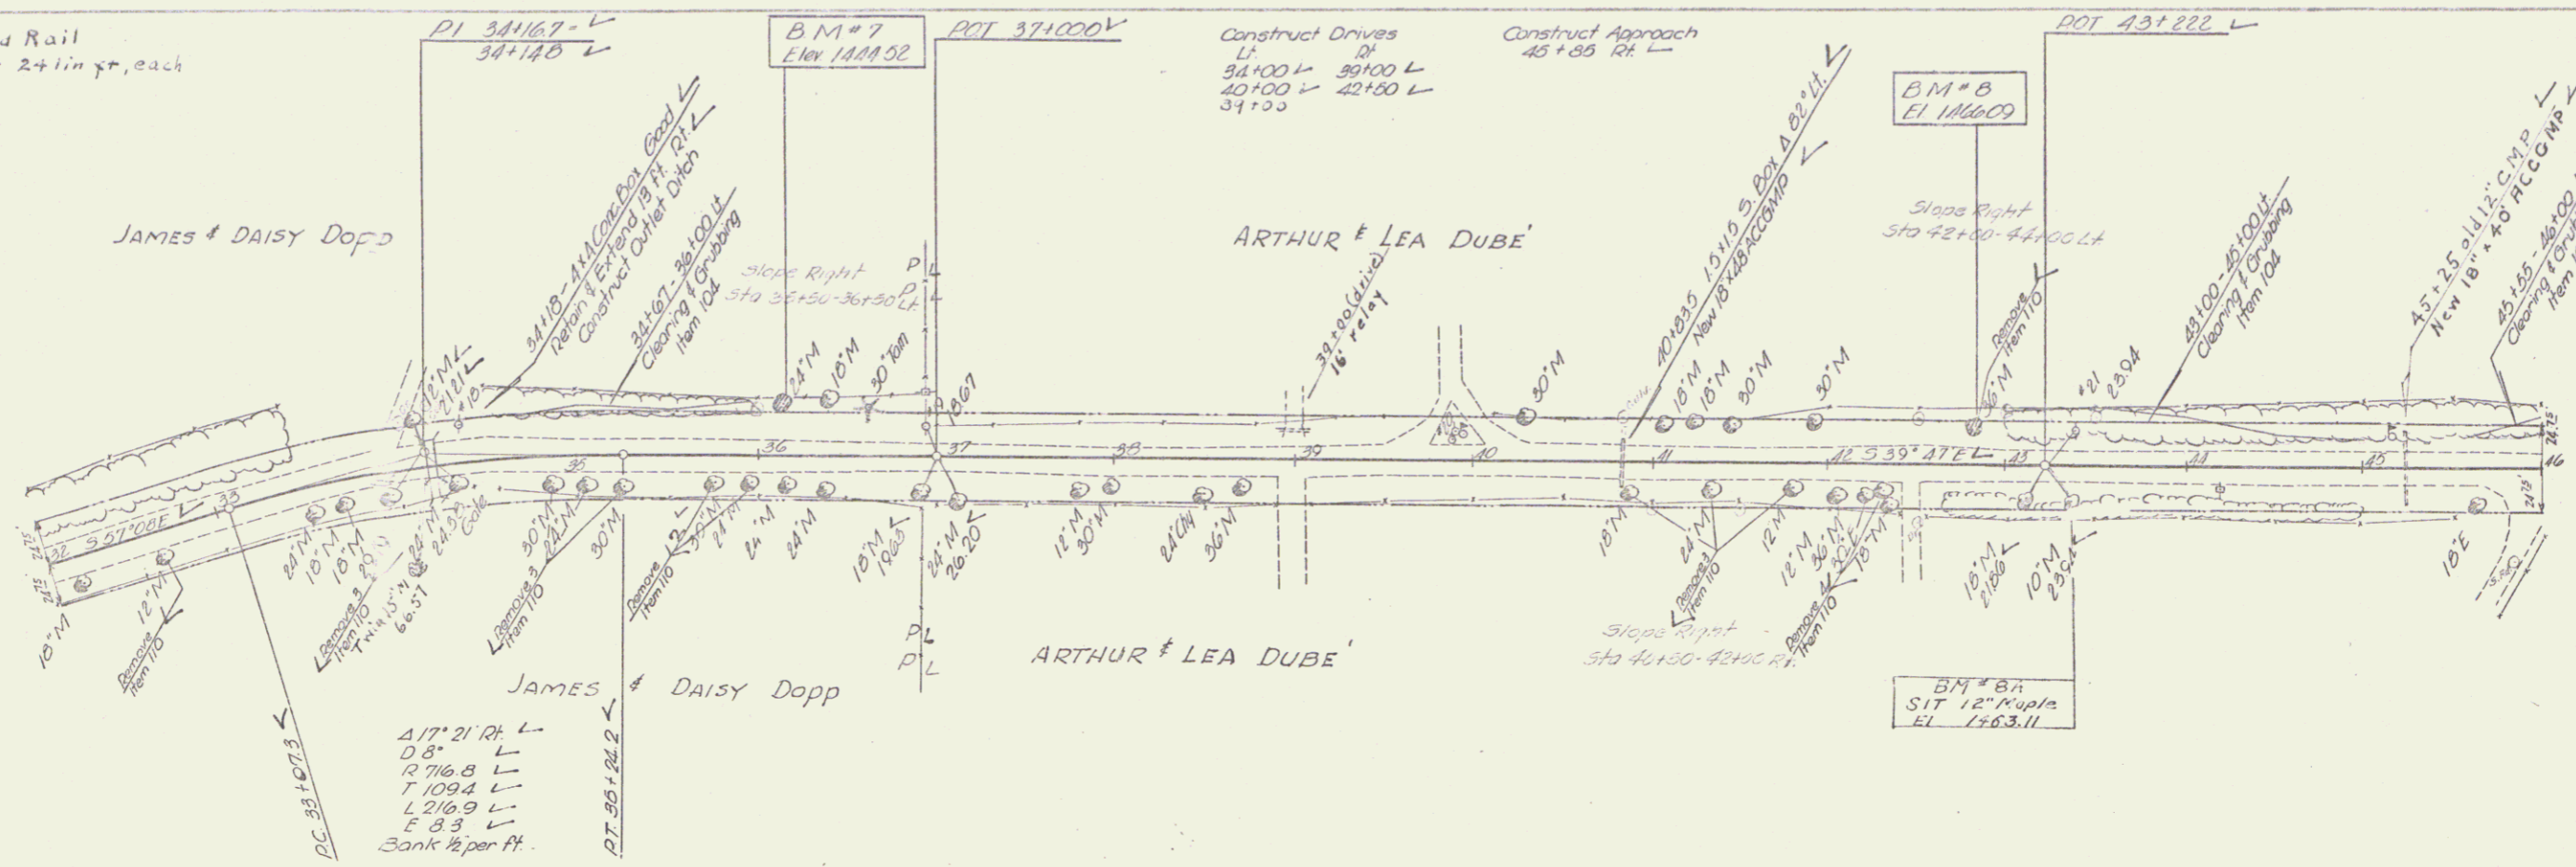

PAV	1.00
GRAV	1.00
BASE	1.00
FINISH	1.00
TOTAL	4.00

GRAV	1.00
BASE	1.00
FINISH	1.00
TOTAL	3.00

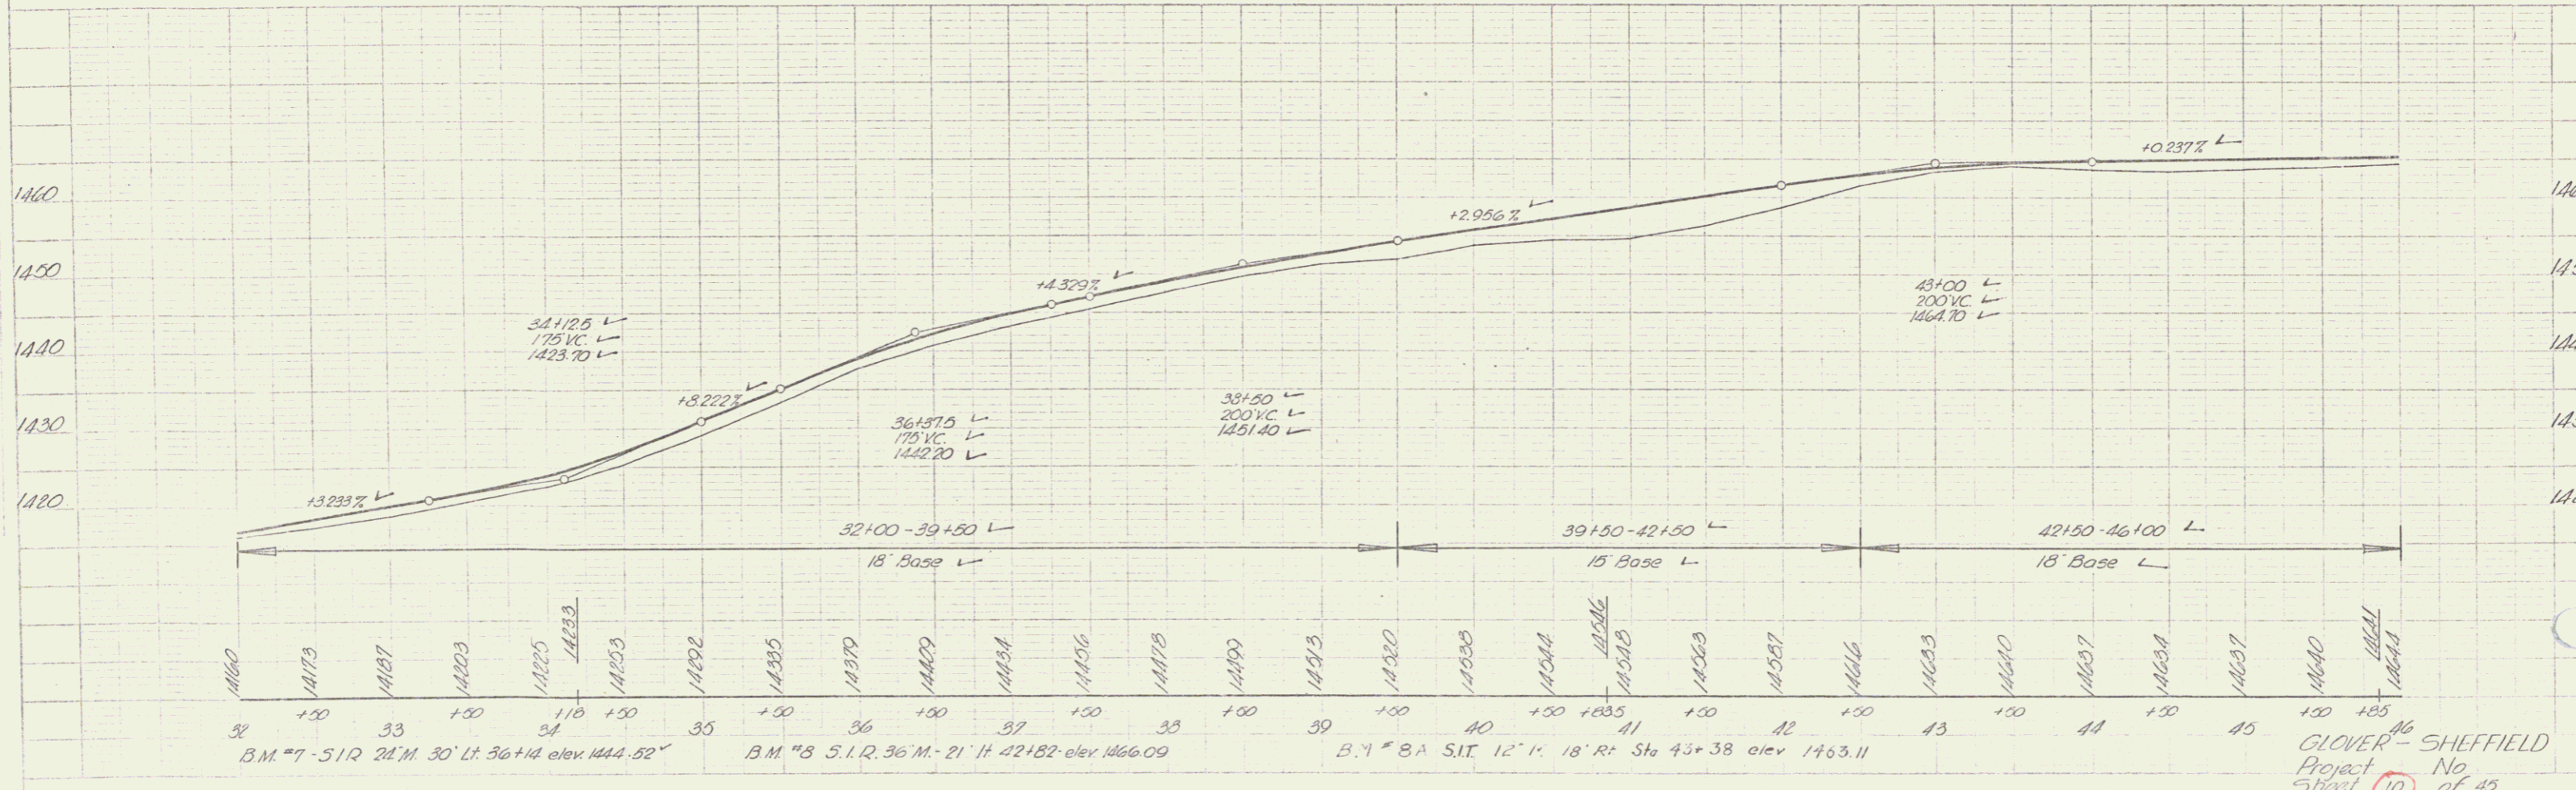

GLOVER - SHEFFIELD
Project No. 10 of 45