
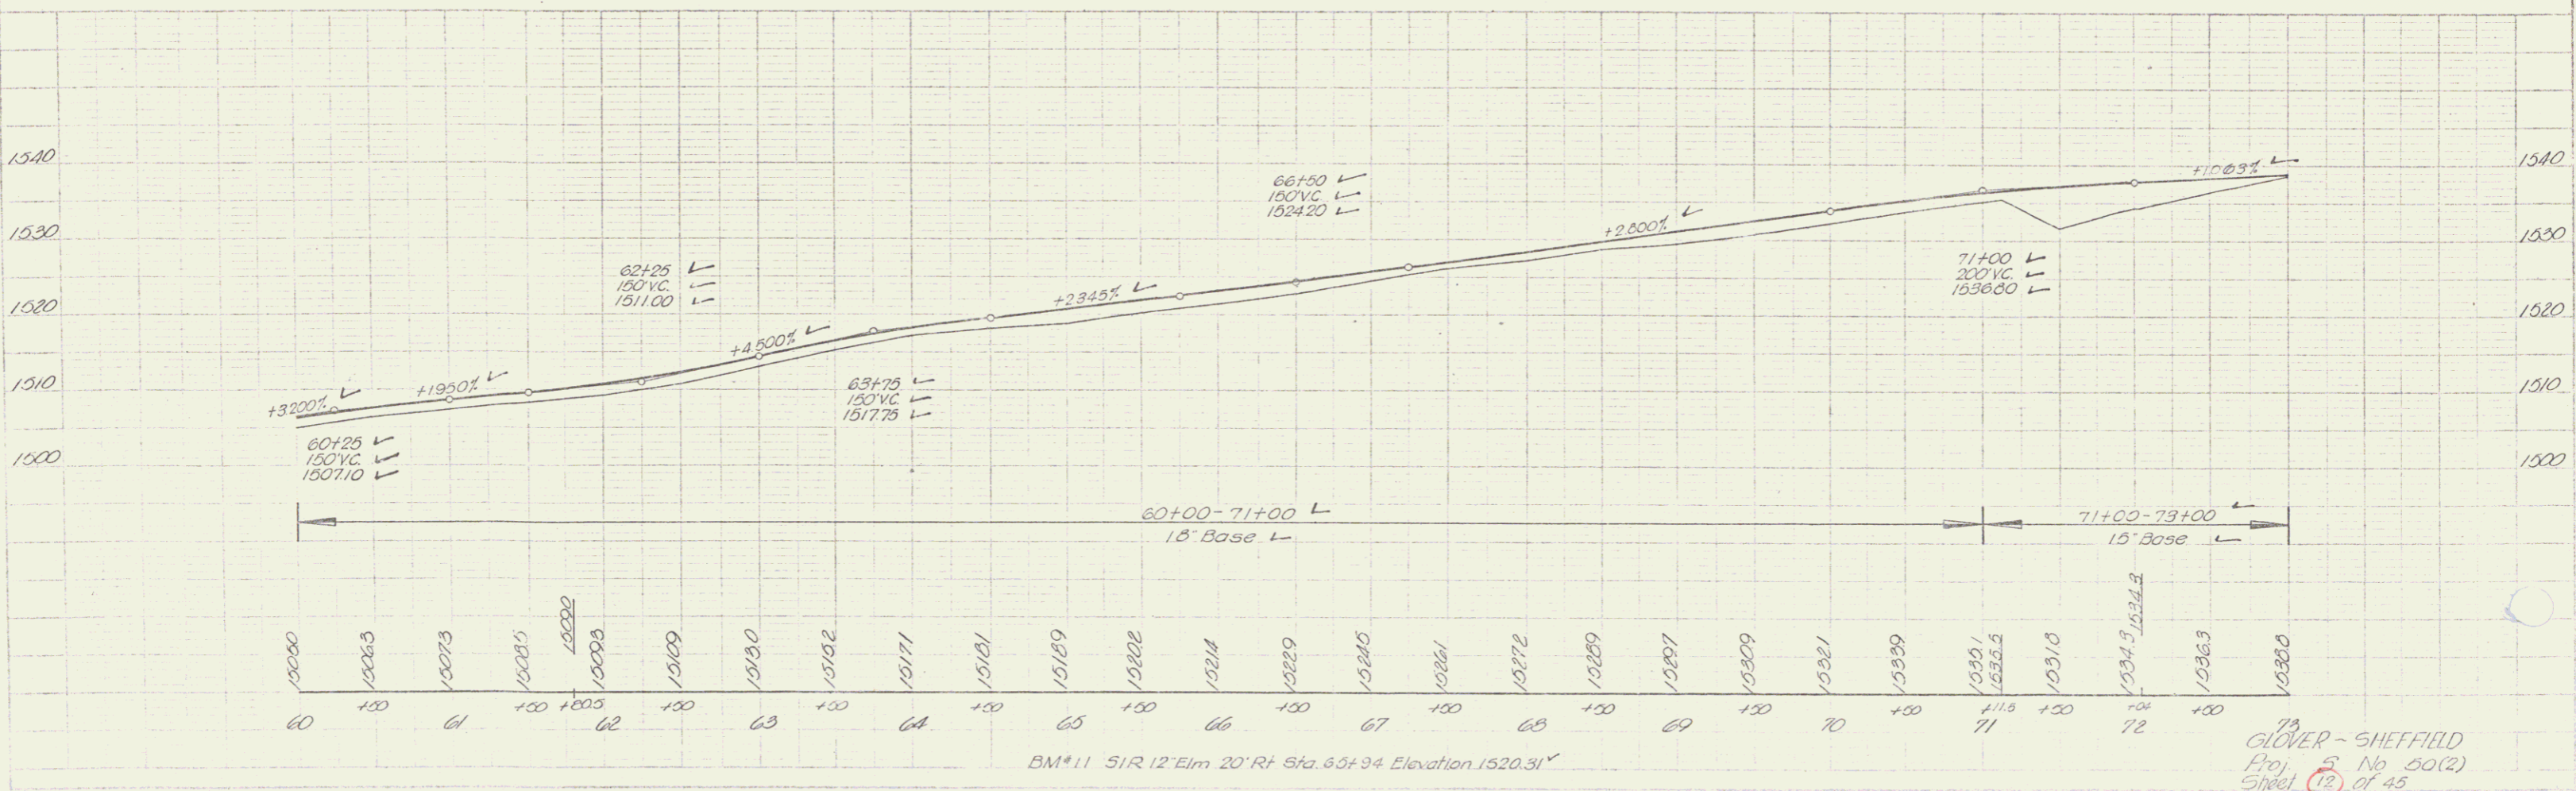


Plank Guard Rail
71+40 Lt Blingr

CONSTRUCT DRIVES

Sta	Pos
63+50	Rt
63+45	Lt
72+25	R+
67+25	R+

DATE	7-58
BY	Hobby
CHECKED	
DATE	
BY	

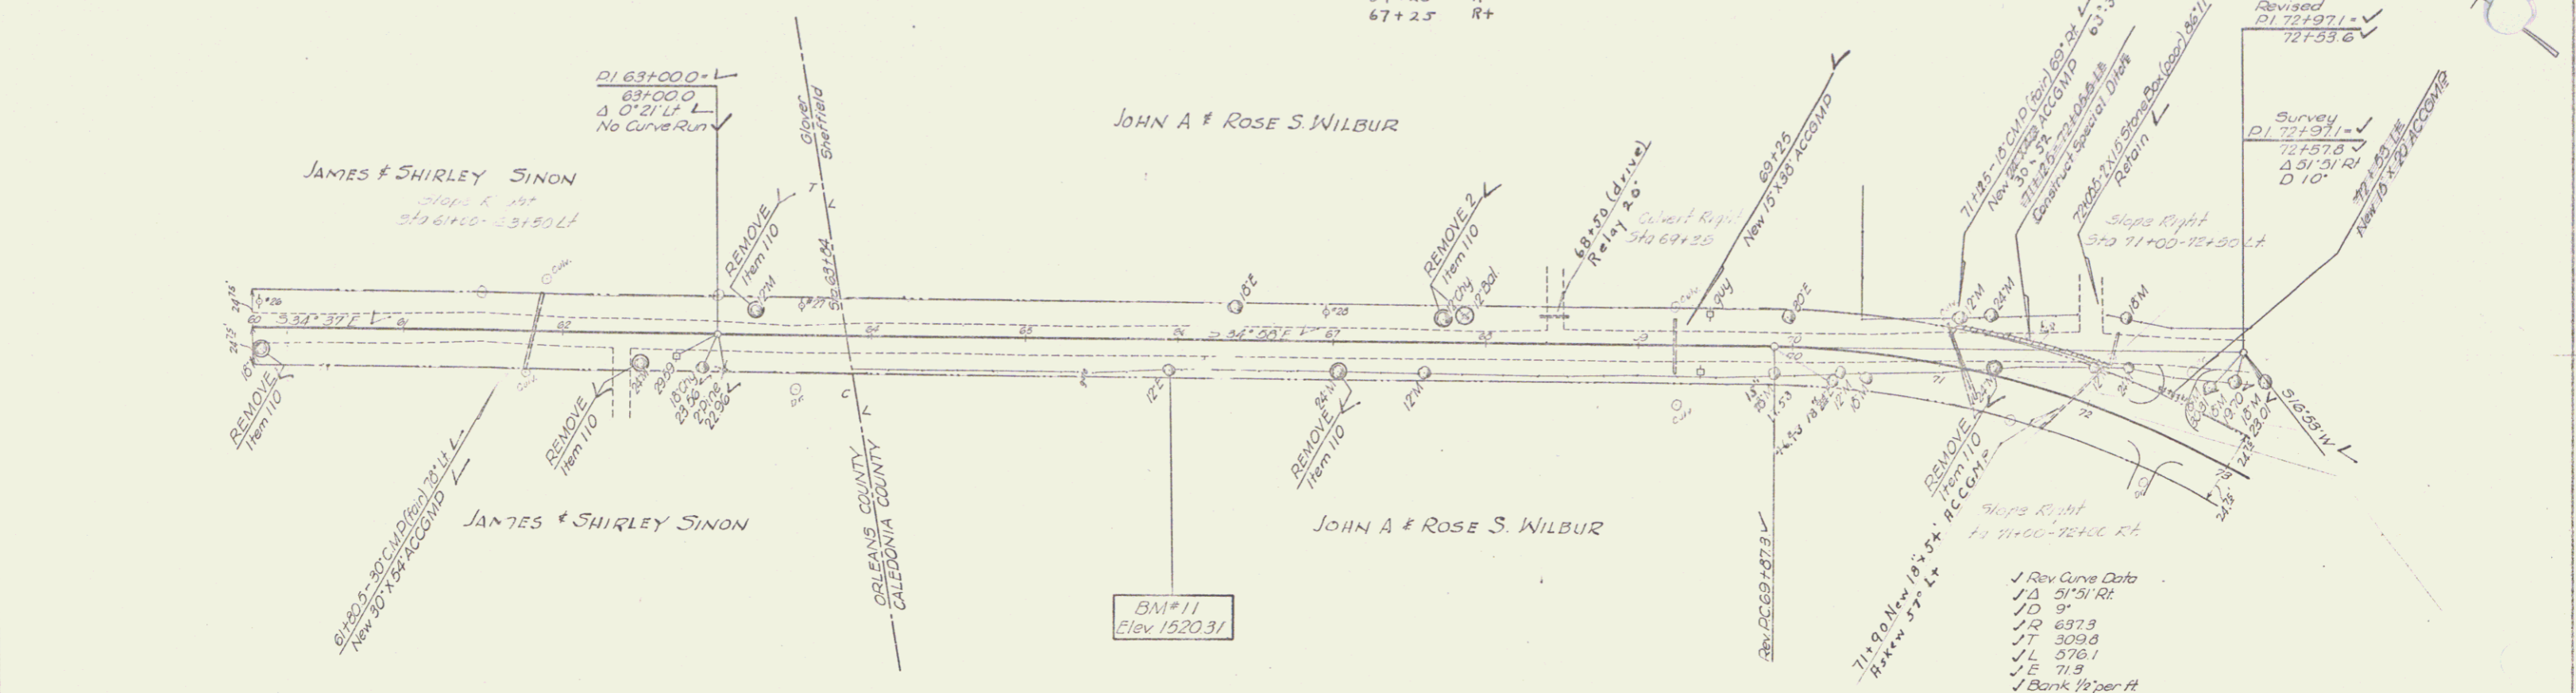

- J Rev Curve Data
- J Δ 51'51" Rt
- J D 9'
- J P 637.3
- J T 309.8
- J L 576.1
- J E 71.5
- J Bank 1/2' per ft

GLOVER - SHEFFIELD
Proj No 50(2)
Sheet 19 of 45