
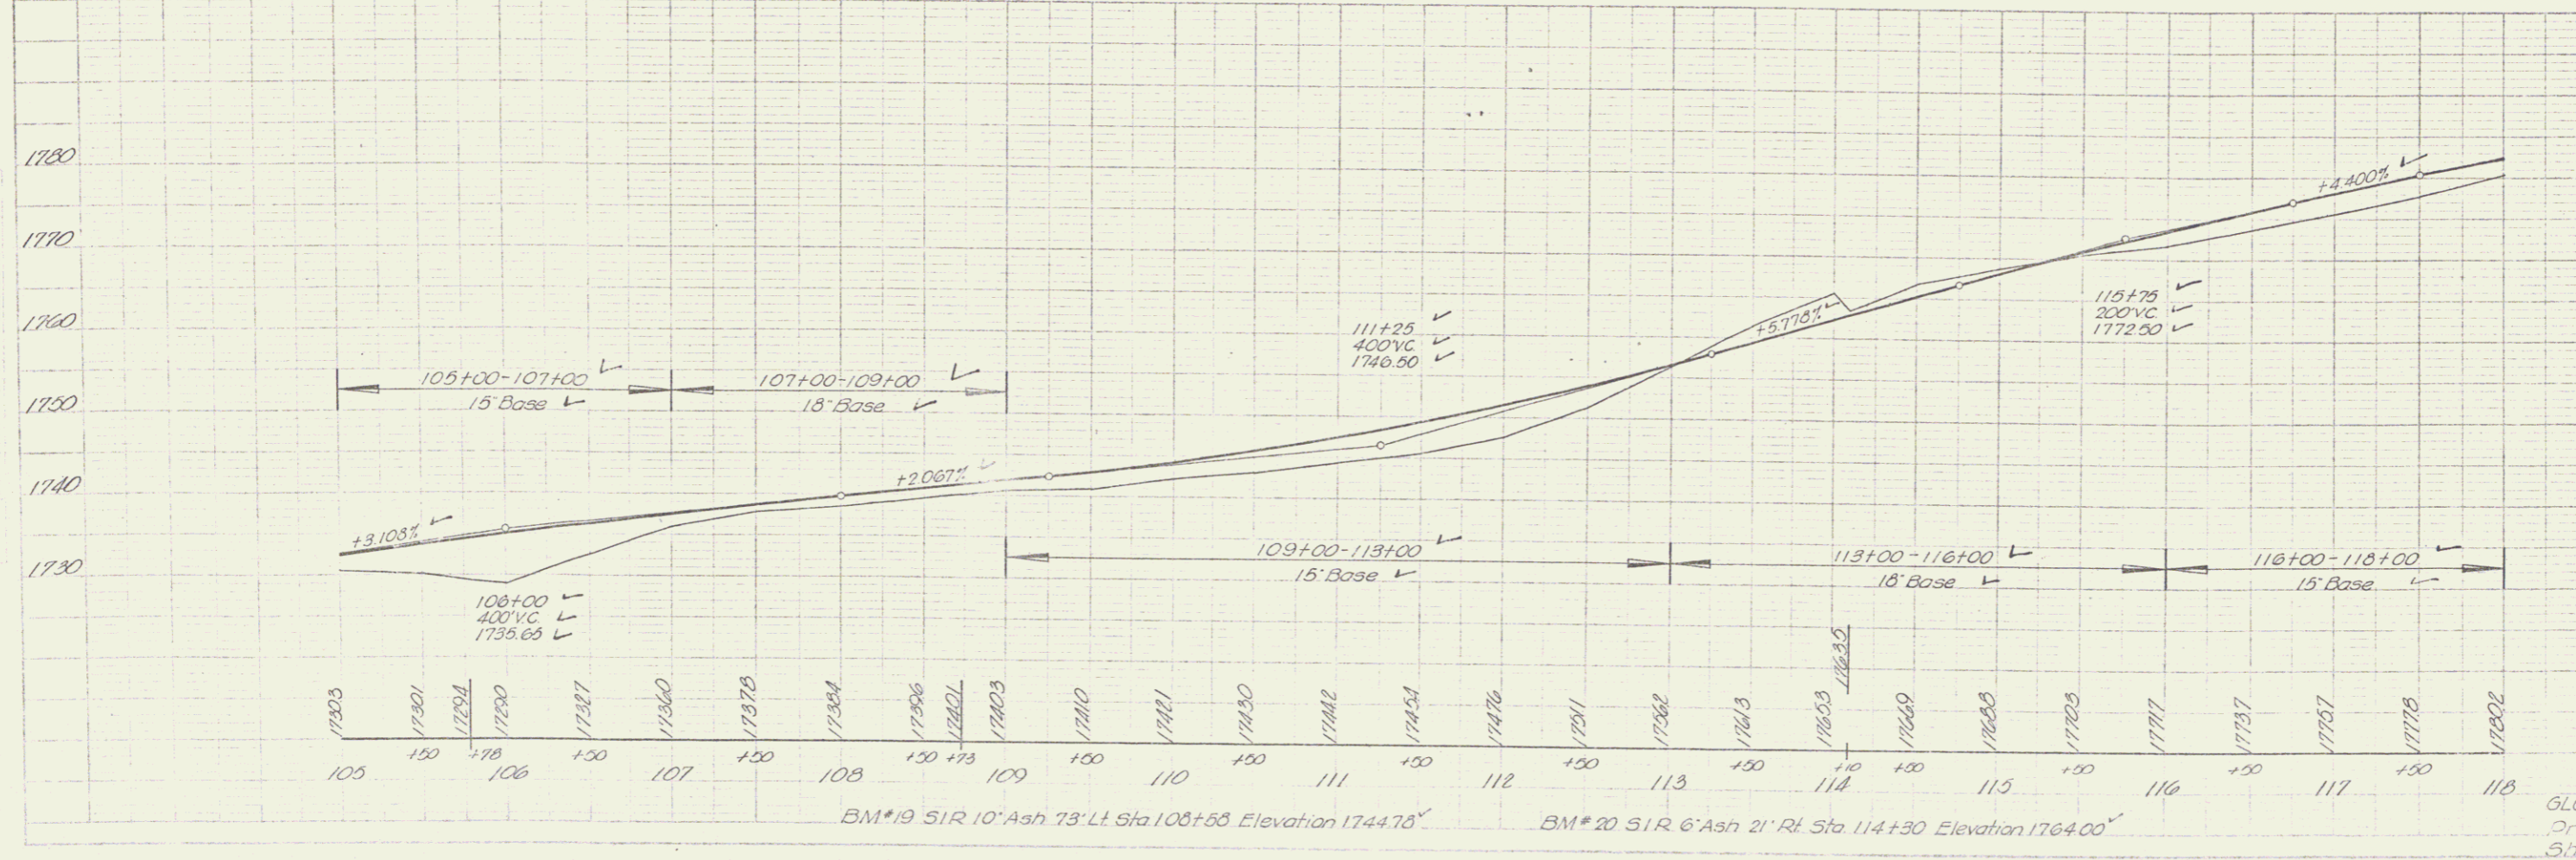


PLAN
 DATE
 DRAWN BY
 CHECKED BY
 SCALE

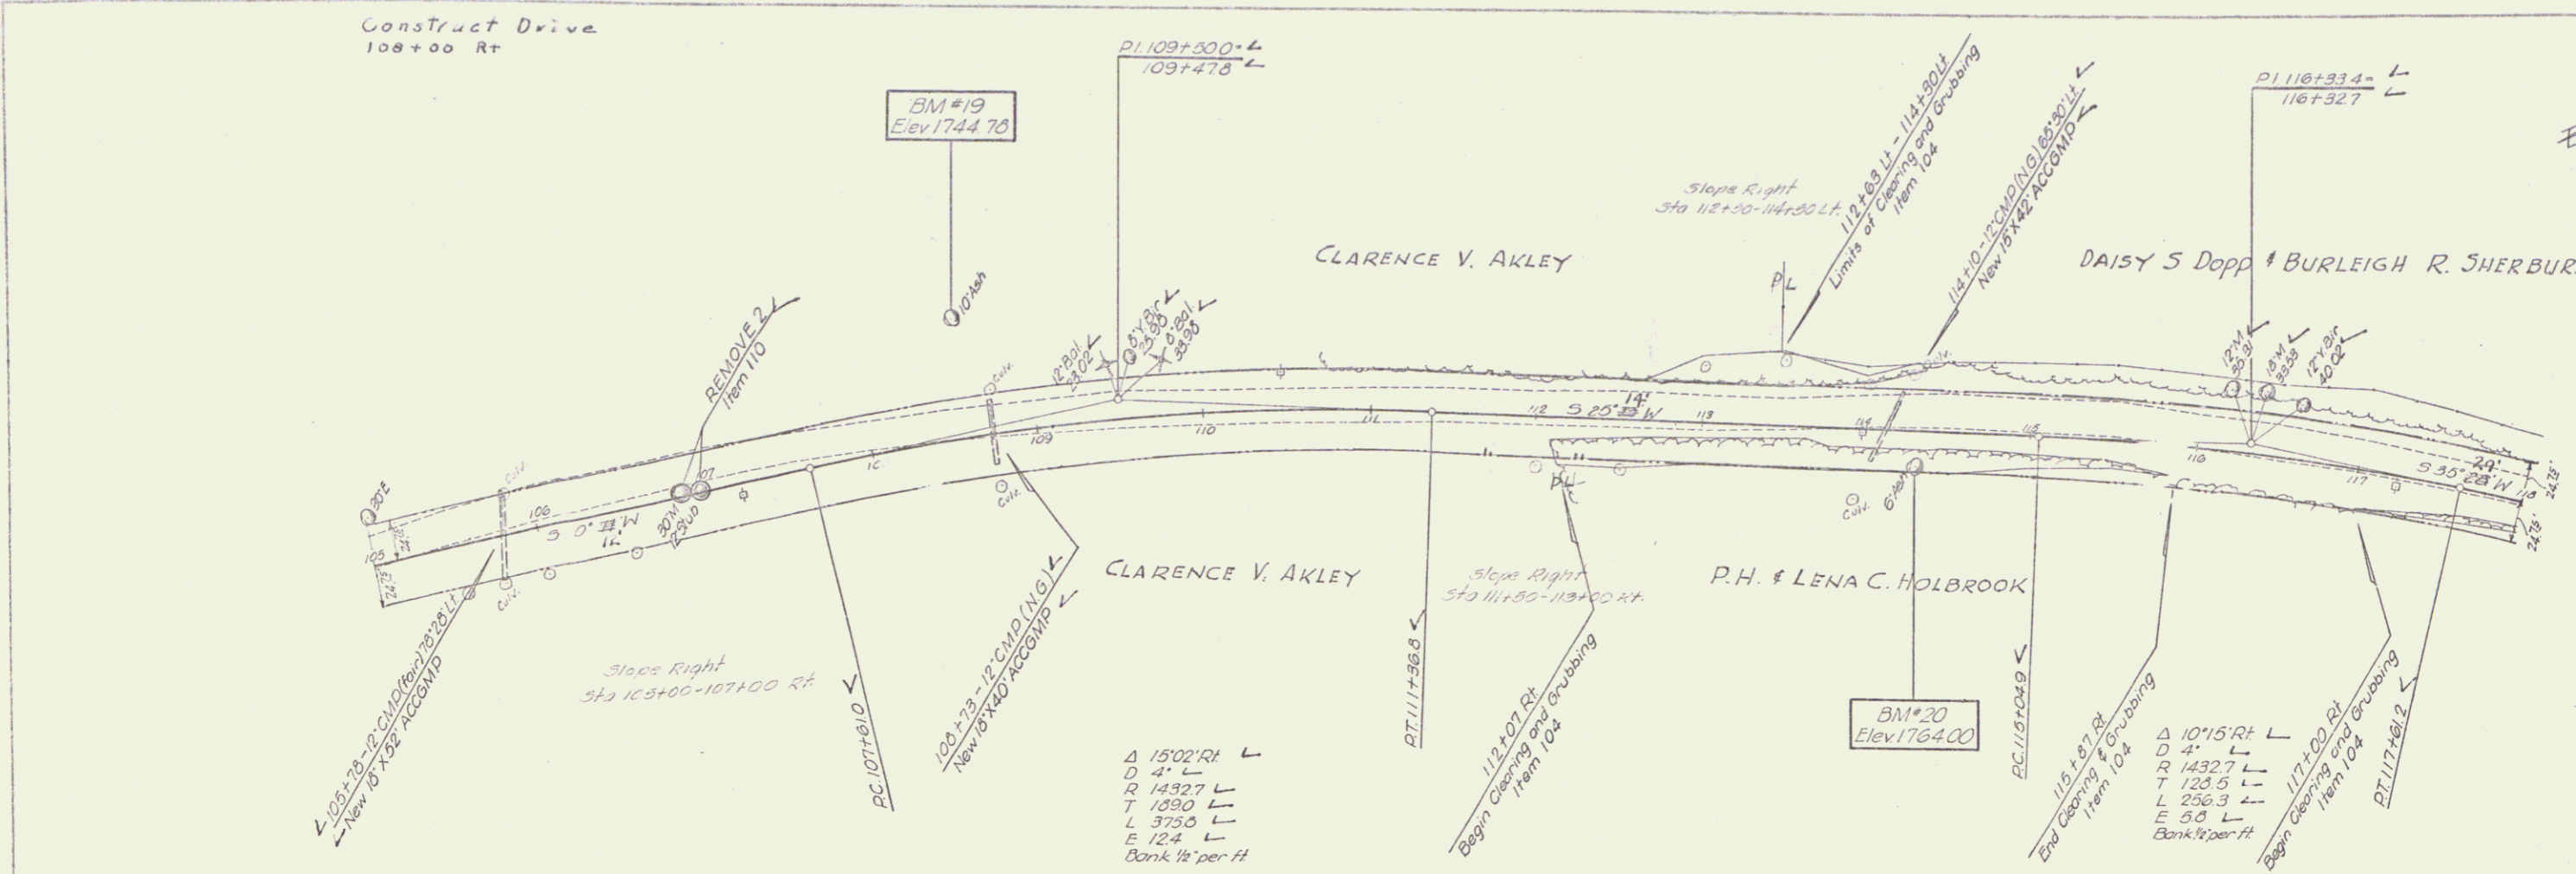

GLOVER-SHEFFIELD
 Project 5 N° 50(?)
 Sheet 15 of 45
 9