
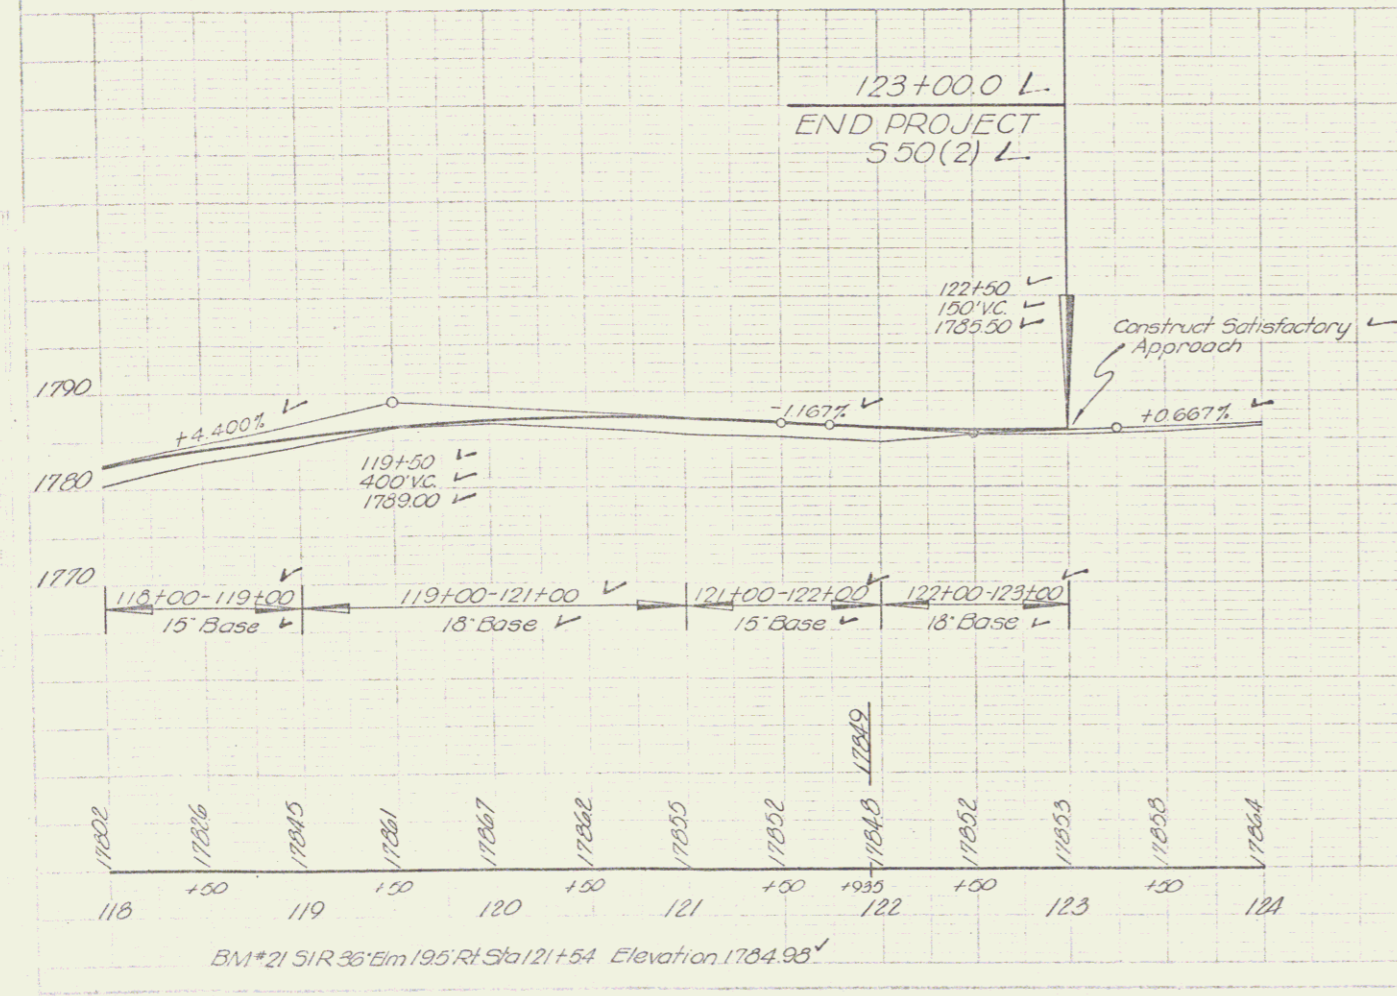


DATE	7/23
BY	...
CHECKED	...
APPROVED	...

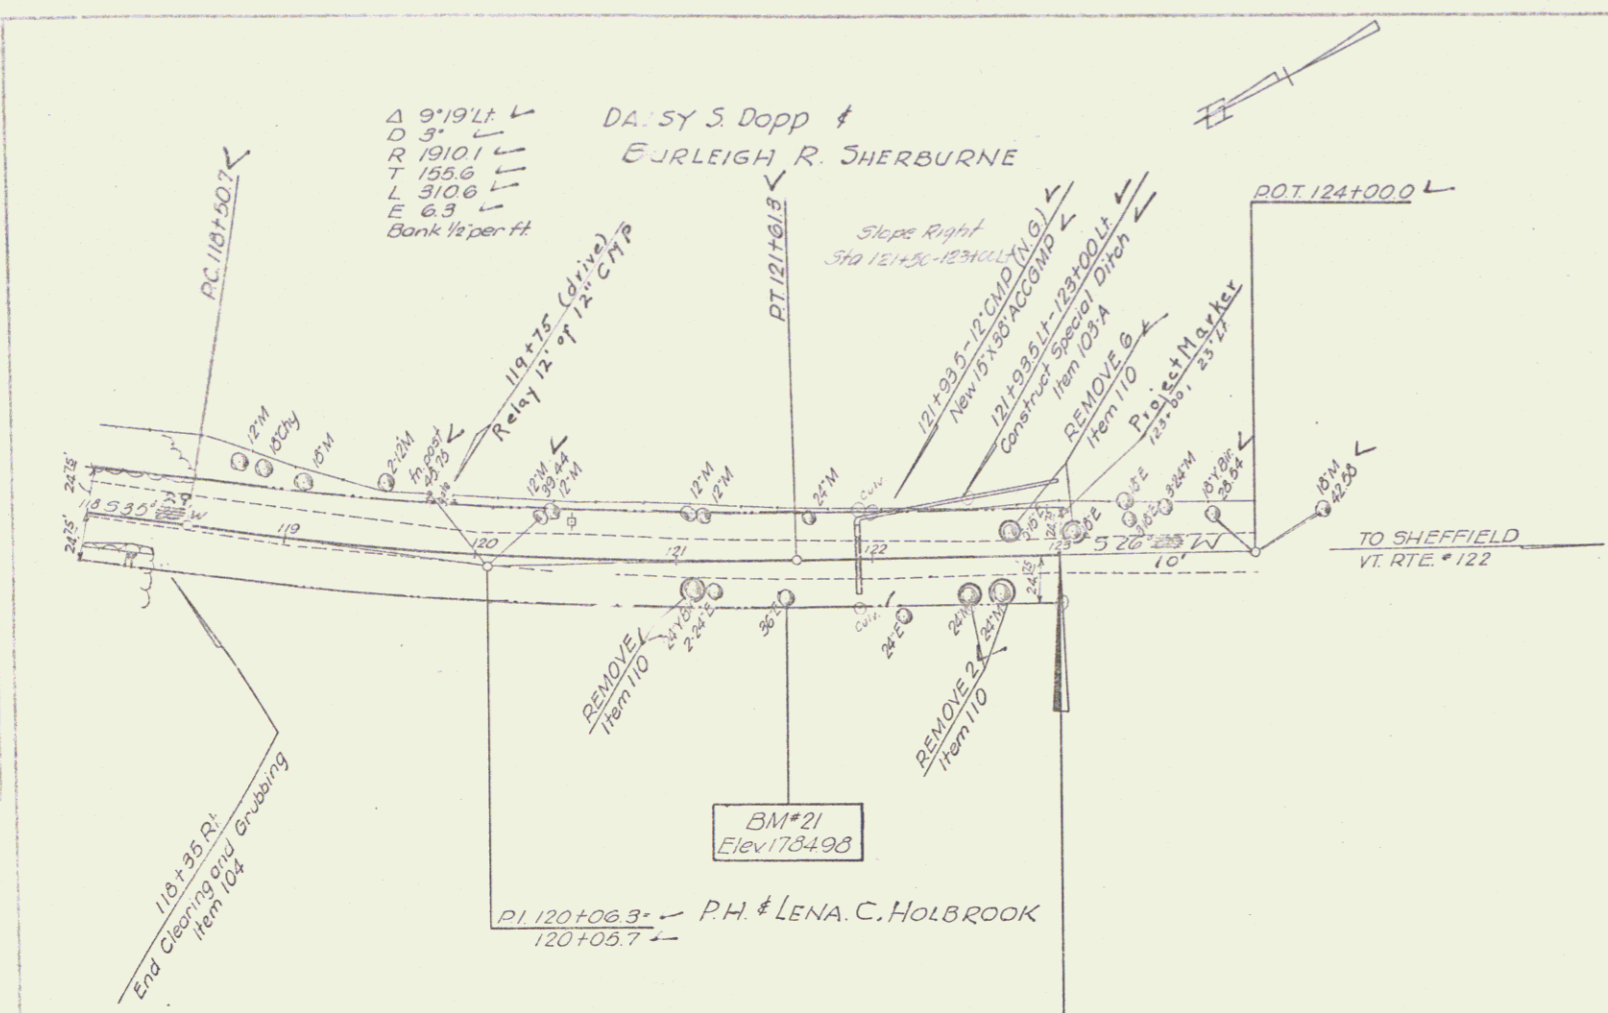

10