


TOWN OF WESTFORD
COUNTY OF CHITTENDEN
VT ROUTE #128
ESSEX CENTER - FAIRFAX ROAD

BEGINNING AT THE ESSEX-WESTFORD TOWN LINE
 AND EXTENDING NORTHERLY 6.548 MILES ON VT.
 ROUTE #128 TO THE WESTFORD-FAIRFAX TOWN
 LINE.


LENGTH OF PROJECT 34,573.00 FEET = 6.548 MILES

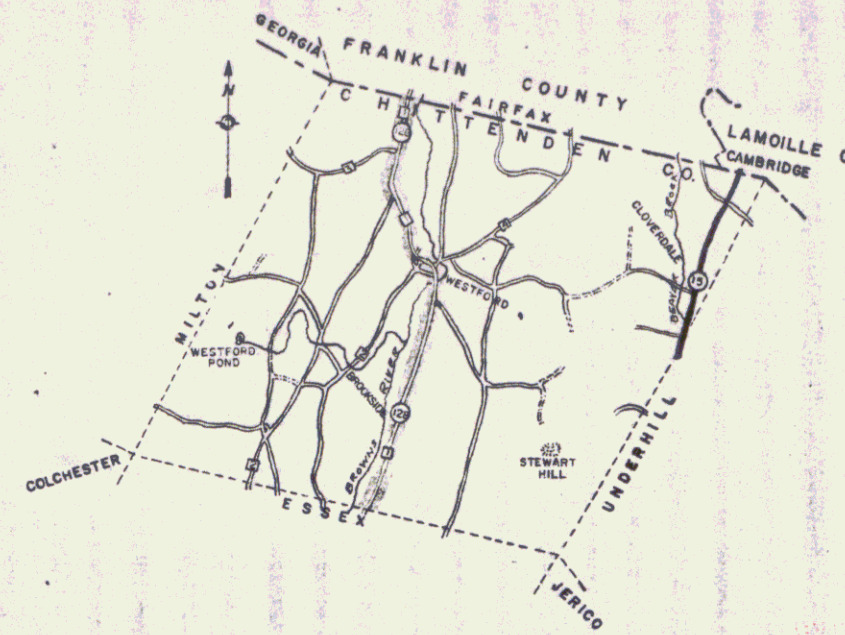

*Evidence of Sink
 Historic Road
 through
 approx
 433+00*

Pin # 99R607
 Project WESTFORD 1967
 Date 1/1/1967

RIGHT-OF-WAY DIVISION
 TOWN FILE
 PERPETUAL
 Town of VT 128
 [To Be Returned To R.O.W. Division]

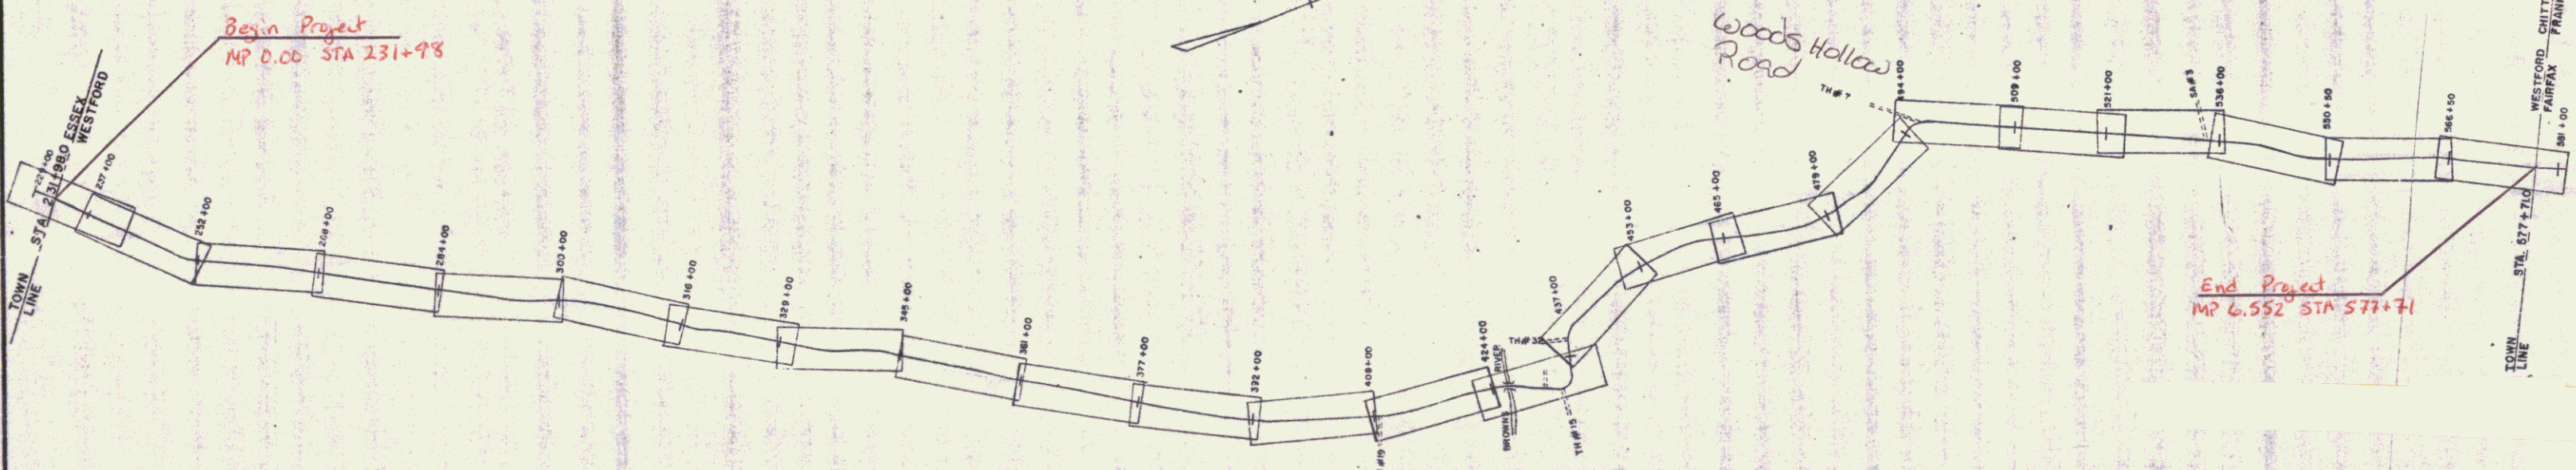

*Begin Project
 MP 0.00 STA 231+98*

*End Project
 MP 6.552 STA 577+71*

SCALE
 0 500 1000
 FEET

SURVEYED BY Bitter DATE Jan 67
 DRAWN BY Stalord DATE Feb 67
 TRACED BY Stalord DATE Feb 67
 PROJ. NO.
 SHEET 1 OF 14