
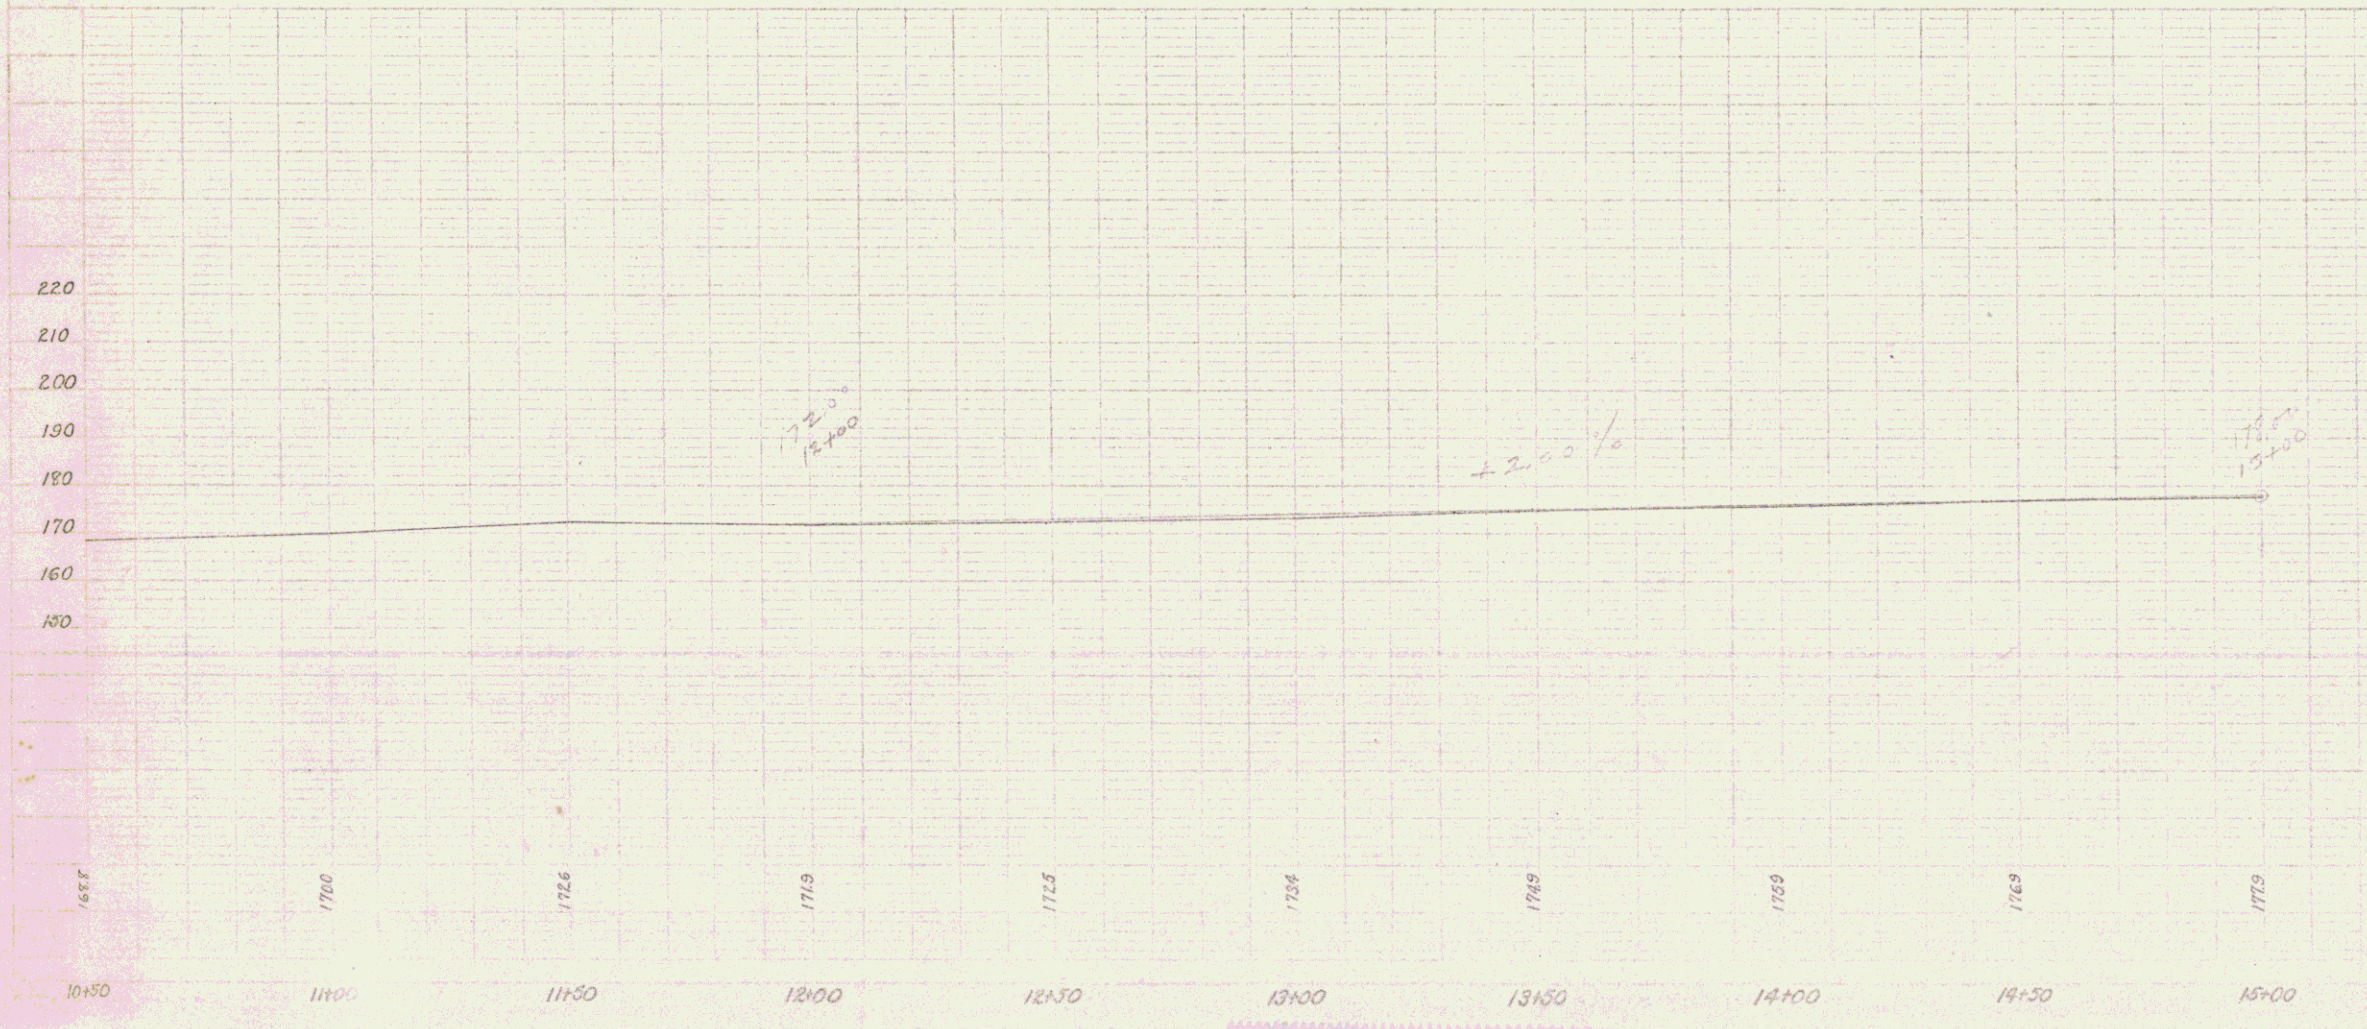


PLAN
 DATE
 DRAWN BY
 CHECKED BY
 TITLE
 PROJECT NO.

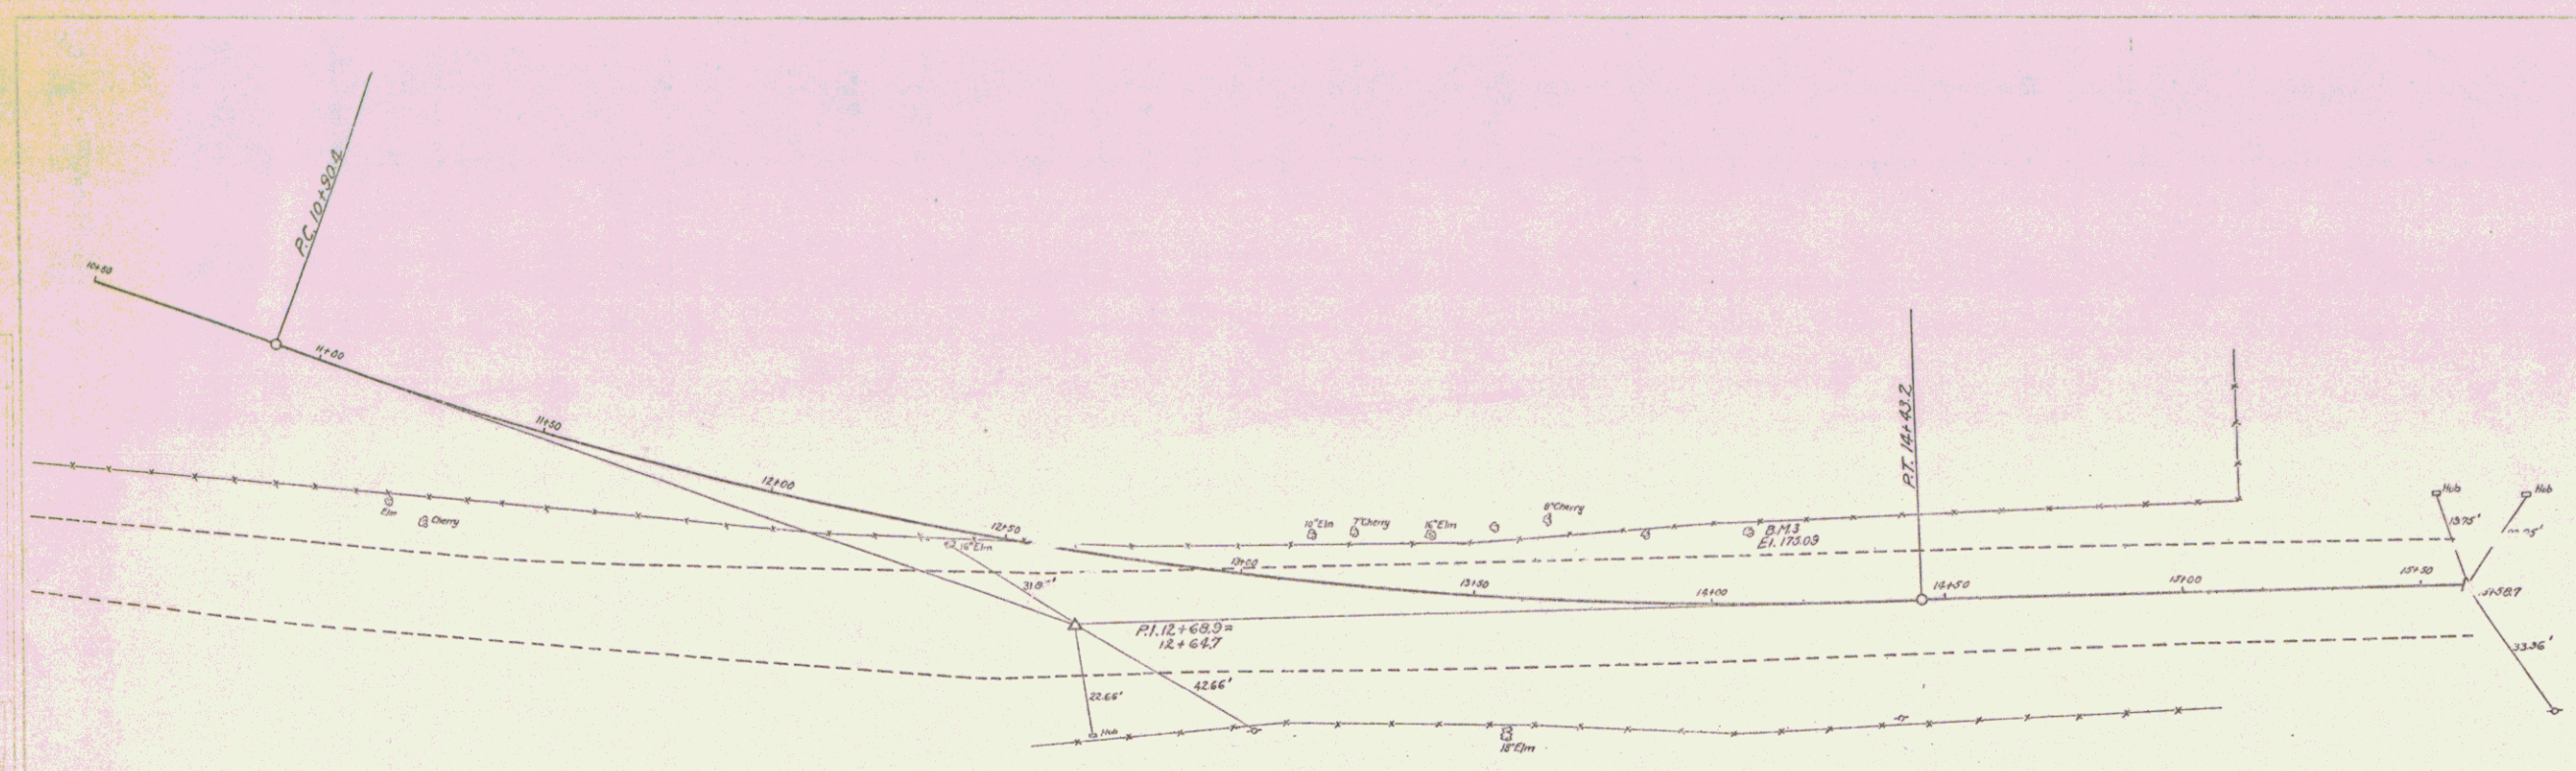

Not used

Brown River Co.
 BROWN RIVER BRIDGE
 FAIRFAX-VT.