
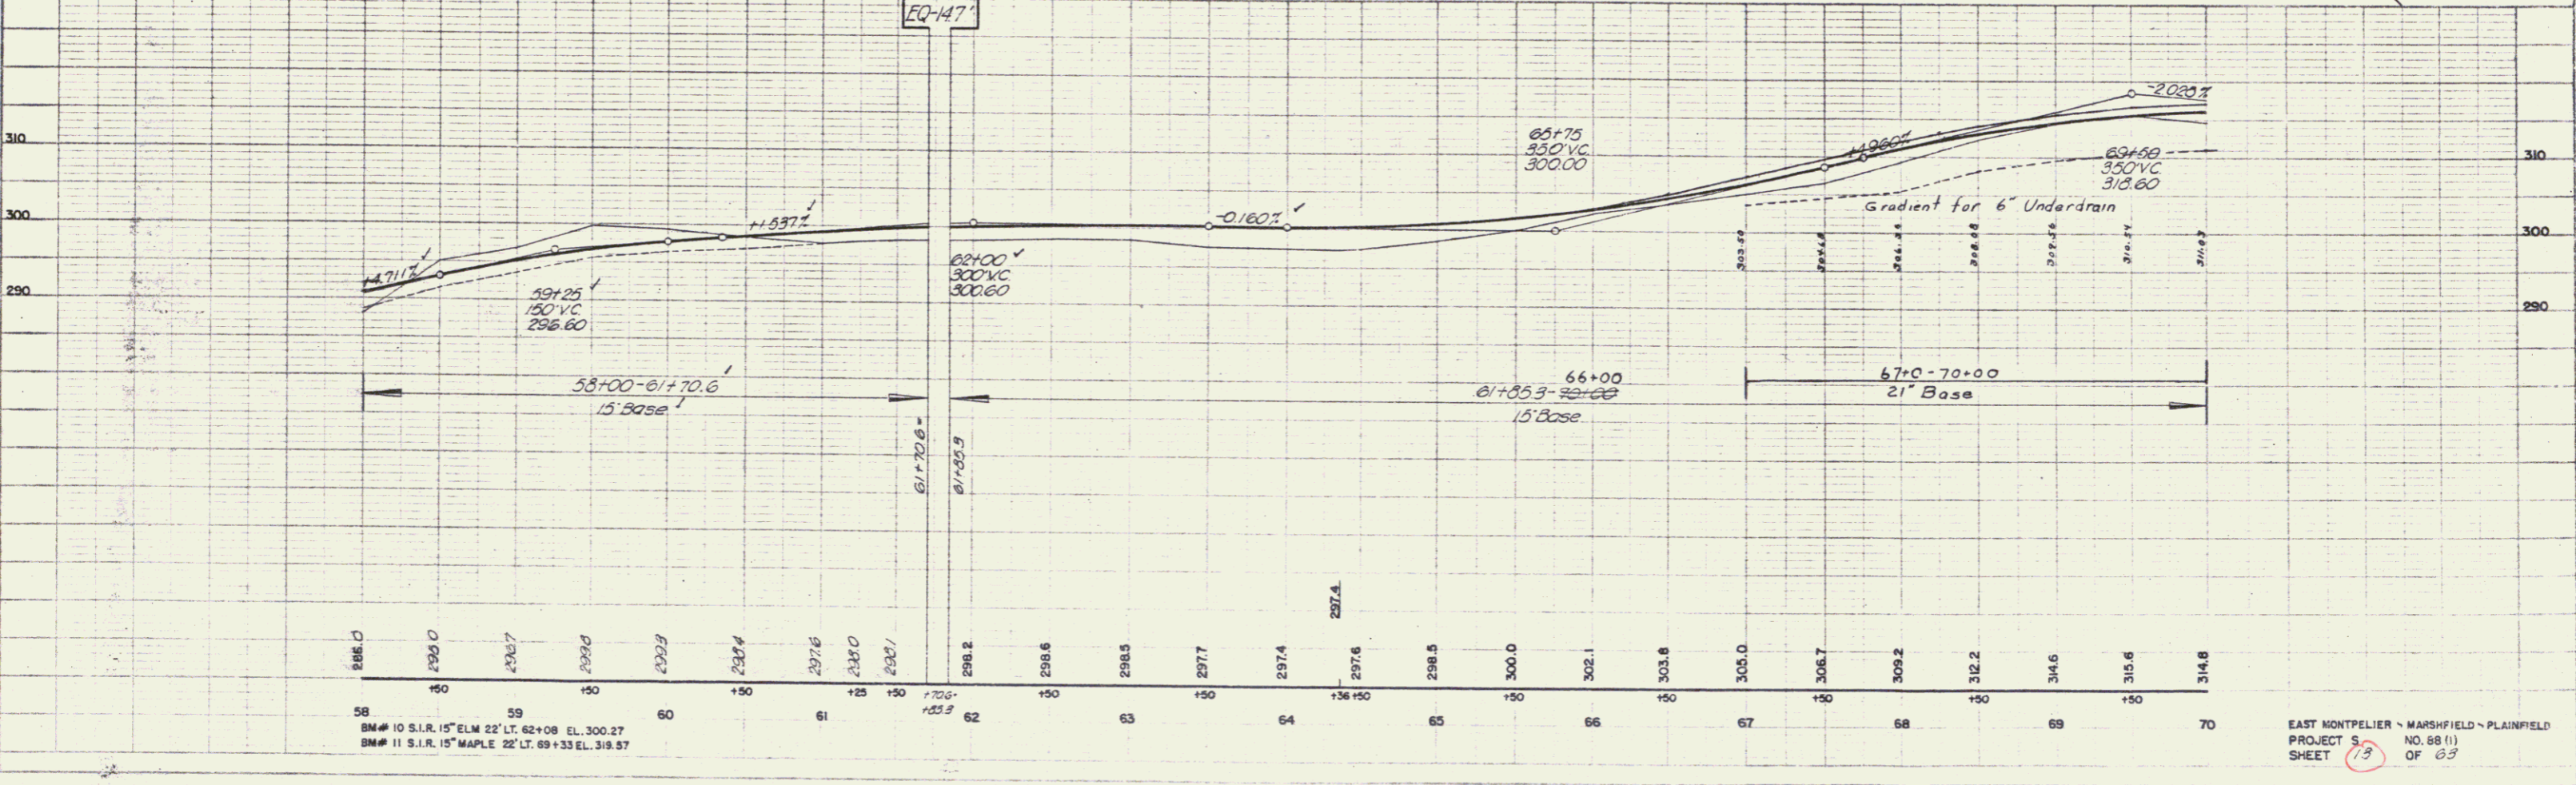


PLAN	DATE	BY	CHK
DATE	BY	CHK	DATE
REVISION	BY	CHK	DATE
NO.	NO.	NO.	NO.

PROFILE	DATE	BY	CHK
DATE	BY	CHK	DATE
REVISION	BY	CHK	DATE
NO.	NO.	NO.	NO.

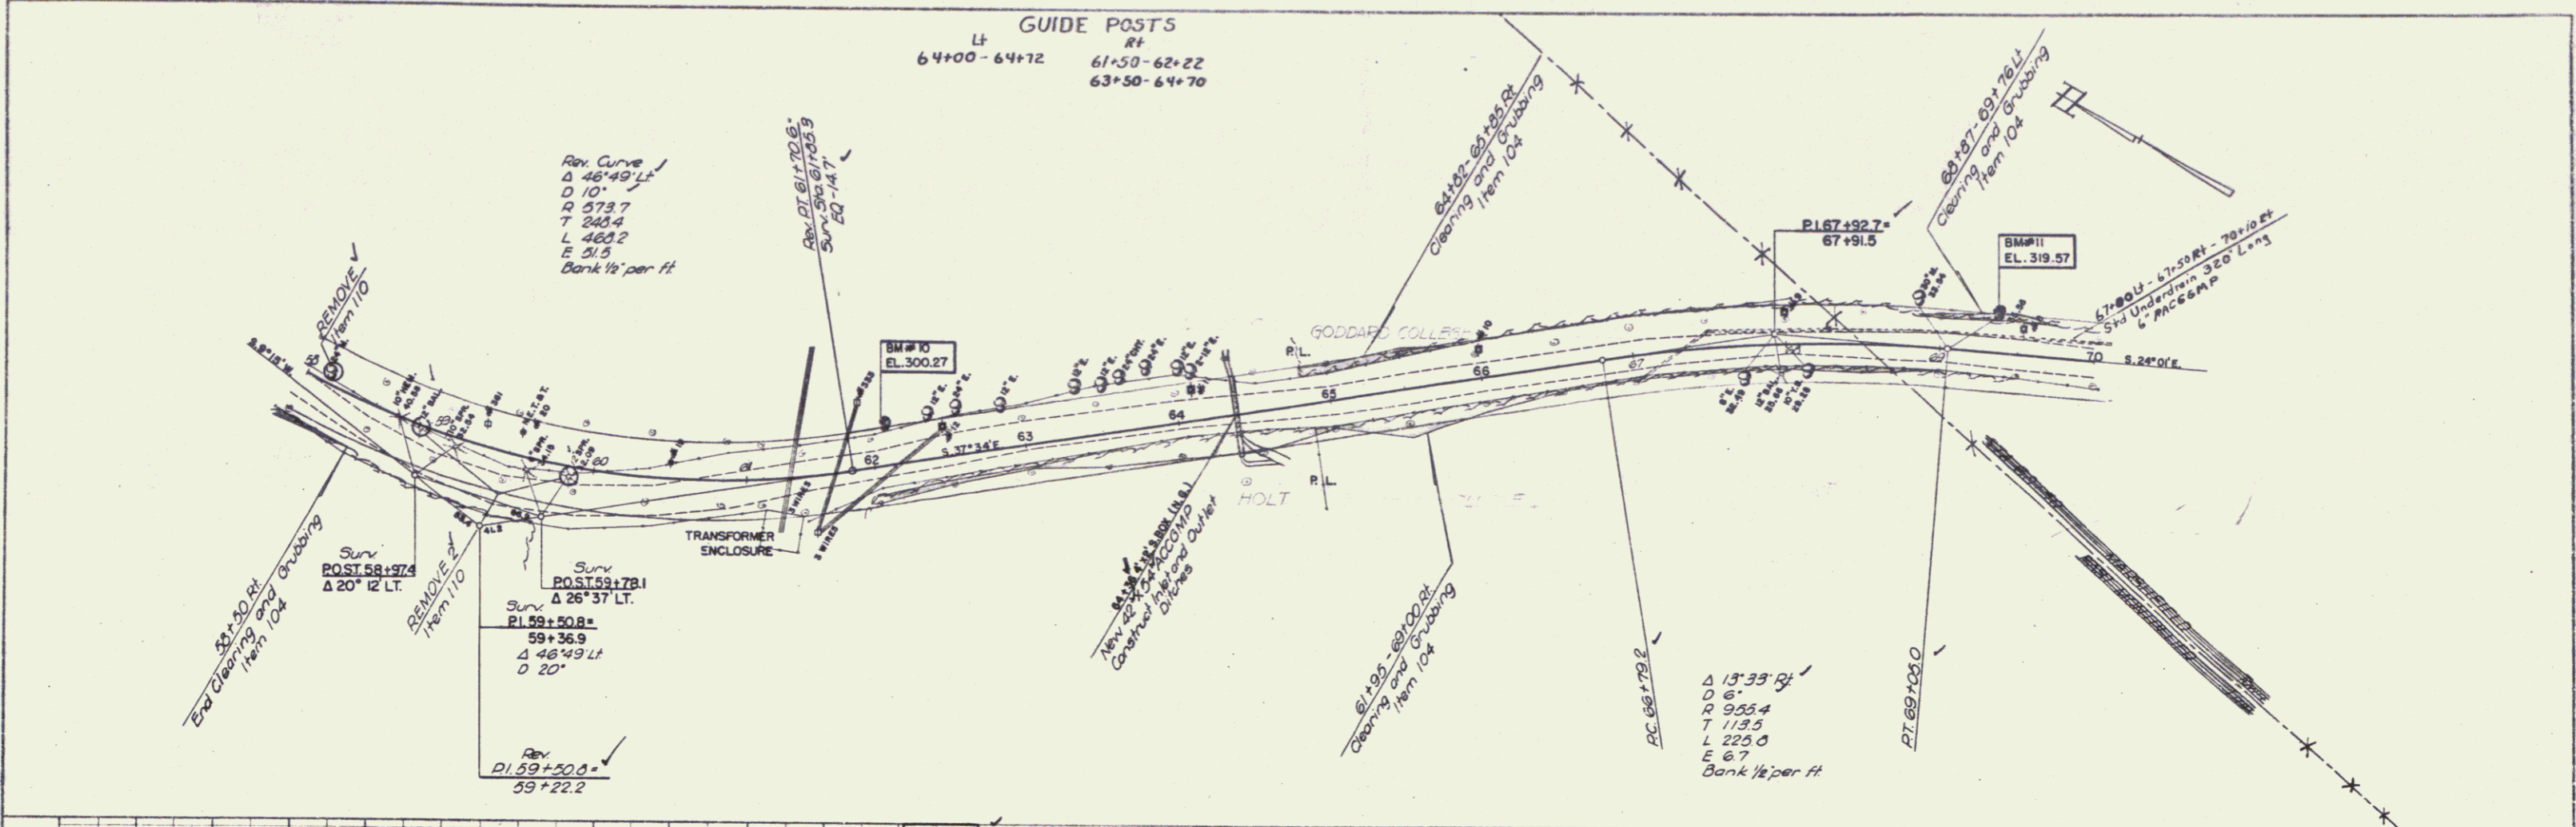

BM# 10 S.I.R. 15" ELM 22' LT. 62+08 EL. 300.27  
 BM# 11 S.I.R. 15" MAPLE 22' LT. 69+33 EL. 319.57

EAST MONTPELIER - MARSHFIELD - PLAINFIELD  
 PROJECT 5  
 SHEET 13 OF 65

6