
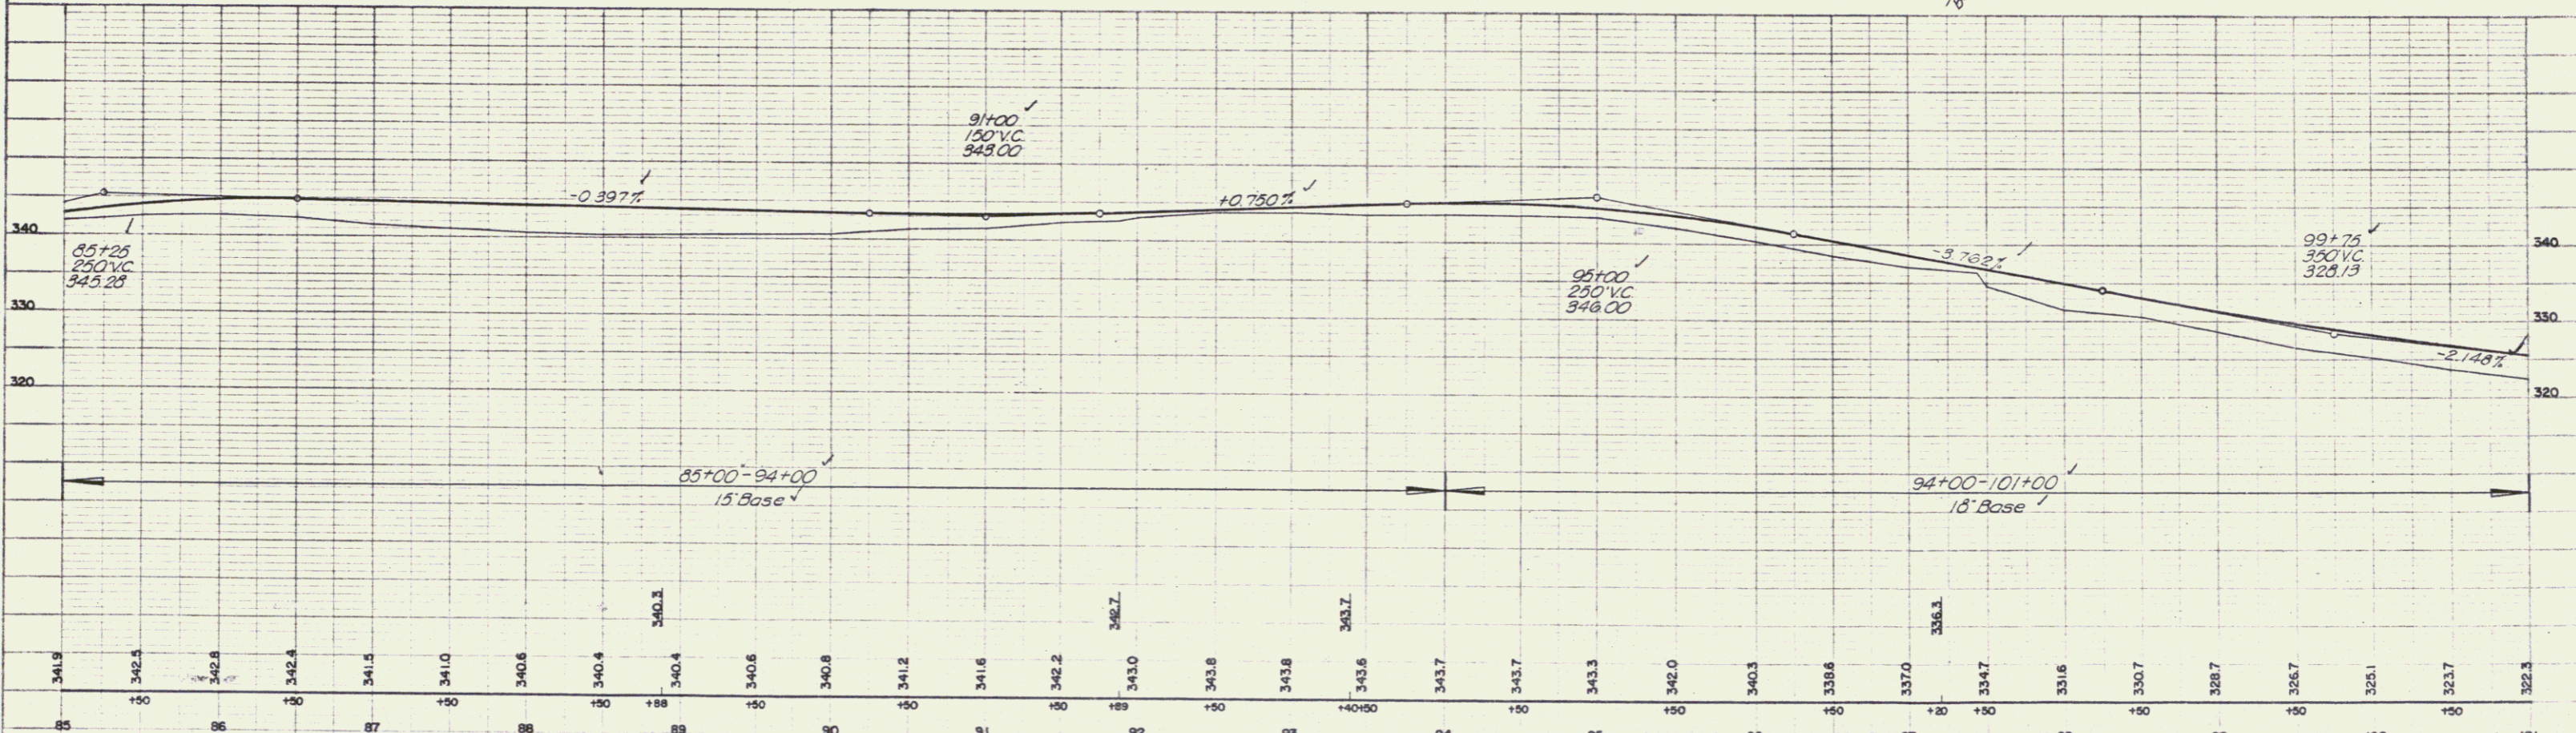


| | | |
|---------|------|----|
| PLAN | DATE | BY |
| REVISED | | |
| NOTED | | |
| TRACED | | |

| | | |
|---------|------|----|
| PROF. | DATE | BY |
| REVISED | | |
| NOTED | | |
| TRACED | | |

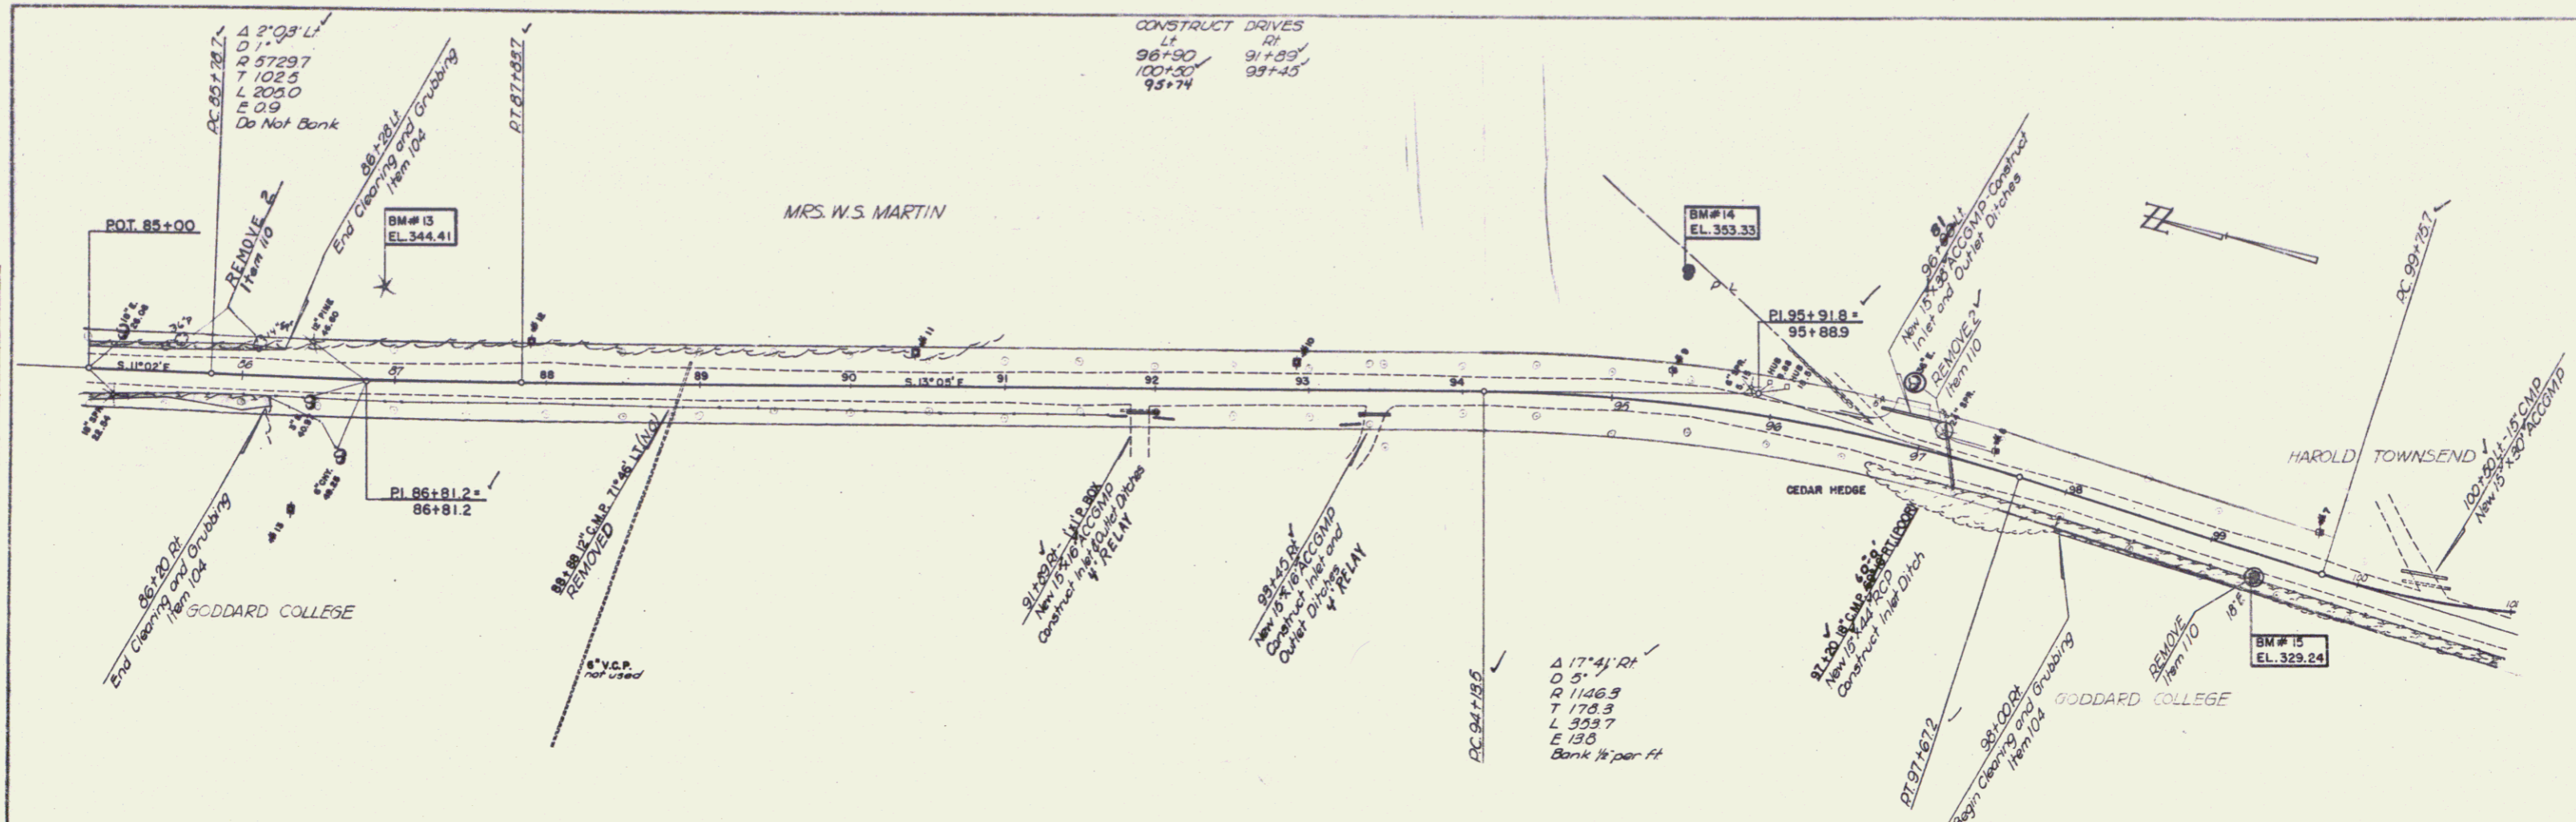

BM# 13 S.I.T. 12" PINE 62' LT. 96+90 EL. 344.41
 BM# 14 S.I.R. 24" ELM. 83' LT. 95+37 EL. 353.33
 BM# 15 S.I.T. 18" ELM. 13' RT. 99+31 EL. 329.24

8