


STA 5193  
 DESIGN PROJECT S 176(3)  
 Construct satisfactory Approach

PARCEL INSTRUMENT DATE GRANTOR GRANTEE  
 #1 A,B,C,D,E,F,G,H W.D.O.E. 6-24-48 LLEWELLYN & CHARLOTTE BLAKE

RECORDED FAIRLEE DATE REMARKS  
 BOOK PAGE DATE  
 20 314-316 6-30-48 C,D & E ON SH.5-F,G,H ON SH.6

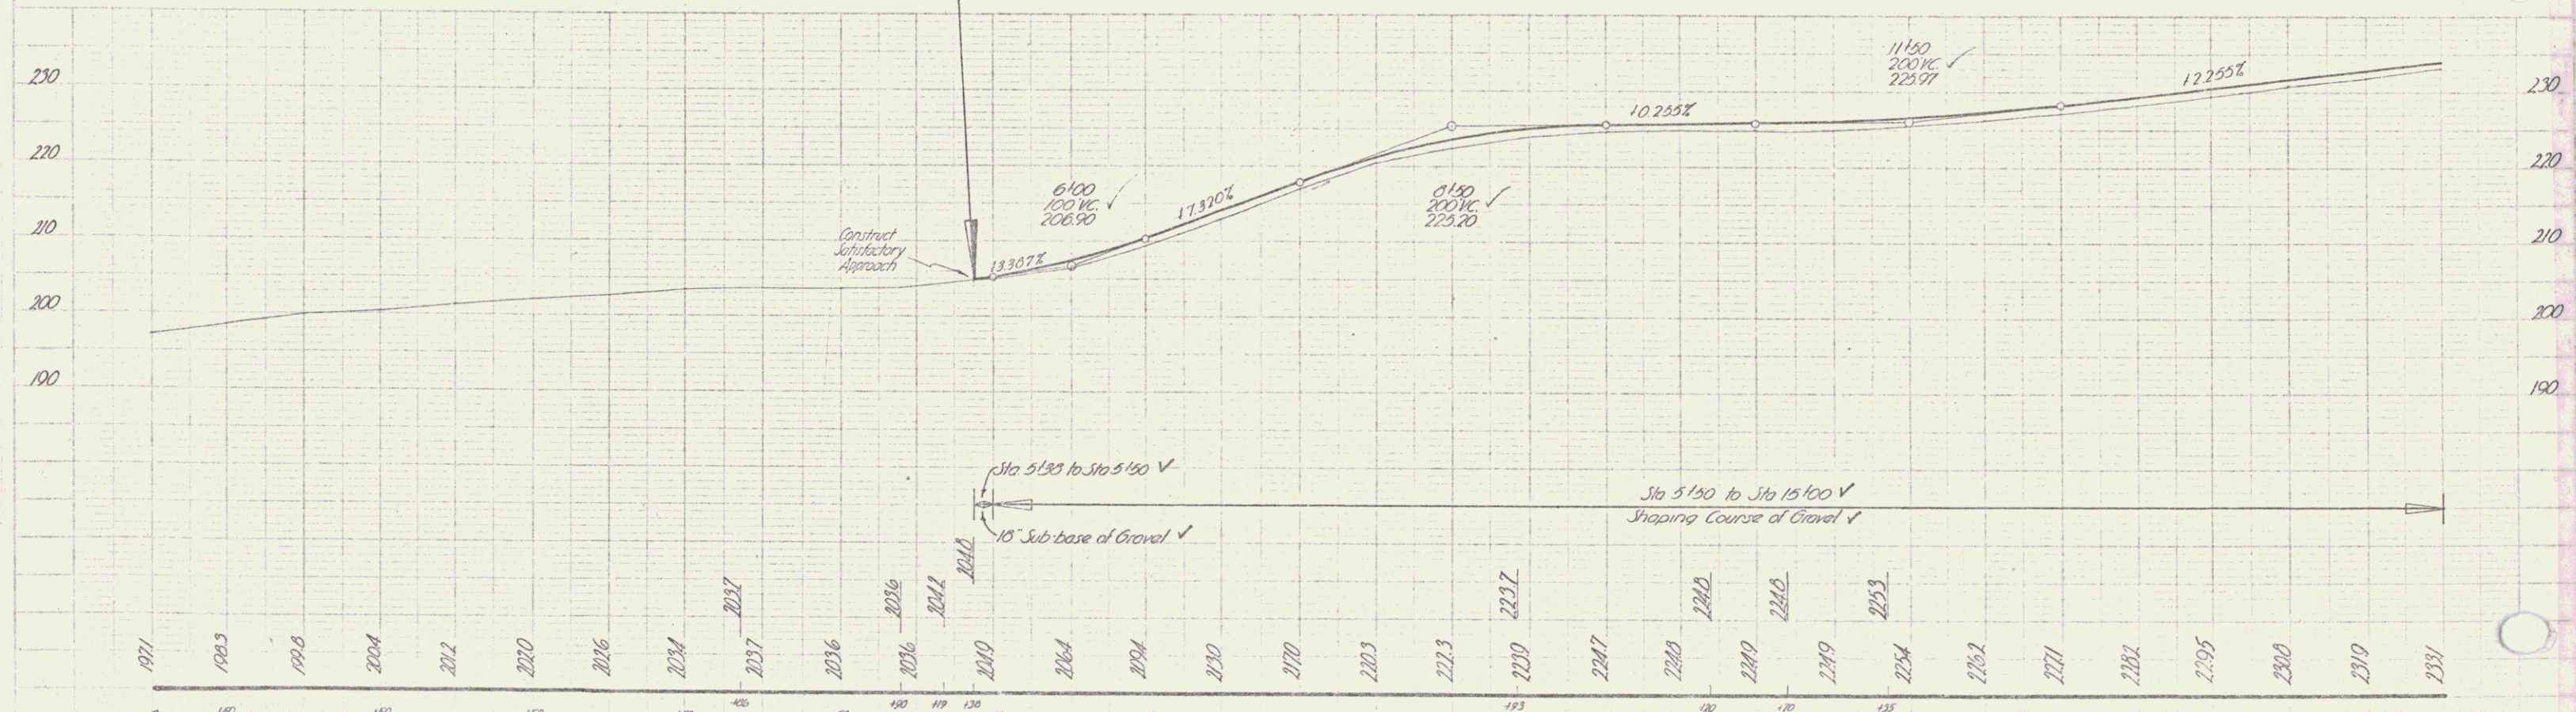

BM #1 Spike in root 24" Dina 23 ft. ft. sta. 11.57 Elev. 200.00  
 D.M. #2 Spike in root 18" Maple 26 ft. ft. sta. 11.85 Elev. 224.44

FAIRLEE Series No 176 (3)  
 Sheet 4 of 25 sheets