


PARCEL	INSTRUMENT	DATE	GRANTOR	GRANTEE	RECORDED FAIRLEE BOOK PAGE DATE	REMARKS
(A) G. G. F. & S. (S. 17.75)	W. D. O. E.	6-24-48	LLEWELLYN & CHARLOTTE BLAKE	ST. OF VT.	20 314-316 6-30-48	

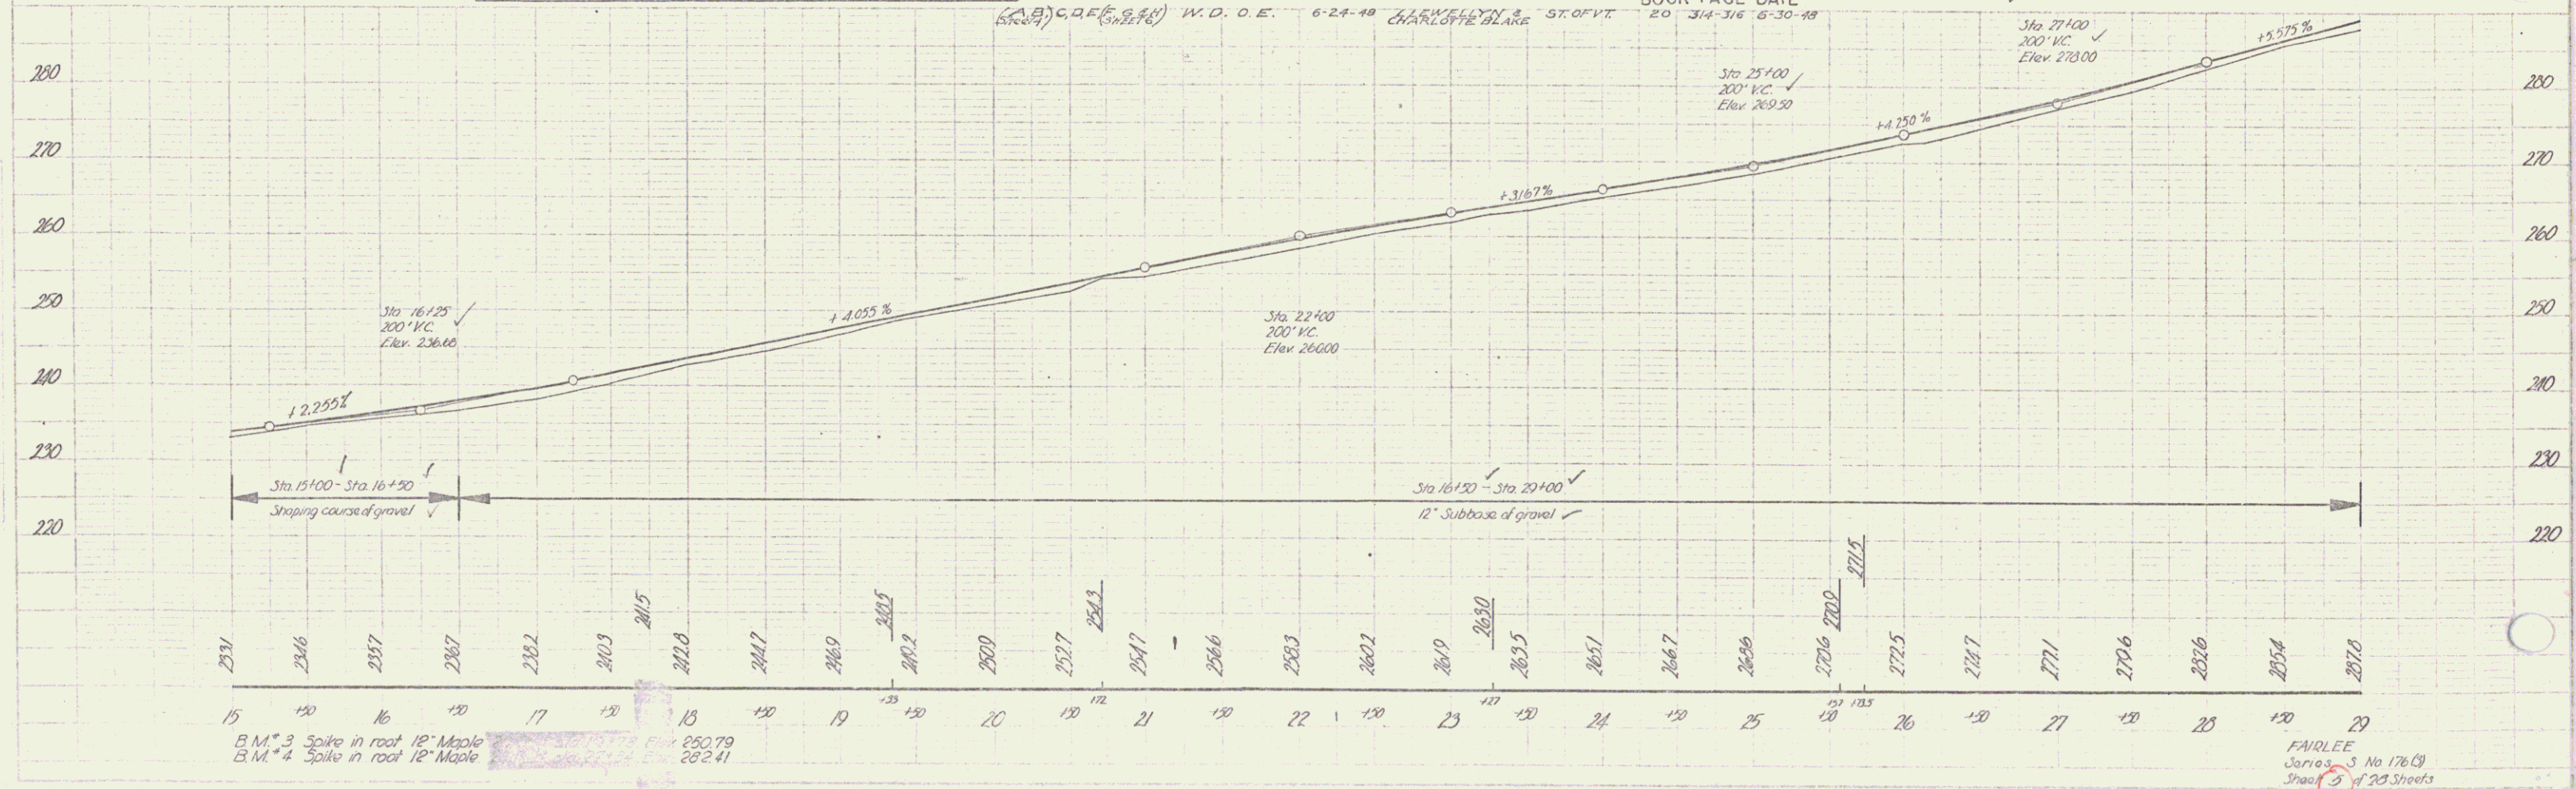

1-28  
 9-48  
 1-28  
 4-48  
 1-28  
 4-48

1-28  
 4-48  
 1-28  
 4-48

B.M. #3 Spike in root 12" Maple  
 B.M. #4 Spike in root 12" Maple

FAIRLEE  
 Series 3 No 176 (3)  
 Sheet 5 of 20 Sheets