


| PARCEL   | INSTRUMENT | DATE    | GRANTOR   | GRANTEE    | RECORDED FILE NO. | DATE    | REMARKS |
|----------|------------|---------|-----------|------------|-------------------|---------|---------|
| # 2 A 48 | W.D.O.E.   | 6-24-48 | C.H. PIKE | ST. OF VT. | 20                | 317-318 | 6-30-48 |
| # 3 A    | W.D.O.E.   | 8-24-48 | C.H. PIKE | ST. OF VT. | 20                | 319-320 | 9-2-48  |

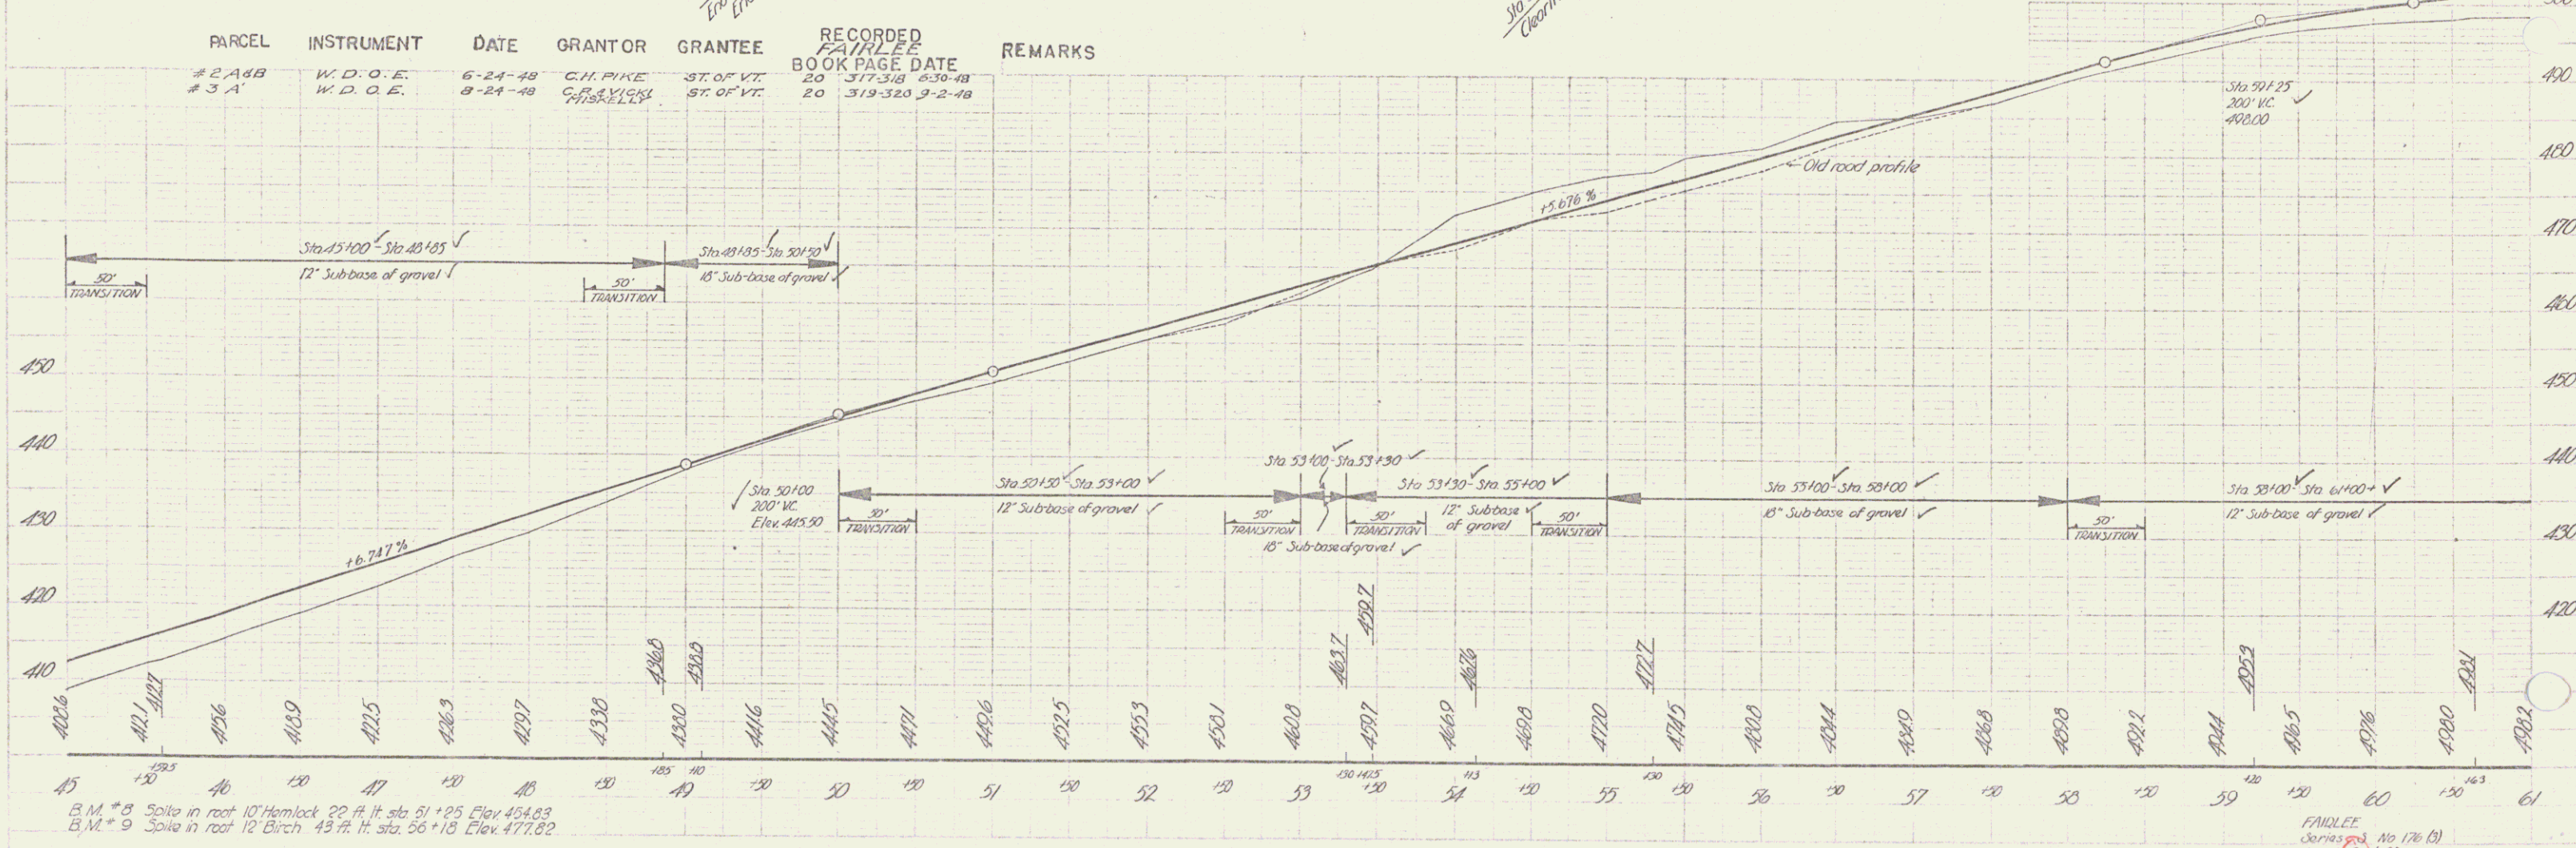

B.M. \* 8 Spots in root 10 Hemlock 22 ft. It sta 51 + 25 Elev 454.83  
 B.M. \* 9 Spots in root 12 Birch 43 ft. It. sta. 56 + 18 Elev 477.82

FAWLEE Series No 176 (B) Sheet (C) of 20 Sheets