


INDICATES BOUNDARY MARKERS


STA 5193  
DESIGN PROJECT S 176(3)  
Construct satisfactory Approach

PARCEL INSTRUMENT DATE GRANTOR GRANTEE  
#1 A,B,C,D,E,F,G,H W.D.O.E. 6-24-48 LLEWELLYN & CHARLOTTE BLAKE


RECORDED FAIRLEE DATE REMARKS  
BOOK PAGE DATE  
20 314-316 6-30-48 C,D & E ON SH.5-F,G,H ON SH.6

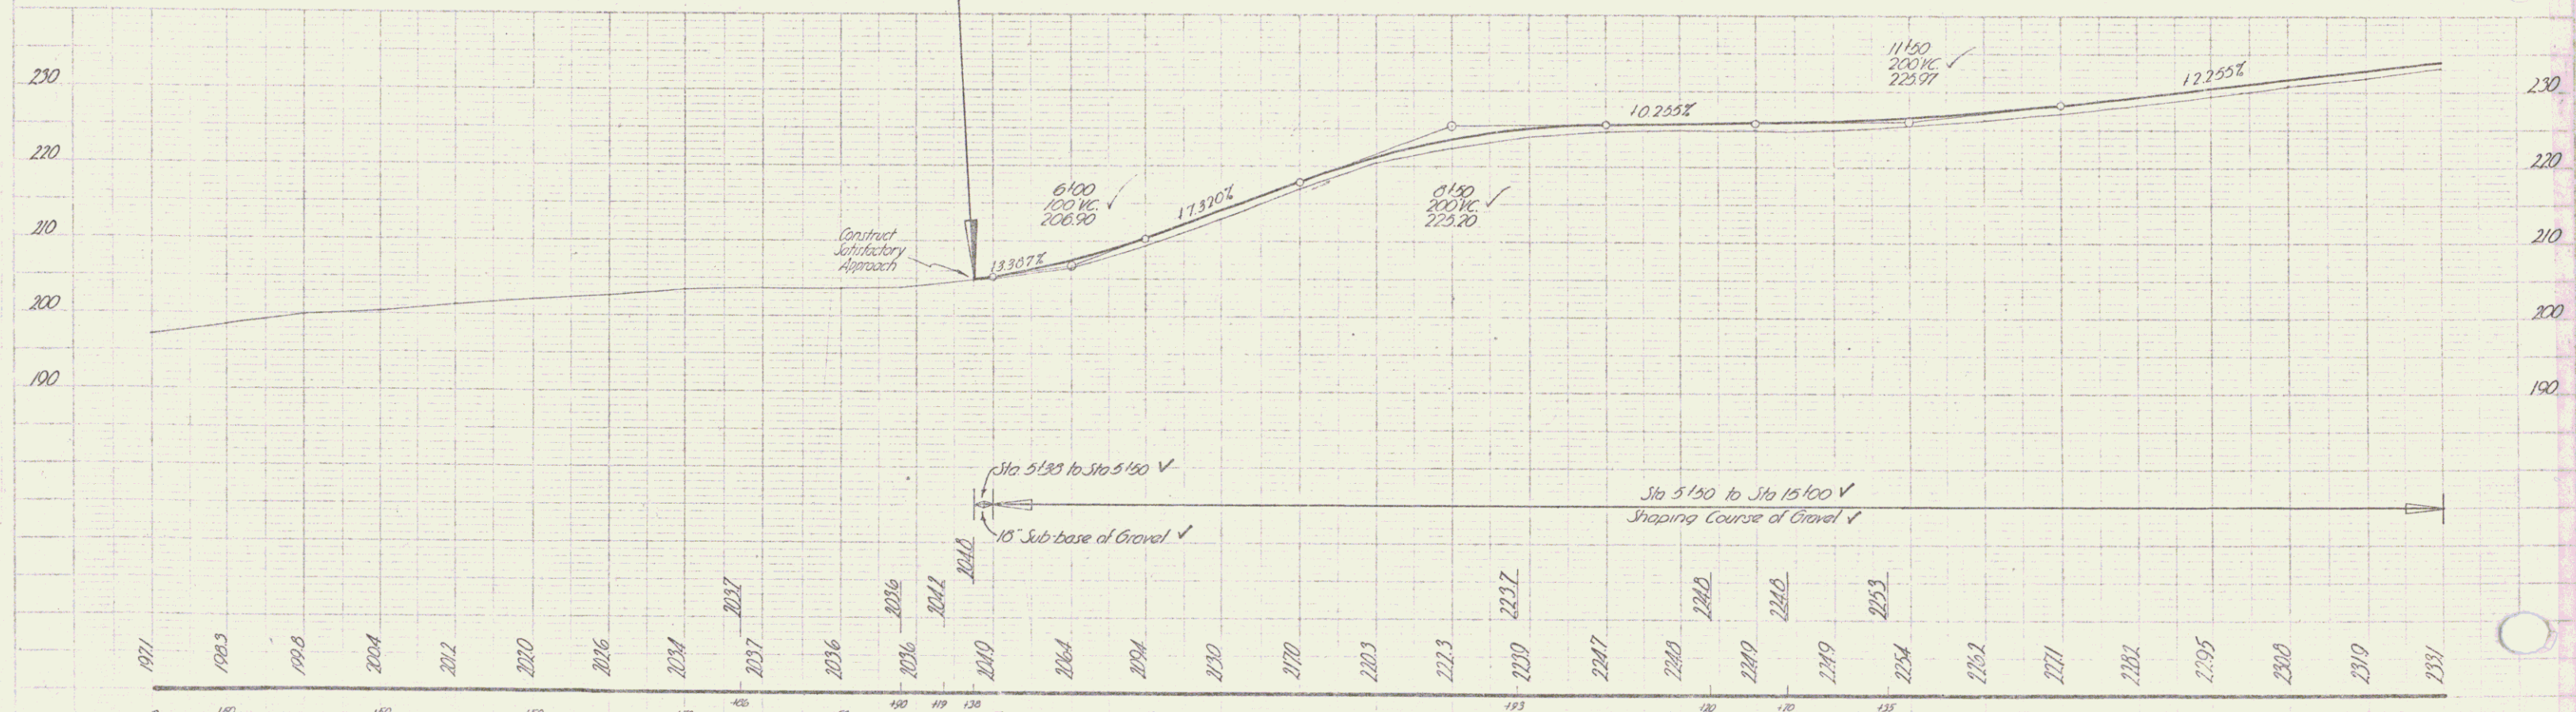

BM #1 Spike in root 24" Dina 23 ft. ft. sta. 11.57 Elev. 200.00  
D.M. #2 Spike in root 18" Maple 26 ft. ft. sta. 11.85 Elev. 224.44

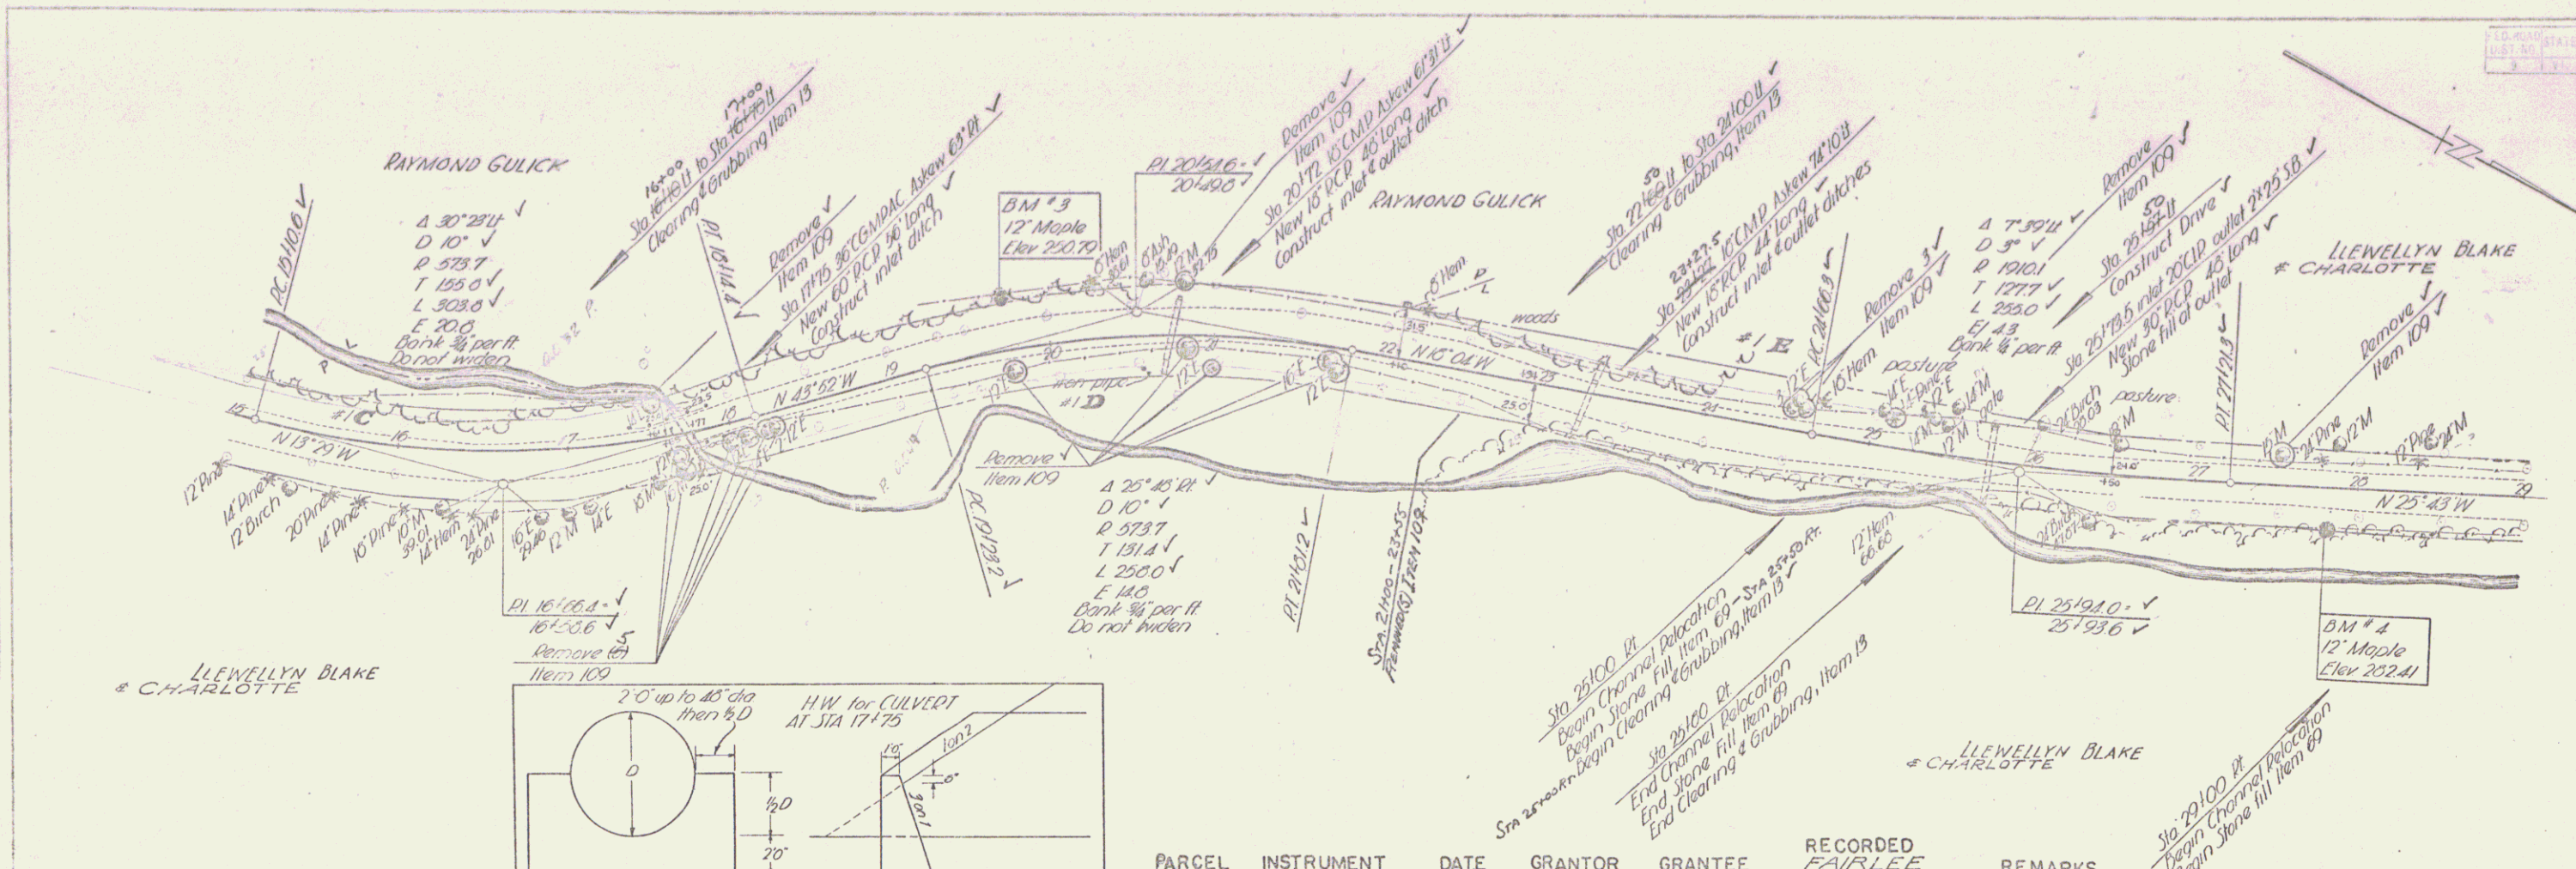

PARCEL	INSTRUMENT	DATE	GRANTOR	GRANTEE	RECORDED FAIRLEE BOOK PAGE DATE	REMARKS
(A) G. G. F. & S. (S. 17.75)	W. D. O. E.	6-24-48	LLEWELLYN & CHARLOTTE BLAKE	ST. OF VT.	20 314-316 6-30-48	

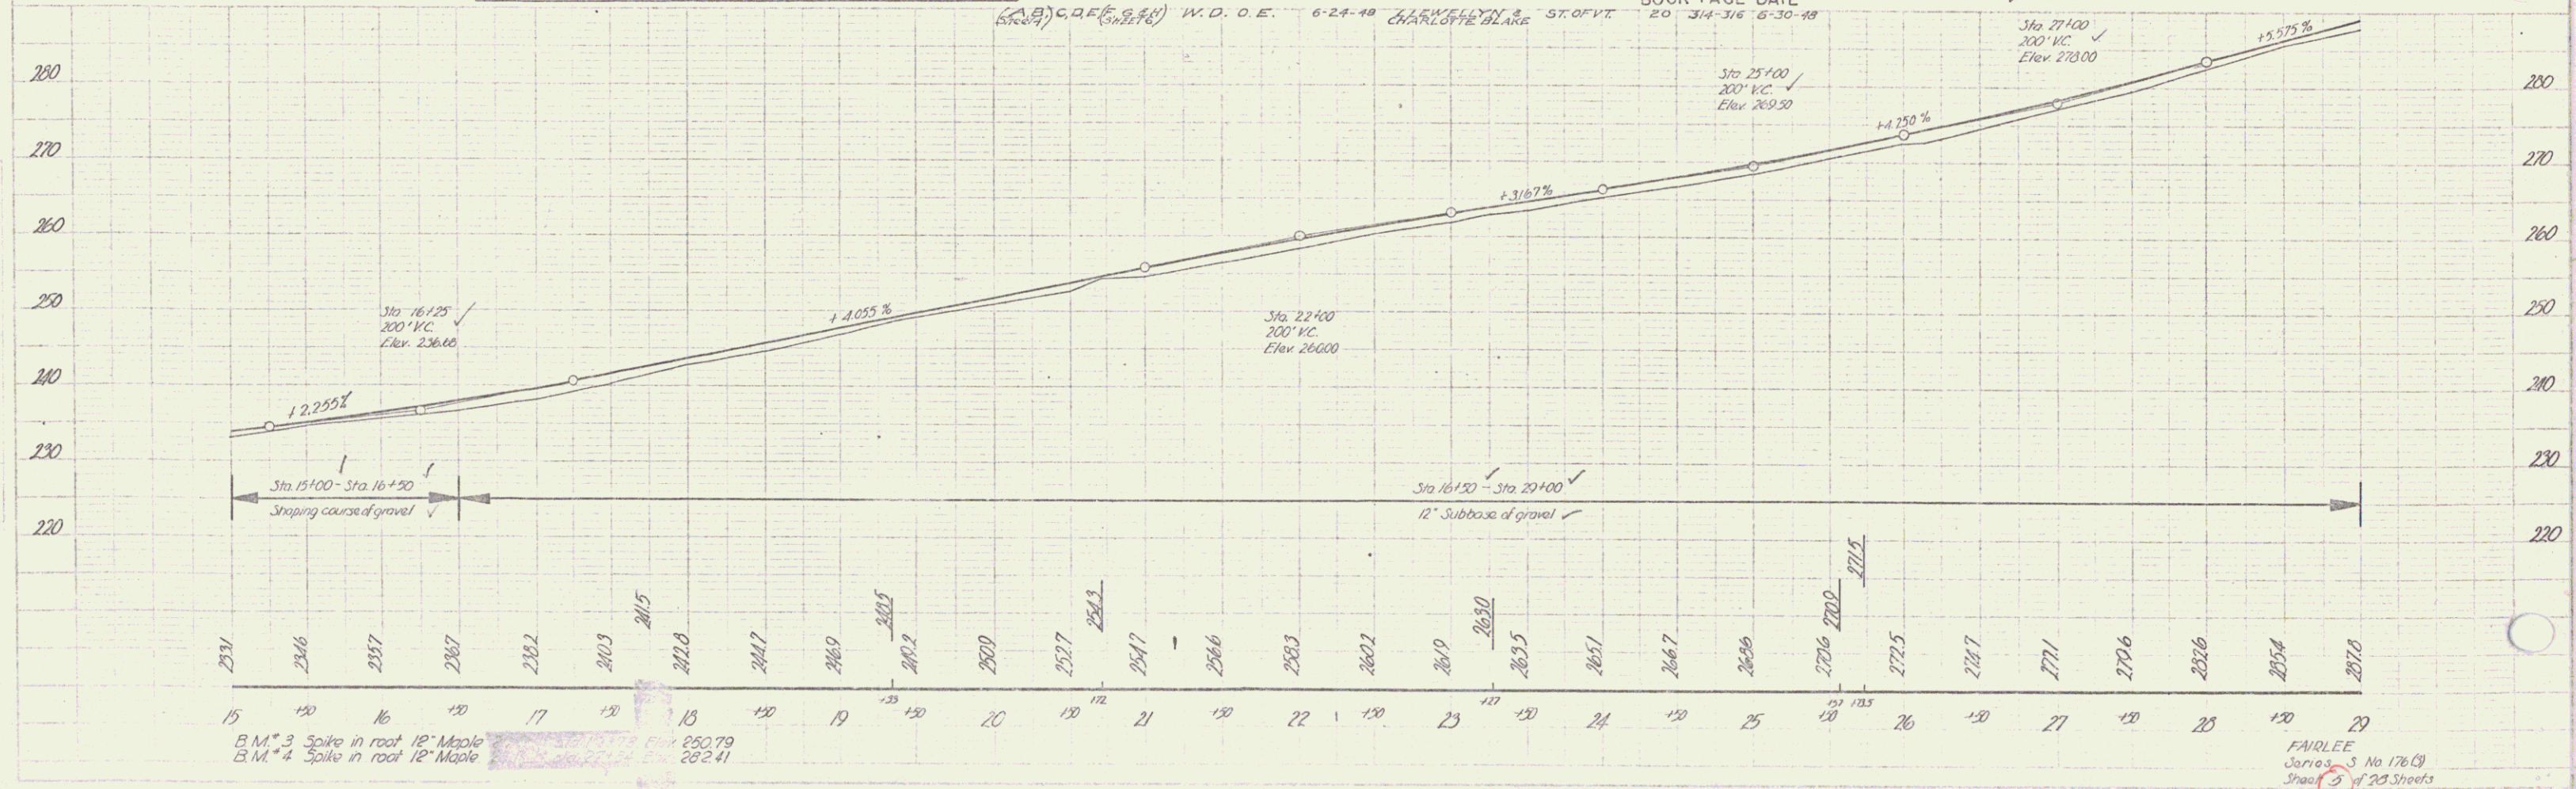


15-28  
 9-48  
 1-28  
 4-48  
 1-28  
 4-48

15-28  
 9-48  
 1-28  
 4-48


B.M. #3 Spike in root 12" Maple  
 B.M. #4 Spike in root 12" Maple

FAIRLEE  
 Series 3 No 176 (3)  
 Sheet 5 of 20 Sheets



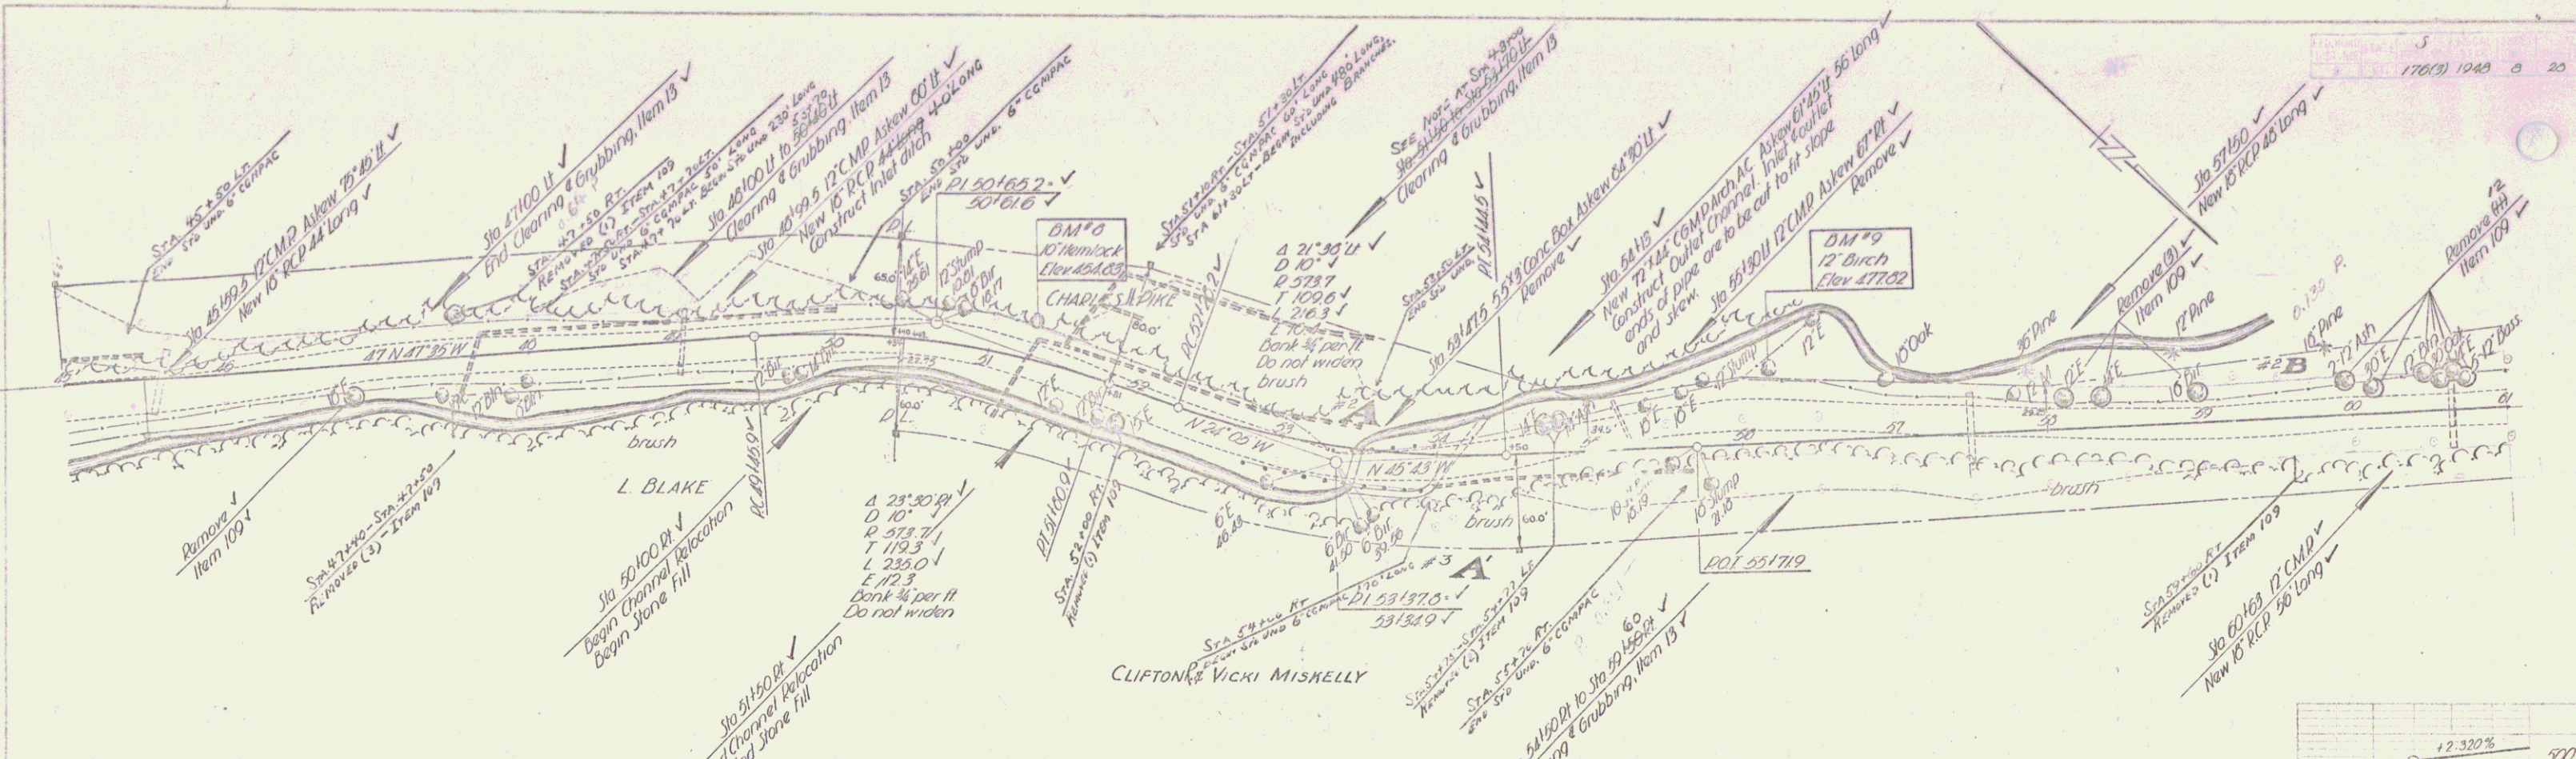

PARCEL	INSTRUMENT	DATE	GRANTOR	GRANTEE	RECORDED FILE NO.	BOOK	PAGE	DATE	REMARKS
# 2 A 48	W.D.O.E.	6-24-48	C.H. PIKE	ST. OF VT.	20	317-318	630-48		
# 3 A	W.D.O.E.	8-24-48	C.H. PIKE	ST. OF VT.	20	319-320	9-2-48		

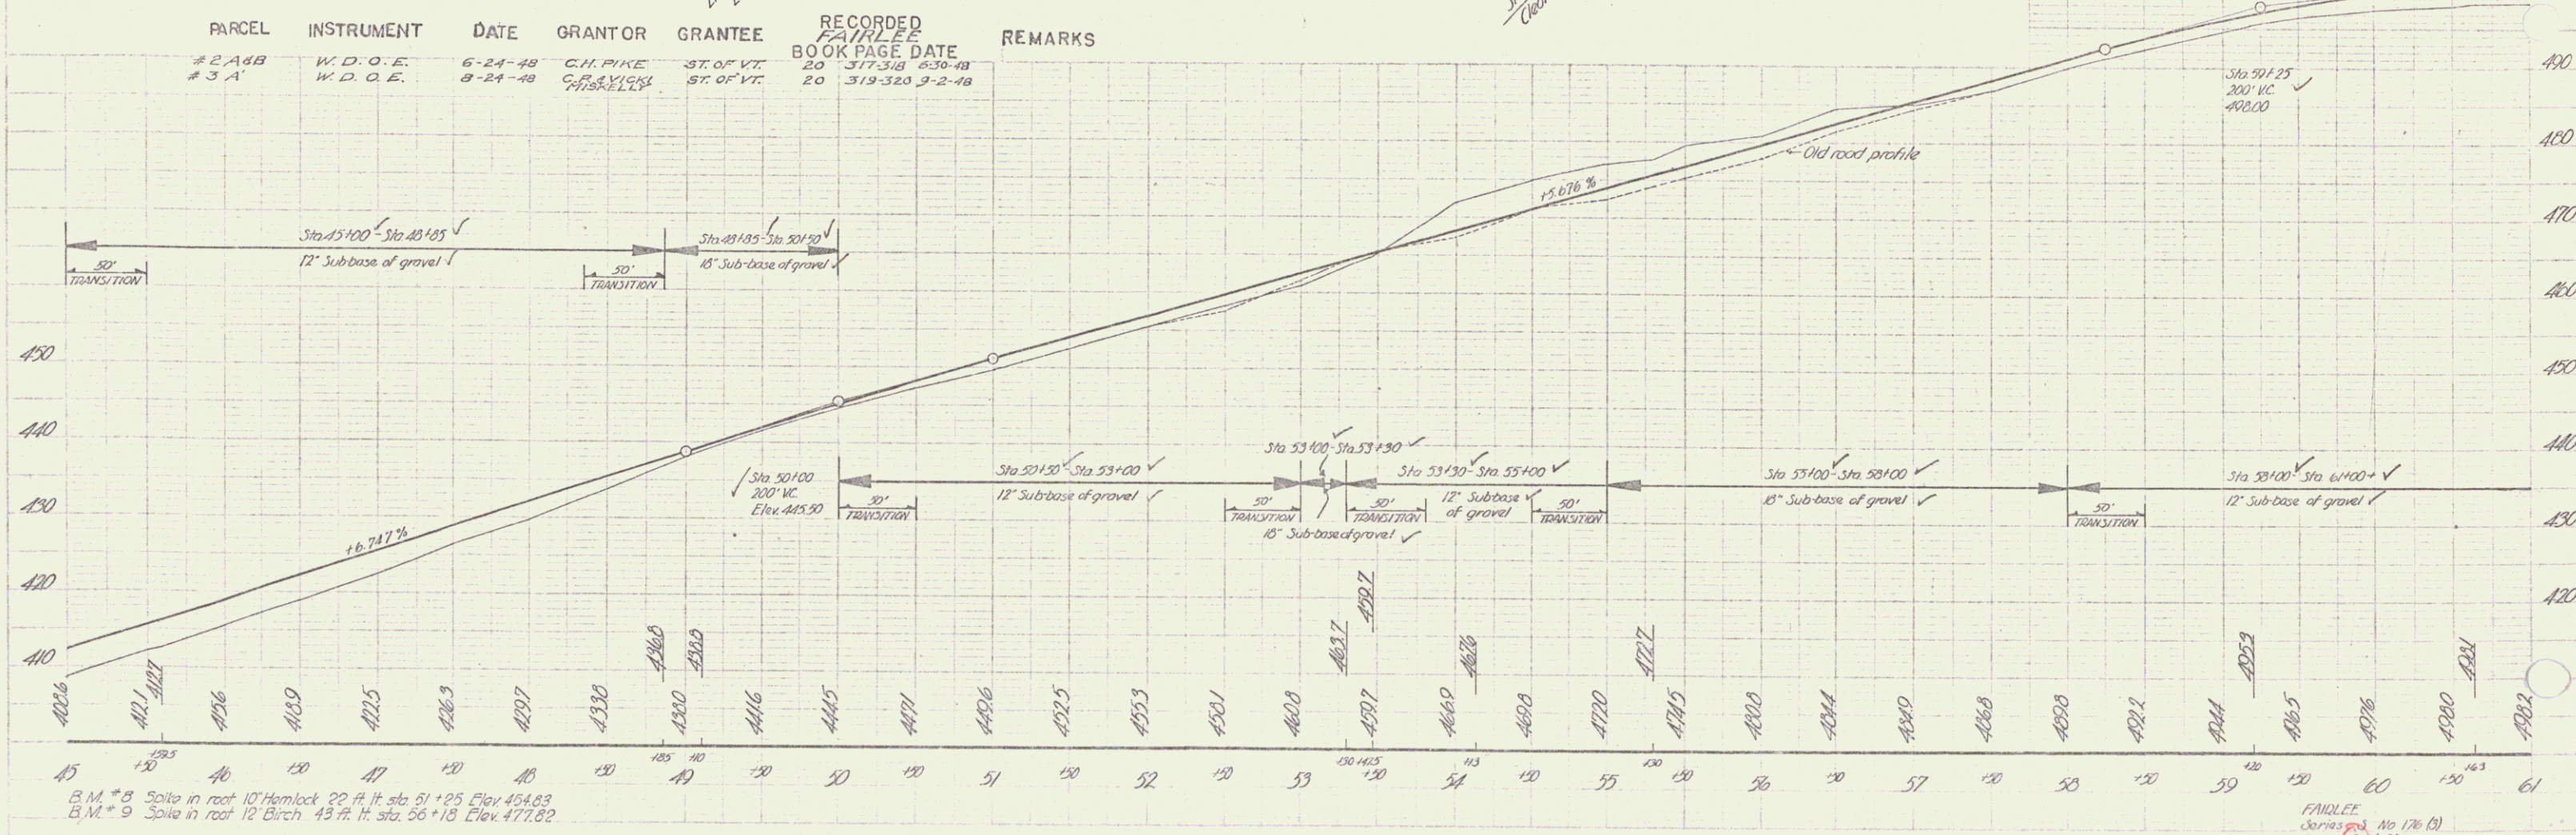

B.M. \* 8 Spots in root 10 Hemlock 22 ft. It sta 51 + 25 Elev 454.83  
 B.M. \* 9 Spots in root 12 Birch 43 ft. It. sta. 56 + 18 Elev 477.82

FAWLEE Series No 176 (B) Sheet (C) of 20 Sheets

