

2/23/2003
Added by J. Lewis

INDEX OF SHEETS


| SHEET NO. | TITLE PAGE |
|-----------|--|
| 1 | TITLE PAGE |
| 2 | TYPICAL CROSS SECTION OF IMPROVEMENT (SINGLE TACK COAT OF REFINED TAR AND BLADE MIX) |
| 3 | QUANTITY SHEET (ITEM) |
| 4 | QUANTITY SHEET (RAINAGE) |
| 5-9 | EARTHWORK SHEETS |
| 9 | STANDARD SHEET B-2 (BANKING TABLES) |
| 10 | STANDARD SHEET B-5 (TURNOUTS) |
| 11 | STANDARD SHEET B-6 (MUCK EXCAVATION) |
| 12 | STANDARD SHEET D-1 (PRECAST R.C.P. DROP INLET W/COVER) |
| 13 | STANDARD SHEET D-2 (C.R.M., HEADWALLS, AND UNDERDRAIN) |
| 14-14a | STANDARD SHEETS E-1 & E-9 (BARRICADES, SIGNS AND LIGHTS) |
| 15 | STANDARD SHEET G-2 (TWO CABLE GUARD RAIL) |
| 16 | STANDARD SHEET G-2 (DEAD END ANCHORAGE) |
| 17 | STANDARD SHEET G-4 (MARKER POSTS, GUIDE POSTS) |
| 18 | STANDARD SHEET J-1 (PROJECT MARKERS, BOUNDARY MARKERS) |
| 19-20 | DETAILS OF 12'-10" x 8'-4" x 76'-0" CORR. GALV. METAL PLATE PIPE ARCH # 279-34 |
| 21 | CHANNEL SECTIONS |
| 22-23 | PLAN AND PROFILE SHEETS |
| 24-25 | CROSS SECTION SHEETS |
| 26-27 | BANKING TRANSITIONS |

STATE OF VERMONT
DEPARTMENT OF HIGHWAYS
Proposed Improvement

**TOWNS OF WESTON AND MOUNT HOLLY
COUNTIES OF WINDSOR AND RUTLAND**

VERMONT ROUTE #8
WESTON-MOUNT HOLLY ROAD

BEGINNING AT A POINT APPROXIMATELY 0.6 MILES SOUTHERLY OF THE INTERSECTION OF VT. RTE. 100 AND VT. RTE. 8 AND EXTENDING NORTHERLY 3.134 MILES.
LENGTH OF PROJECT 16,546.6 FEET = 3.134 MILES

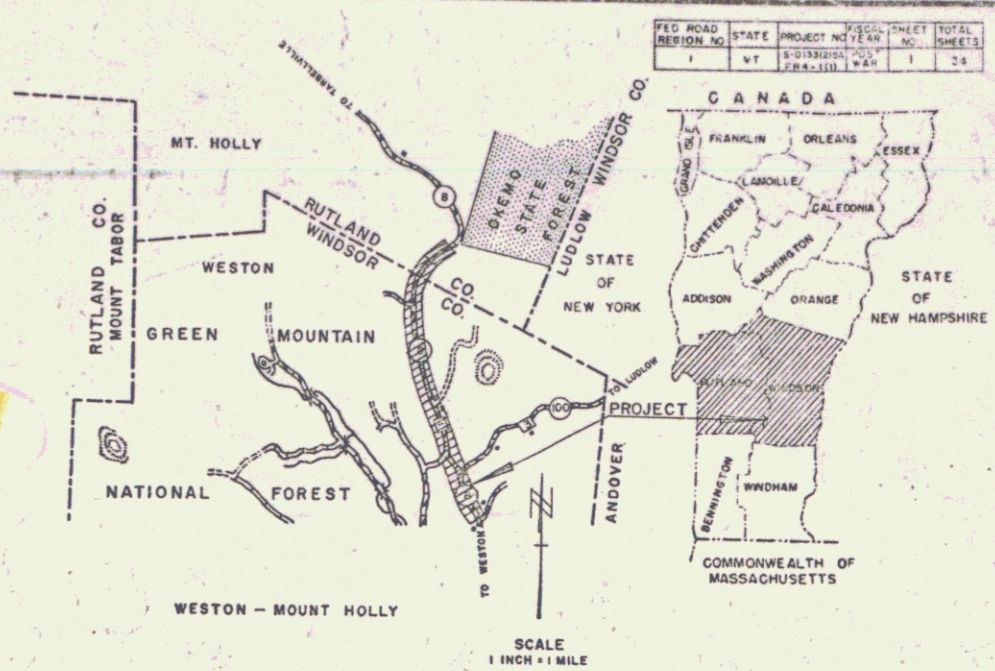

PROJECT NAME & NUMBER TYPE PAVEMENT AREA
WESTON-MT. HOLLY FH-4-1(1) SINGLE TACK COAT OF REFINED TAR AND BLADE MIX PEA STONE SEAL WITH CUTBACK ASPHALT. 37,159 S. Y.

RECORD PLANS MATERIALS


SUBBASE OF GRAVEL - JOHNSONS PIT - WESTON, VERMONT.
REFINED TAR - OLD COLONY TAR CO. - WORCESTER, MASSACHUSETTS.
CUTBACK ASPHALT - MOBIL OIL CO. - E. PROVIDENCE, RHODE ISLAND.
PEA STONE FOR SEAL - WILLIAM E. DAILEY - MANCHESTER, VERMONT.
REINFORCED CONCRETE PIPE - AMERICAN MARIETTA CO. - WINDSOR, VERMONT.
ASPH. CTD. CORR. GALV. METAL PIPE - NEW ENGLAND METAL CULV. CO. - WHITE RIVER JCT., VT.
CABLE GUARD RAIL, WOOD GUIDE & MARKER POSTS - S.T. GRISWOLD & CO. INC. - ESSEX JCT., VT.
CONTR. - CALEDONIA SAND & GRAVEL CO. INC. CONTRACT:

DATED - MARCH 9, 1961.
STARTED - MARCH 13, 1961.
COMPLETED - OCTOBER 20, 1961.
ACCEPTED - OCTOBER 20, 1961.

RESIDENT ENGINEER - PAUL G. HORTON.
INSPECTOR - A. J. COARSE
RECORD PLANS - PAUL G. HORTON.

| | | |
|------|-----|------|
| 1958 | ADT | 100 |
| 1980 | ADT | 150 |
| 1980 | DIV | 40 |
| | V | 50 |
| | D | 70 % |
| | T | 8 % |

Pin # 99R615

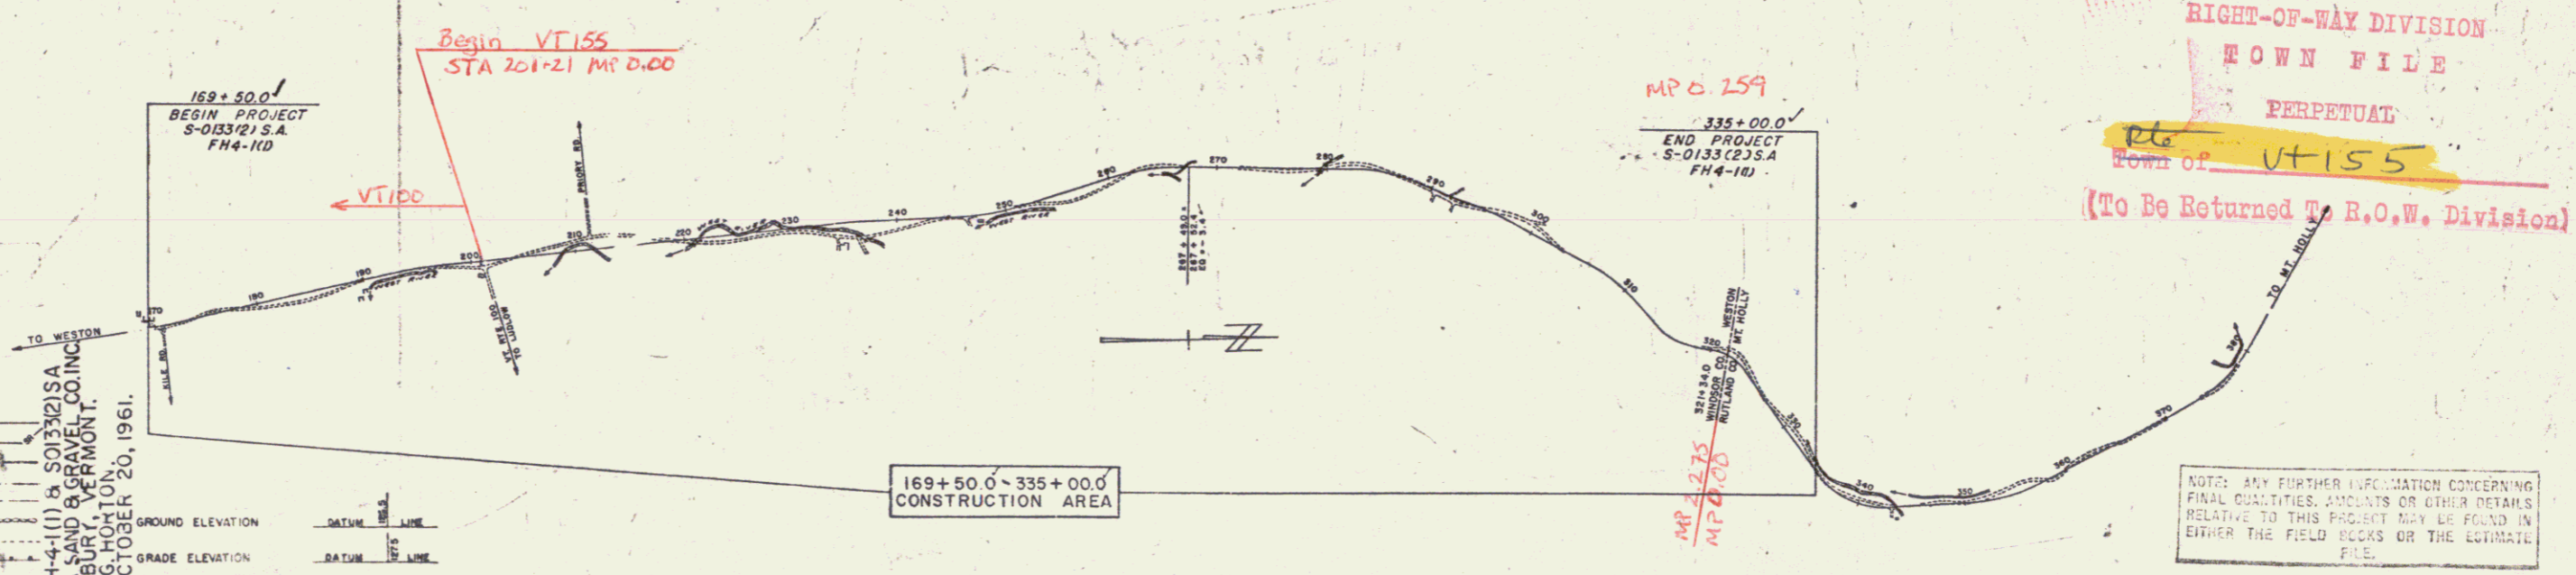

RIGHT-OF-WAY DIVISION
TOWN FILE
PERPETUAL
Town of VT 155
(To Be Returned To R.O.W. Division)

WESTON-MT. HOLLY
PROJECT FH-4-1(1) & S-0133(2) S.A.
SINGLE TACK COAT OF REFINED TAR AND BLADE MIX PEA STONE SEAL WITH CUTBACK ASPHALT.
CONTRACTOR - CALEDONIA SAND & GRAVEL CO. INC.
ST. JOHNSBURY, VERMONT
Location Beginning at a point approximately 0.6 miles southerly of the intersection of Vt. Rte. 100 and Vt. Rte. 8 and extending northerly 3.134 miles.

WESTON-MT. HOLLY FH-4-1(1) & S-0133(2) S.A.
CONTRACTOR - CALEDONIA SAND & GRAVEL CO. INC.
ST. JOHNSBURY, VERMONT
COMPLETED OCTOBER 20, 1961.

RECORD PLANS
PAUL G. HORTON

SCALES

| | |
|--------------------|-----------|
| TITLE | 1" = 800' |
| TYPICAL | 1" = 2' |
| PLAN | 1" = 50' |
| PROFILE HORIZONTAL | 1" = 10' |
| PROFILE VERTICAL | 1" = 10' |
| CROSS-SECTIONS | 1" = 10' |

THESE PLANS ARE SUBJECT TO SUCH REVISIONS AS MAY BE REQUIRED BY THE BUREAU OF PUBLIC ROADS OR THE COMMISSIONER OF HIGHWAYS.

CONSTRUCTION IS TO BE CARRIED ON IN ACCORDANCE WITH THE PLANS AND THE STANDARD SPECIFICATIONS FOR HIGHWAY AND BRIDGE CONSTRUCTION OF JANUARY 1956 SUBMITTED TO THE BUREAU OF PUBLIC ROADS AS APPROVED JULY 9, 1956 INCLUDING ALL SUBSEQUENT APPROVED REVISIONS AND SUCH REVISED SPECIFICATIONS AND SPECIAL PROVISIONS AS ARE SUBMITTED WITH THE PLANS.

DEPARTMENT OF COMMERCE
BUREAU OF PUBLIC ROADS

APPROVED _____ DATE _____
DIVISION ENGINEER

APPROVED _____ DATE _____
BRIDGE ENGINEER

APPROVED _____ DATE _____
DISTRICT ENGINEER

APPROVED _____ DATE _____
SUPERVISOR

APPROVED _____ DATE _____
SUPERVISOR

PROJECT: FMA NO. 0133(2) S.A. FH-4-1(1)
SHEET 1 OF 54 SHEETS

| | | | | | |
|---|--|--|--|---|---|
| APPROVED _____ SECONDARY ENGINEER DATE 11/29/60 | APPROVED _____ CONSTRUCTION ENGINEER DATE 11/29/60 | APPROVED _____ BRIDGE ENGINEER DATE 11/29/60 | APPROVED _____ DISTRICT ENGINEER DATE 10/27/60 | APPROVED _____ SUPERVISOR DATE 11/29/60 | APPROVED _____ SUPERVISOR DATE 11/29/60 |
|---|--|--|--|---|---|

4155