
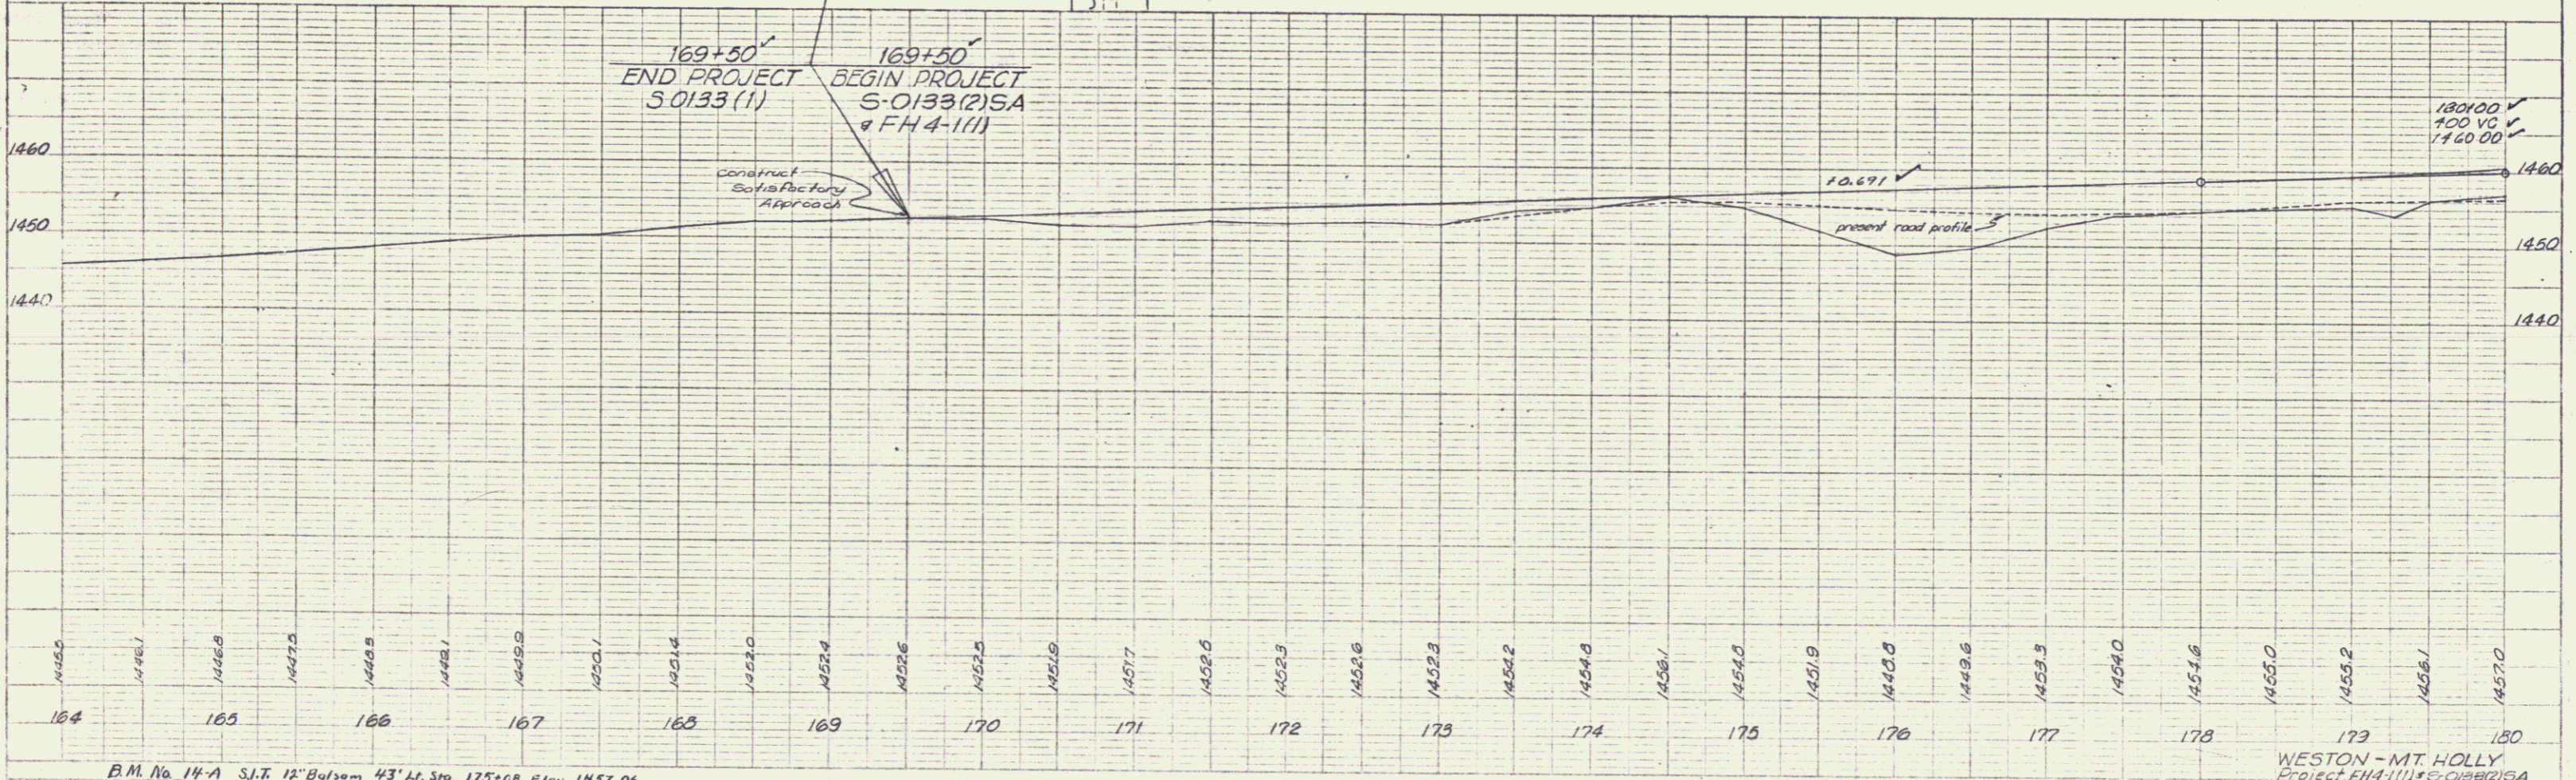


PLAN  
 DATE: 1/18/88  
 DRAWN BY: M. J. O'Connell  
 CHECKED BY: G. E. H.  
 NO. 4140

PROFILE  
 DATE: 1/18/88  
 DRAWN BY: M. J. O'Connell  
 CHECKED BY: G. E. H.  
 NO. 4140

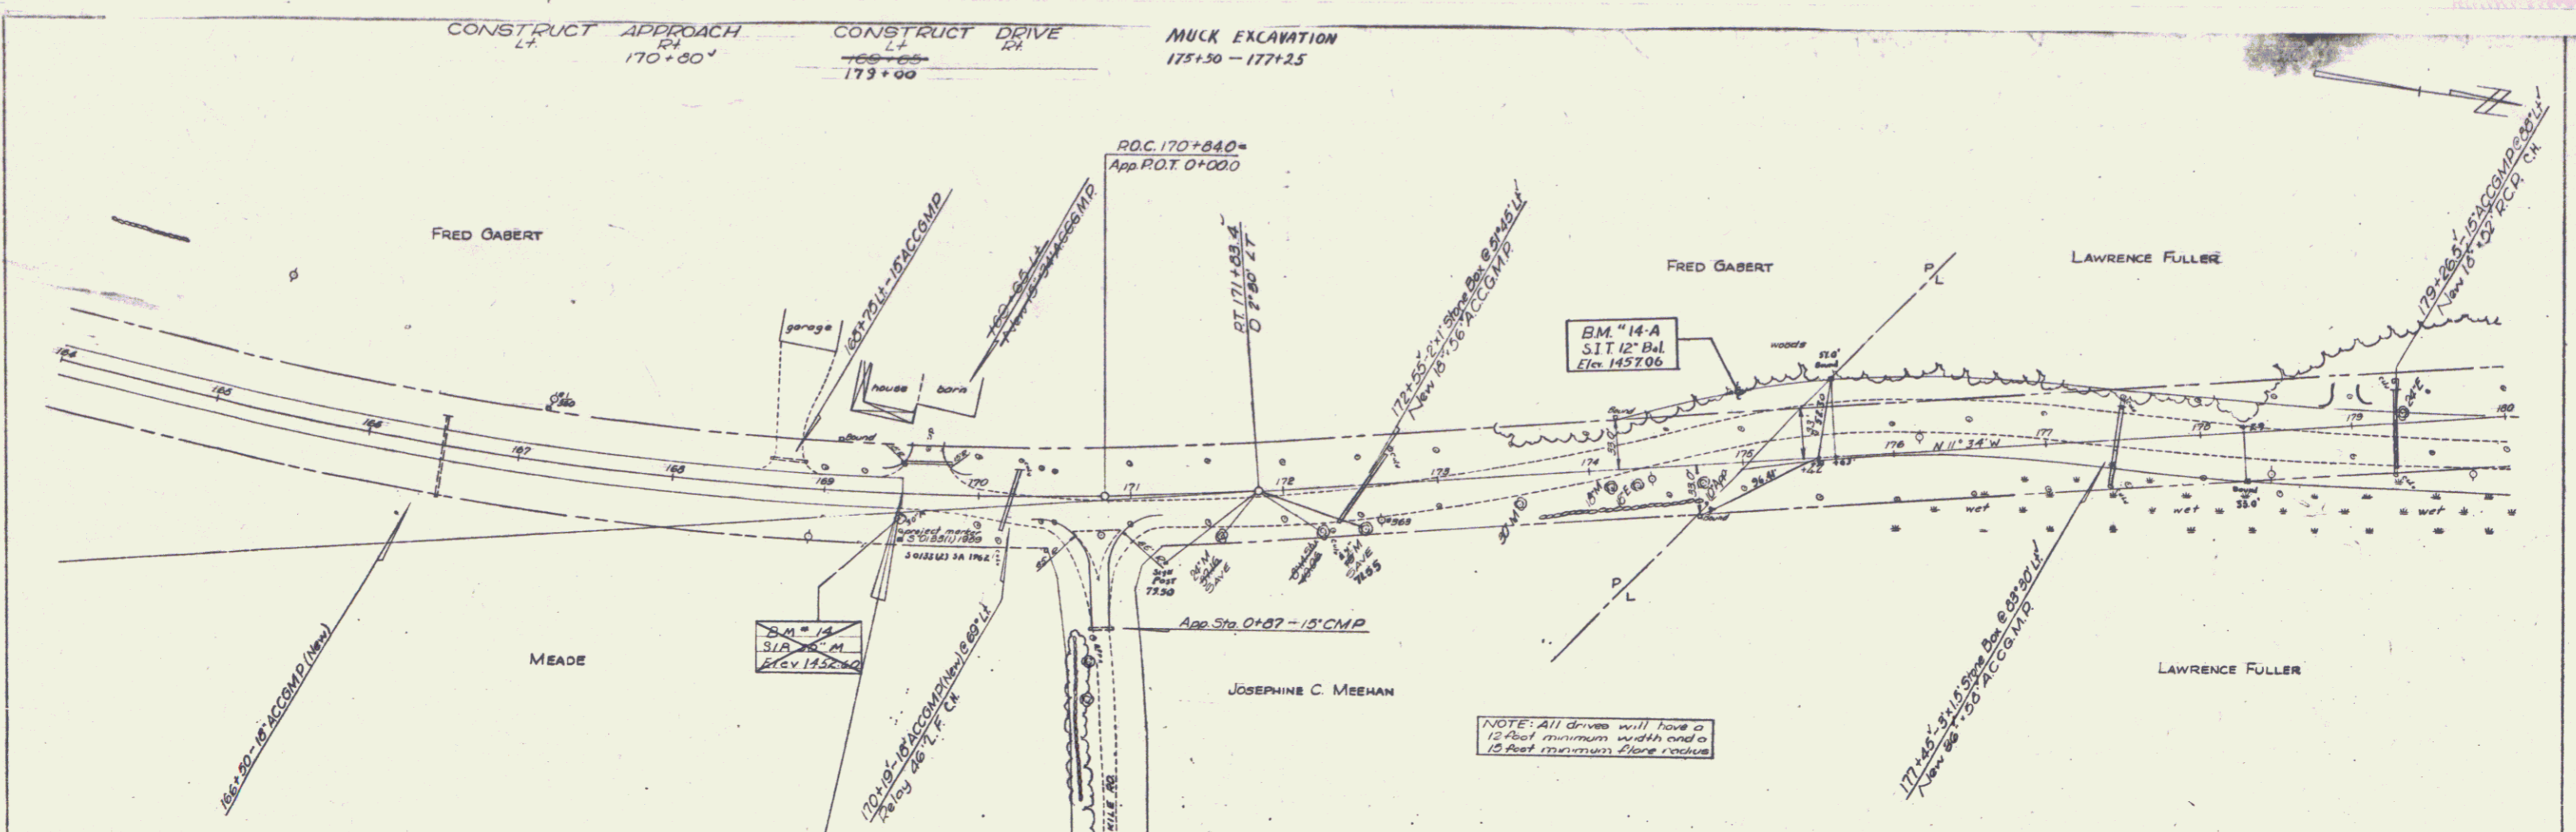

B.M. No. 14-A S.I.T. 12' Bolson 43' Lt. Sta. 175+00 Elev. 1457.06

WESTON - MT. HOLLY  
 Project FH 4-1(1) S-0133(2) SA  
 Sheet 22 of 51