
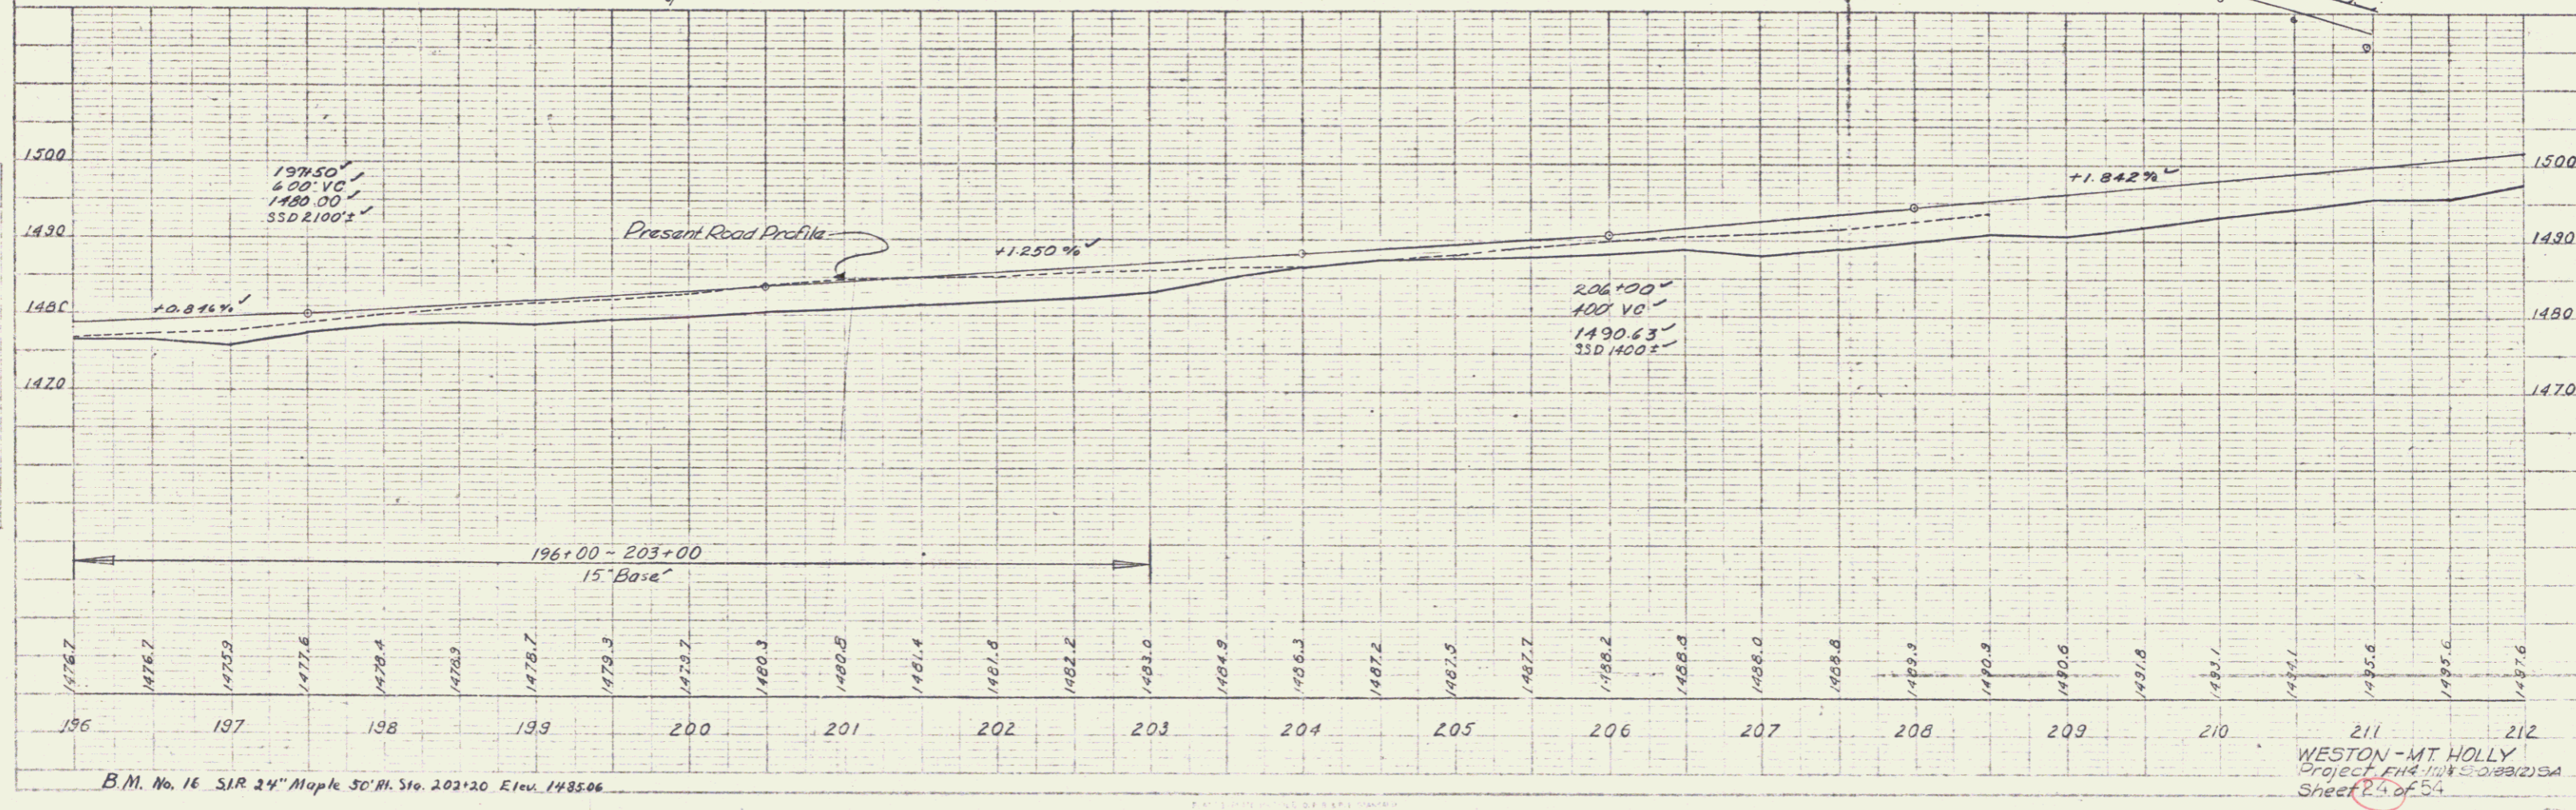


PLAN
 DATE: MAR 28
 DRAWN BY: MARTIN A. GAYMAN
 CHECKED BY: [Signature]
 SCALE: AS SHOWN

PROF.
 DATE: MAR 28
 DRAWN BY: MARTIN A. GAYMAN
 CHECKED BY: [Signature]
 SCALE: AS SHOWN

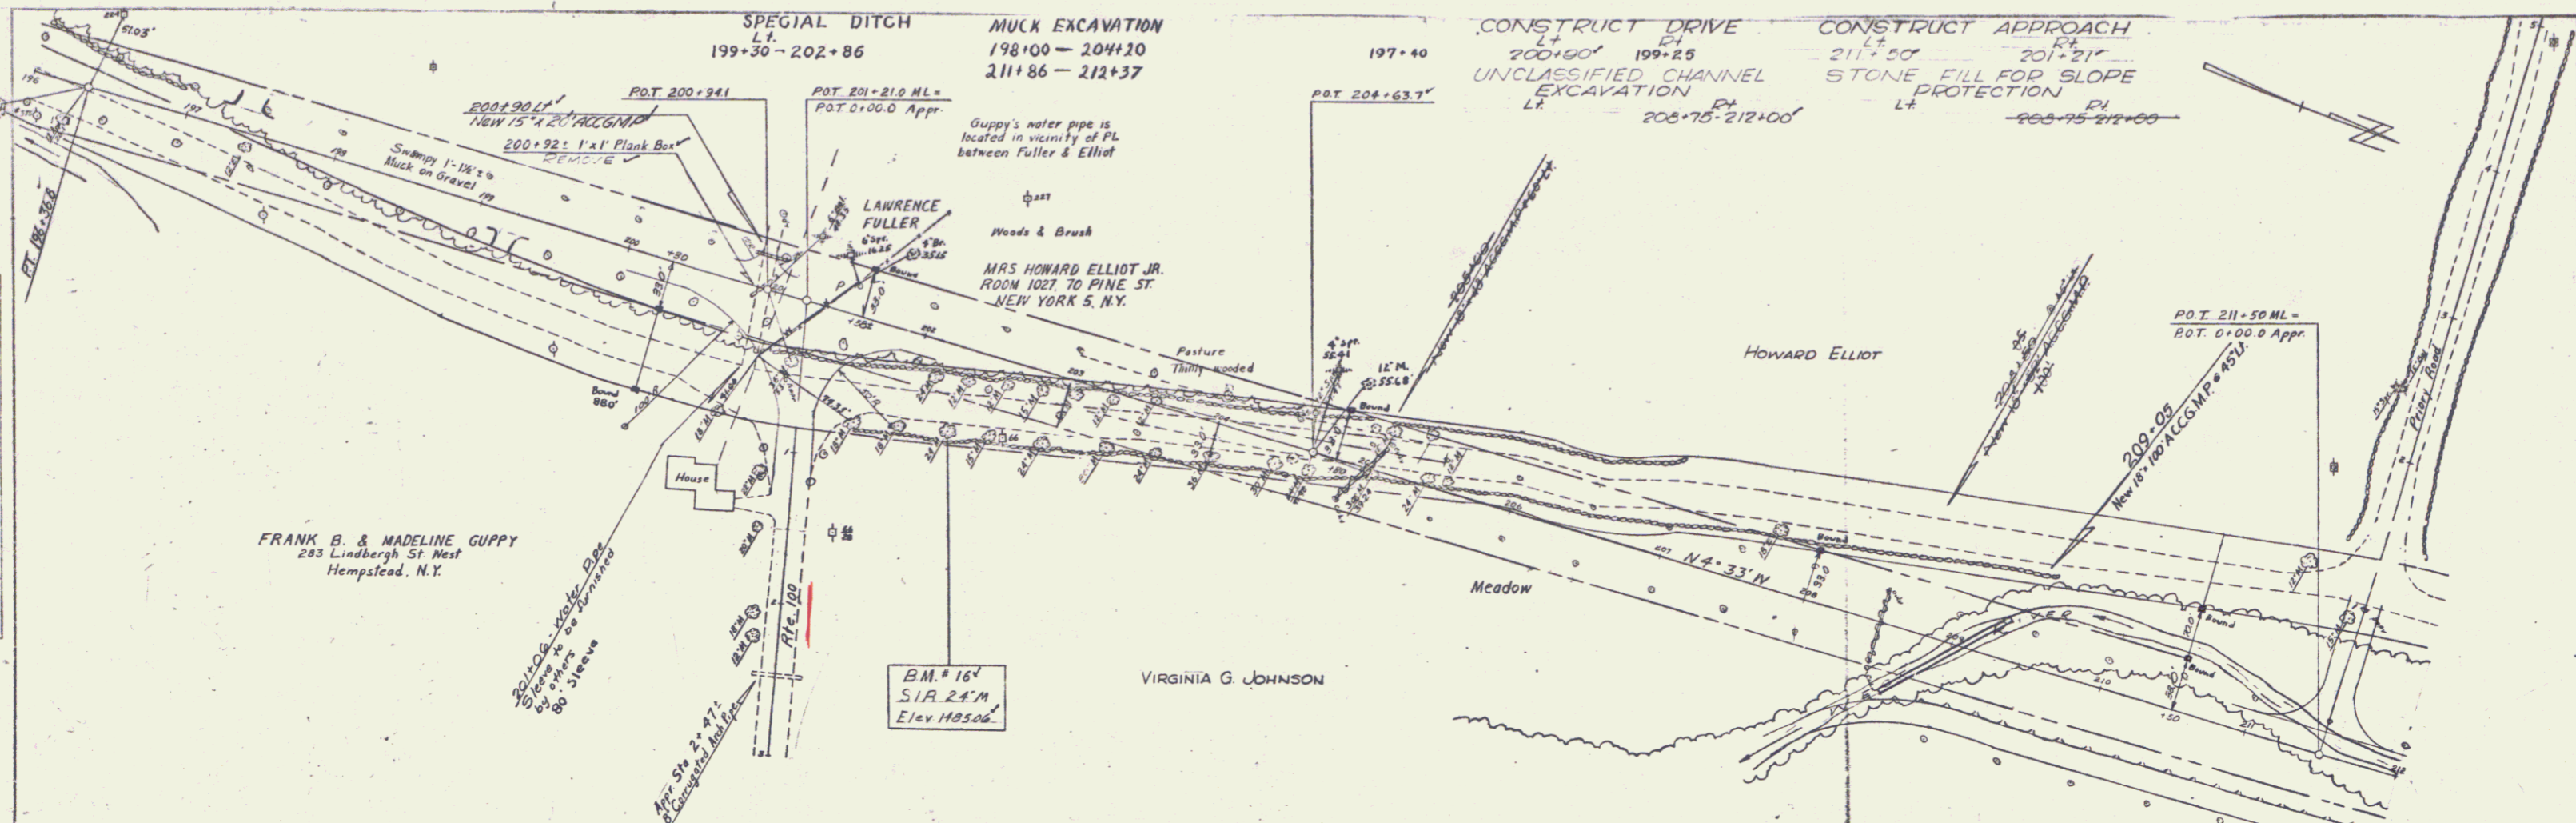

WESTON - MT HOLLY
 Project FH 11/1/50-023(2)5A
 Sheet 2 of 54