
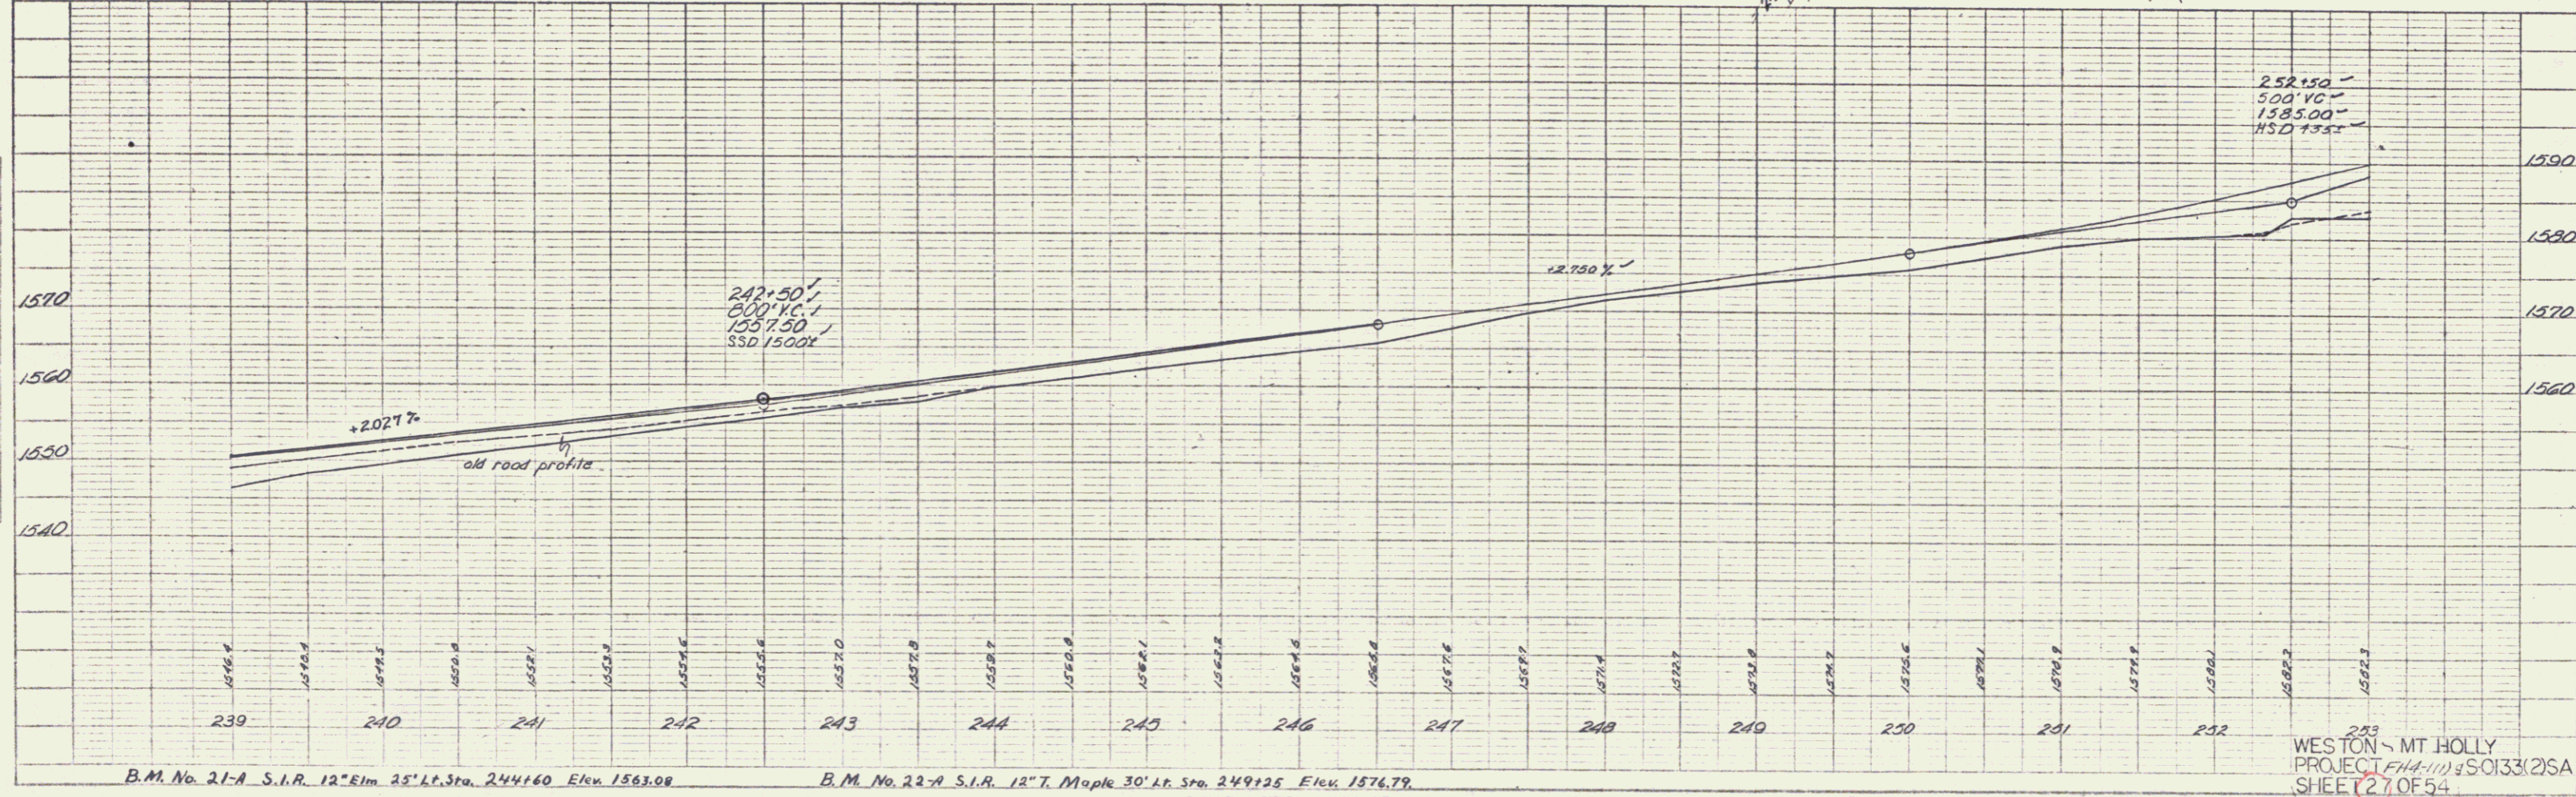


PLAN	DATE	BY
REVISED		
APPROVED		
DATE		
BY		
PROJECT		
LOCATION		
SCALE		
DATE		
BY		

PROFILE	DATE	BY
REVISED		
APPROVED		
DATE		
BY		
PROJECT		
LOCATION		
SCALE		
DATE		
BY		

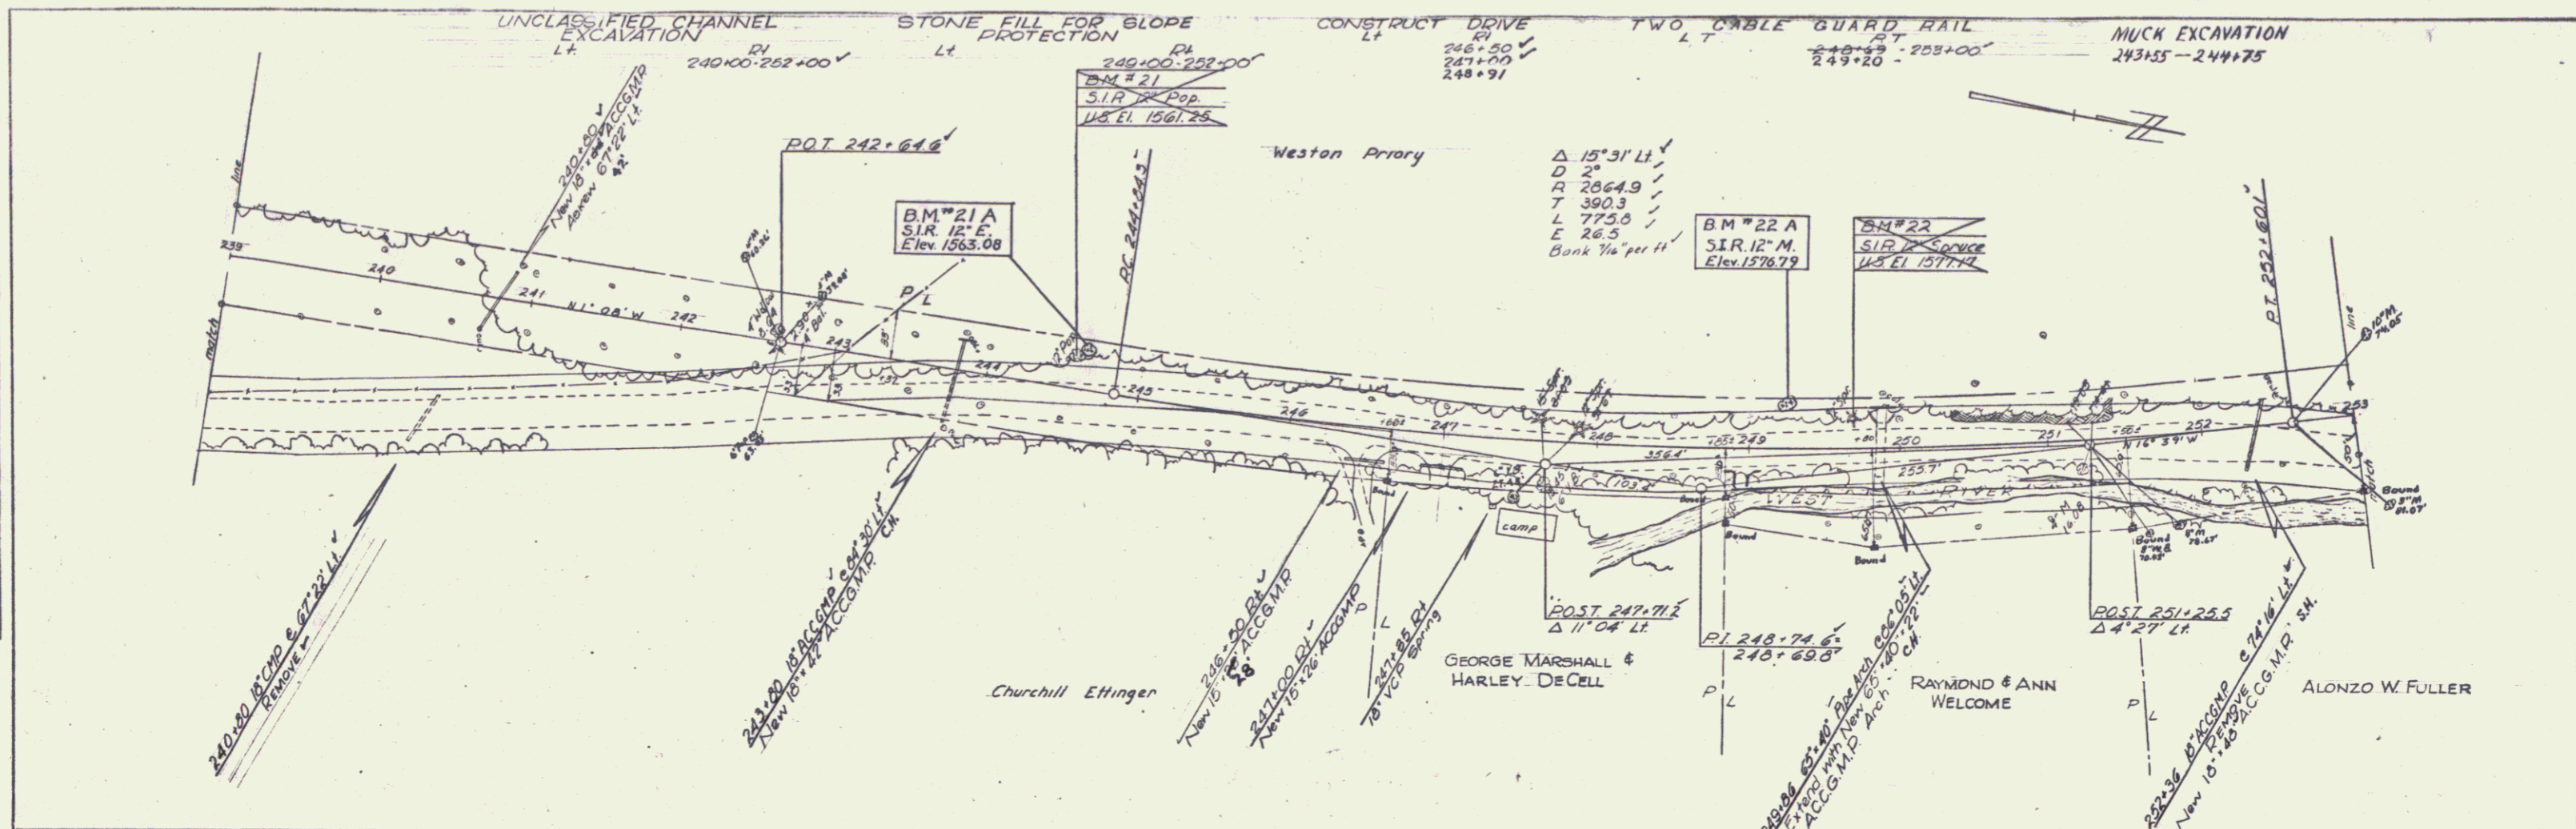

B.M. No. 21-A S.I.R. 12"E. Elm. 33' L.P. Sta. 244+60 Elev. 1563.08

B.M. No. 22-A S.I.R. 12"E. Maple 30' L.P. Sta. 249+25 Elev. 1576.79

WESTON - MT HOLLY
PROJECT F.H.A. (11) 50133(2)SA
SHEET 27 OF 54