
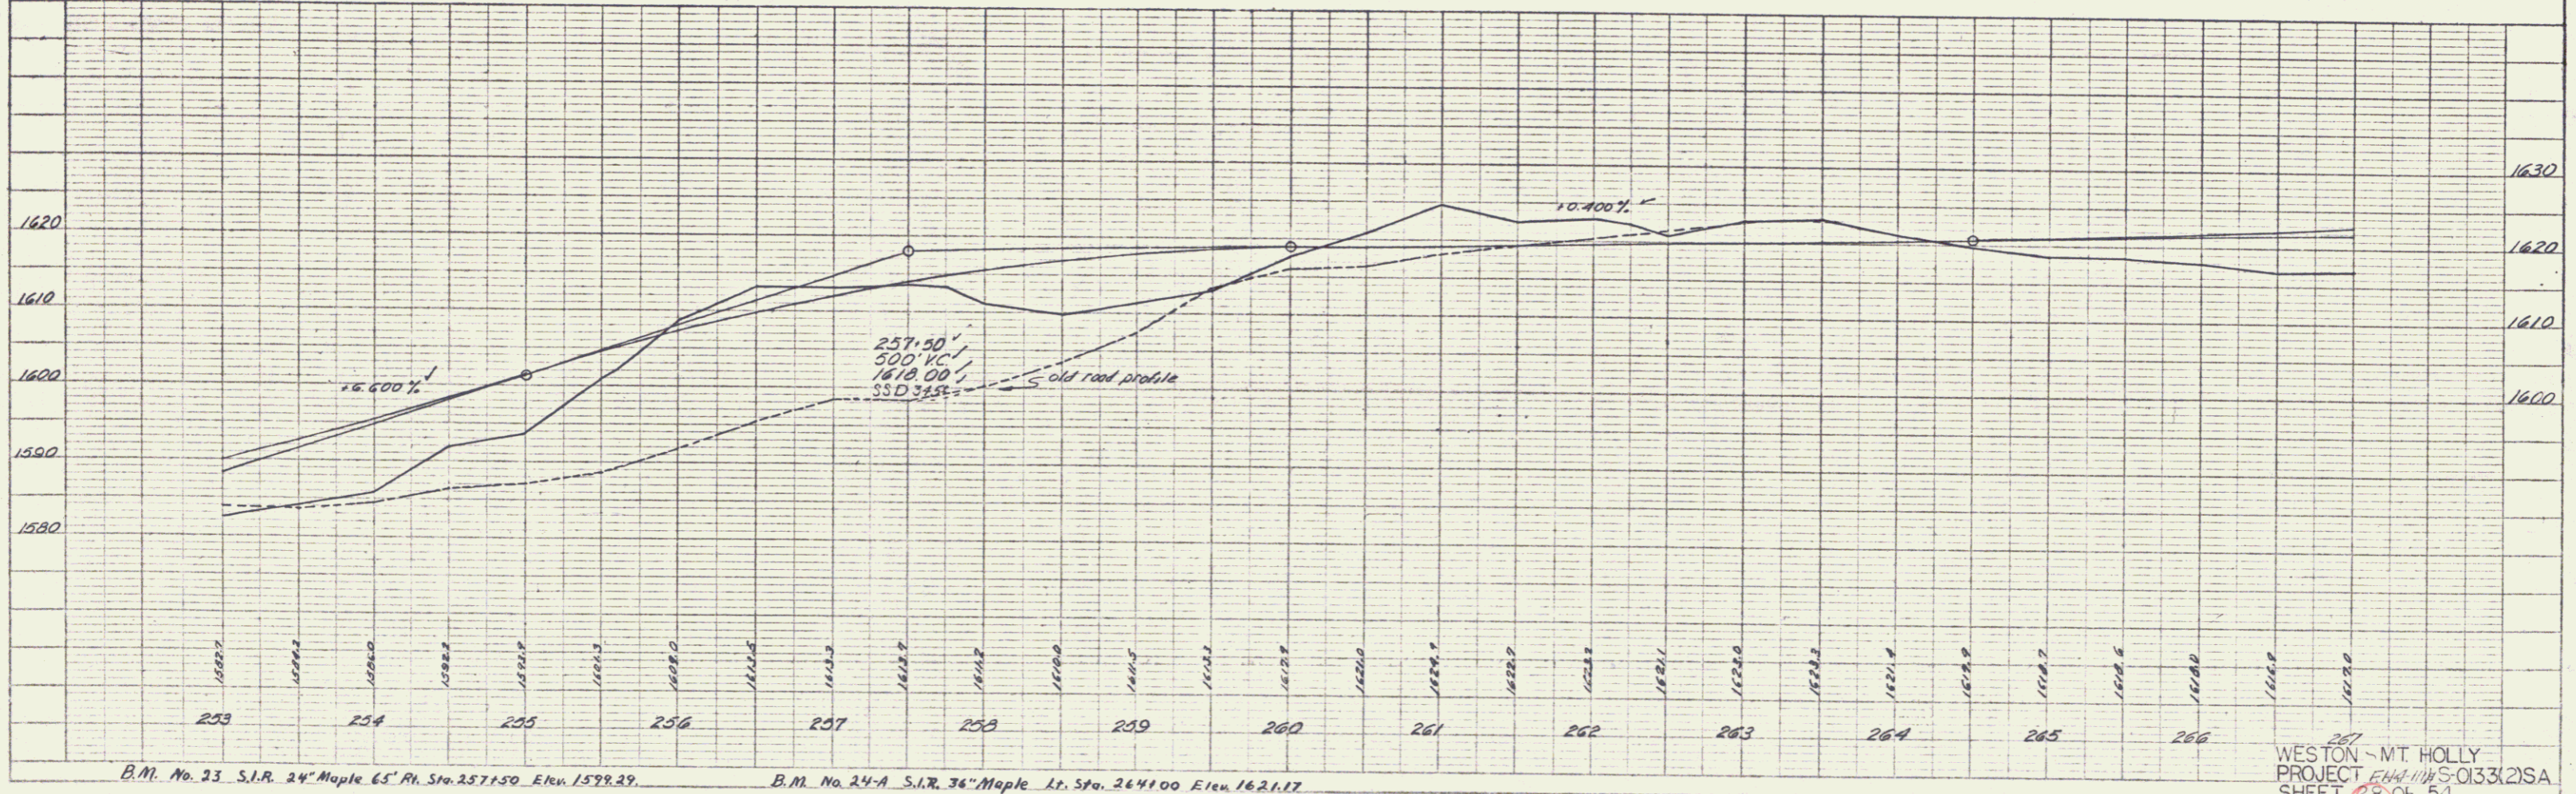


DATE	1/10
BY	J. J. [unclear]
CHECKED	[unclear]
SCALE	1" = 40'
PROJECT	WESTON - MT HOLLY
NO.	0133(2)SA
SHEET	28 OF 54

DATE	
BY	
CHECKED	
SCALE	
PROJECT	WESTON - MT HOLLY
NO.	0133(2)SA
SHEET	28 OF 54

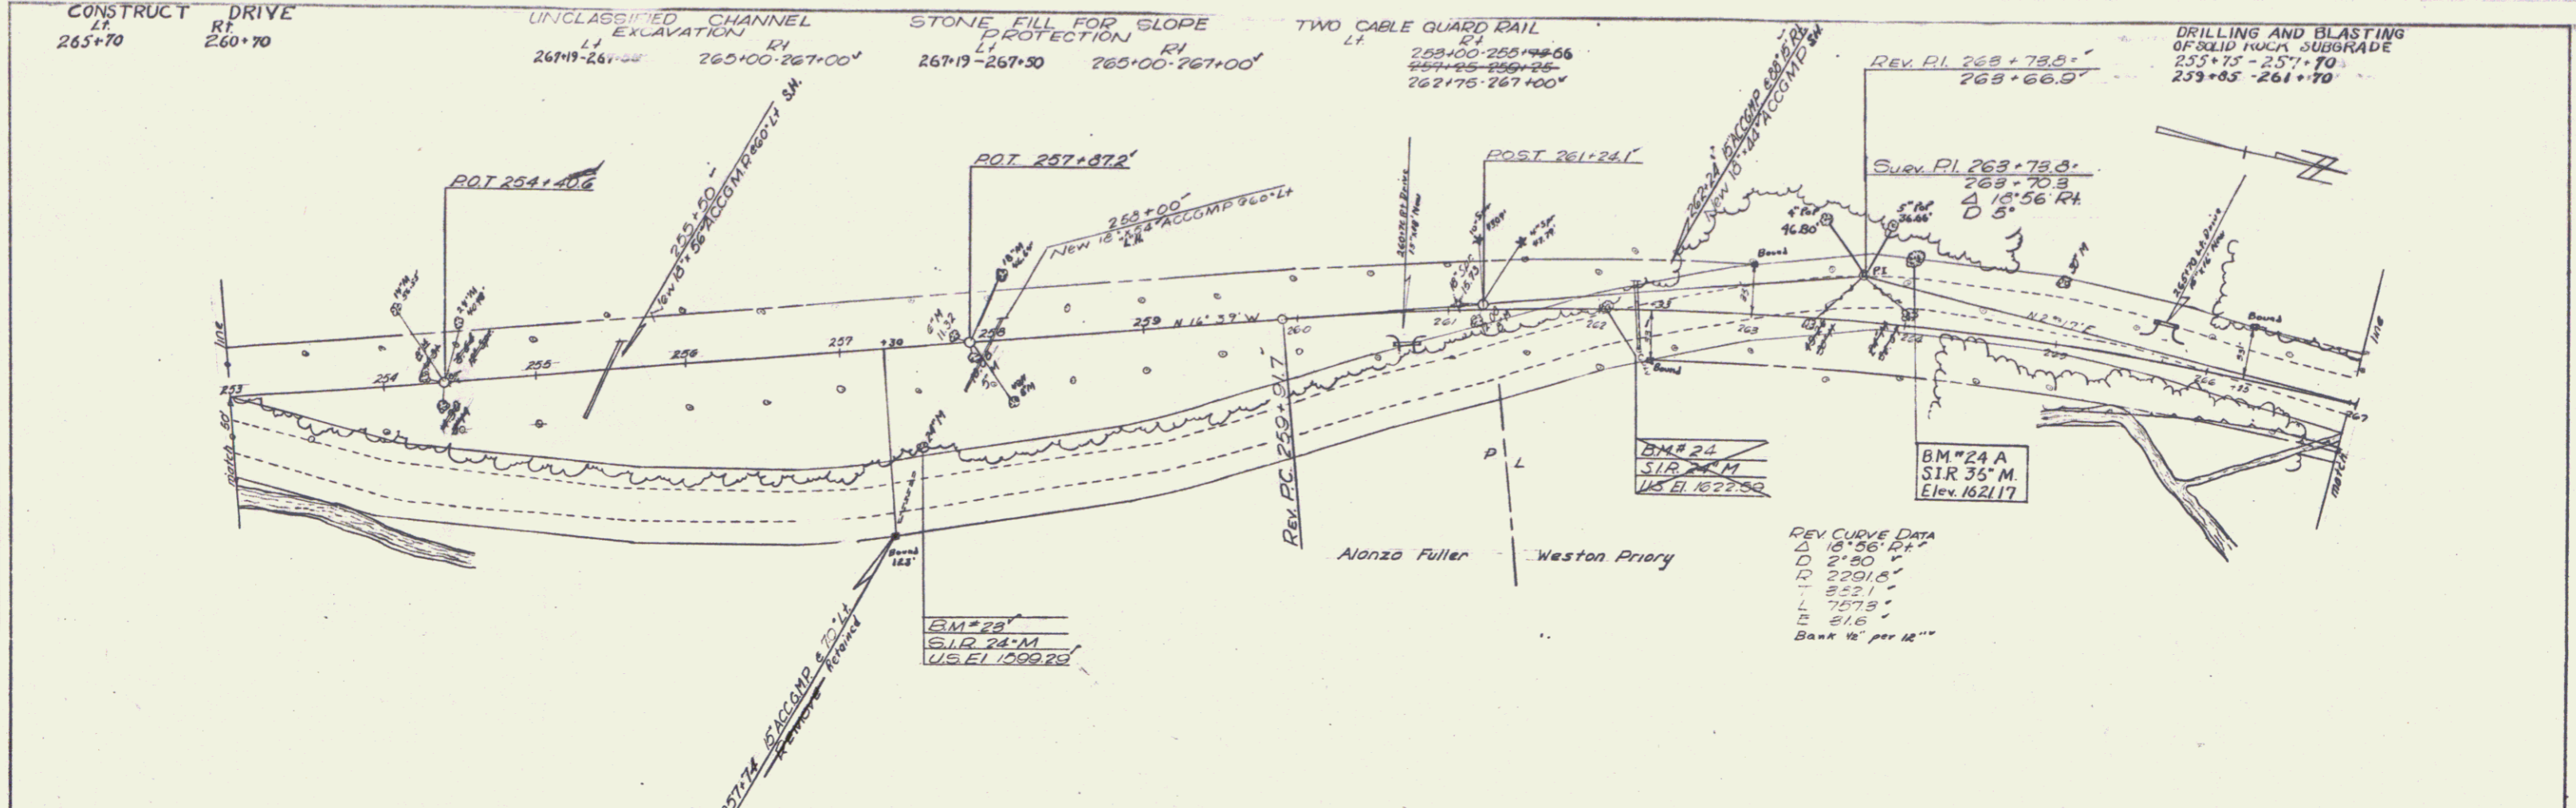

WESTON - MT HOLLY  
PROJECT ENR-1115-S-0133(2)SA  
SHEET 28 OF 54